

#44802


05-00-058-000-100  
05-00-058-B



LAUNDON • SIMON • CAHL & ASSOC., INC.  
CONSULTING ENGINEERS & SURVEYORS  
110 MIDDLE AVE., ELYRIA, O. 44035

SURVEY FOR:  
**DAVID M. BILLICK**

Orig. Lot 58	City of	Date APR. '94	Scale 1"=40'
Orig. Sec	Village of	Dwn. by R.G.S. Chkd. by	
Tract	County of LORAIN	Job No. 94-2547	F.B.232/65
Township of AMHERST	State of OHIO	Printed	

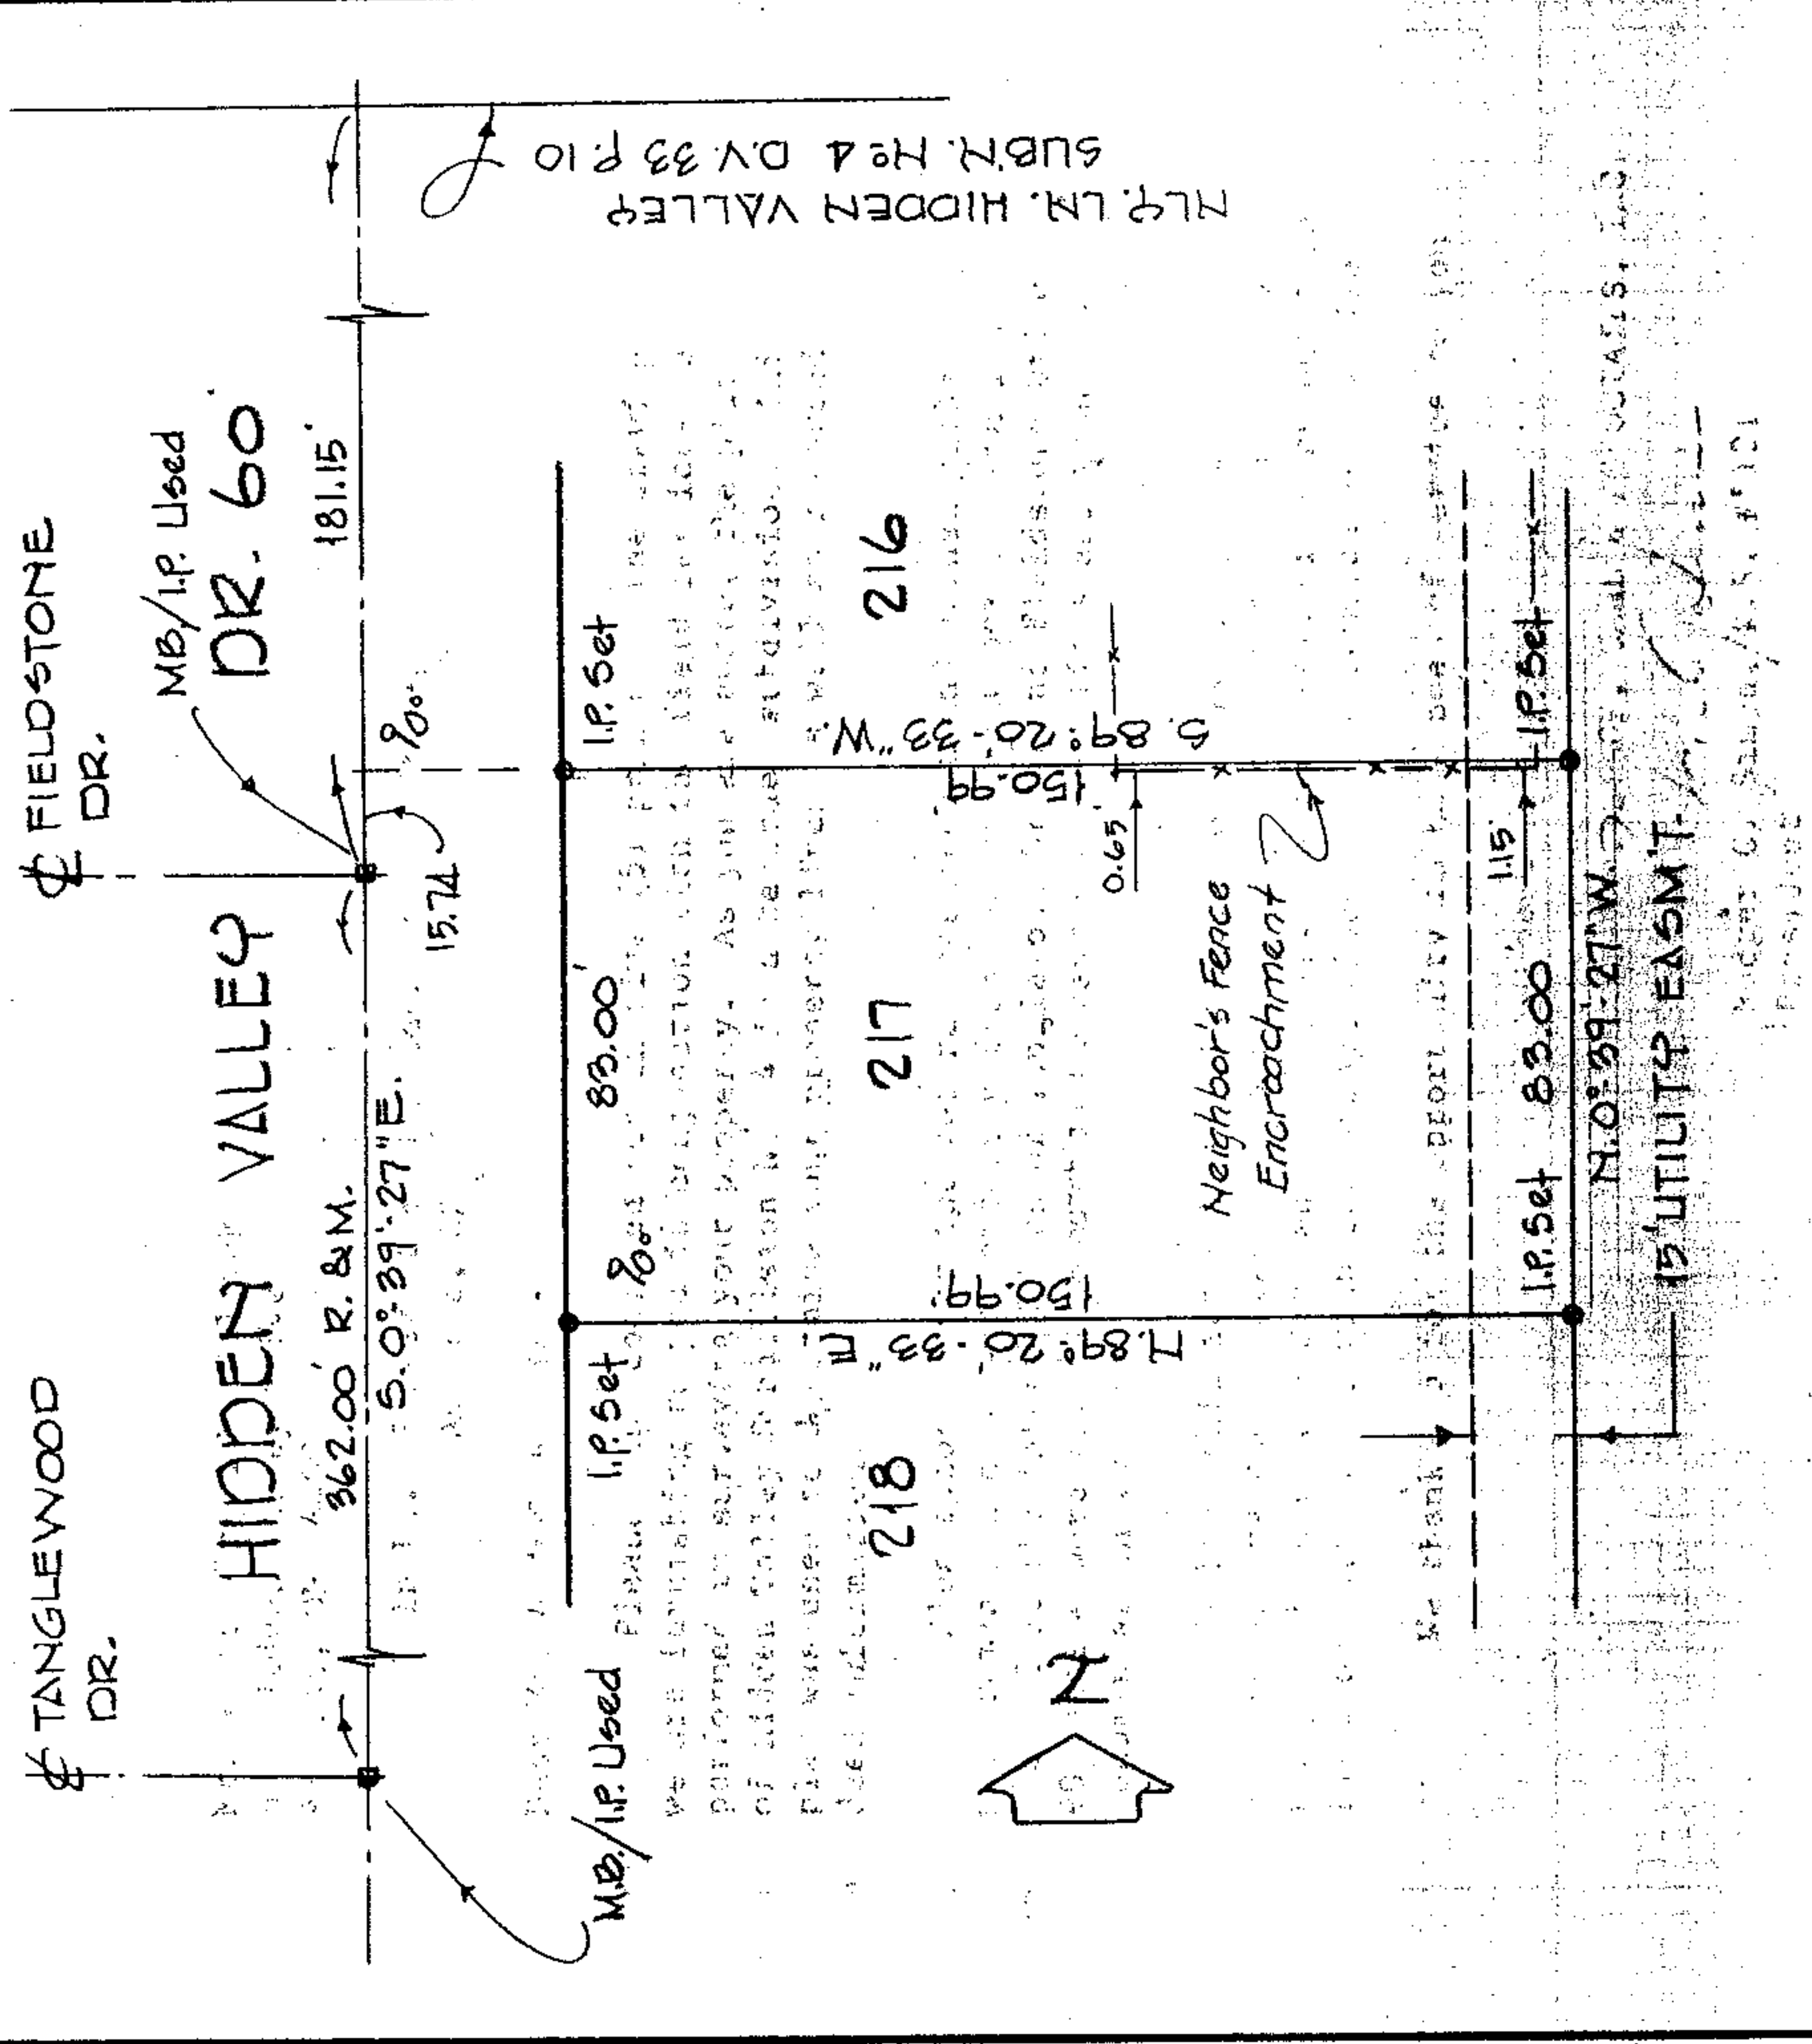

SURVEY OF S/L 217 HIDDEN VALLEY SUBN. NO. 4  
PLAT VOL. 33 P. 10