

44812

03-00-085-104-052
03-00-035 053



LAUNDON • SIMON • CAHL & ASSOC., INC.
CONSULTING ENGINEERS & SURVEYORS
110 MIDDLE AVE. ELYRIA, O. 44035


SURVEY FOR:

WILLIAM GRESKO HOMES

Orig. Lot 35	City of SHEFFIELD LAKE	Date 7 / 1993 Scale 1"=50'
Orig. Sec	Village of	Dwn. by R.G.S. Chkd. by R.C.
Tract	County of LORAIN	Job No. 93-2453 F.B. -
Township of SHEFFIELD	State of OHIO	Printed

I.P. Fd. @ P.I. Used for €

SURVEY OF S/L's 82 & 83 IN
SHORE SUB'N. and BUCKEYE COUNTRY
CLUB P.V. 10/30-32

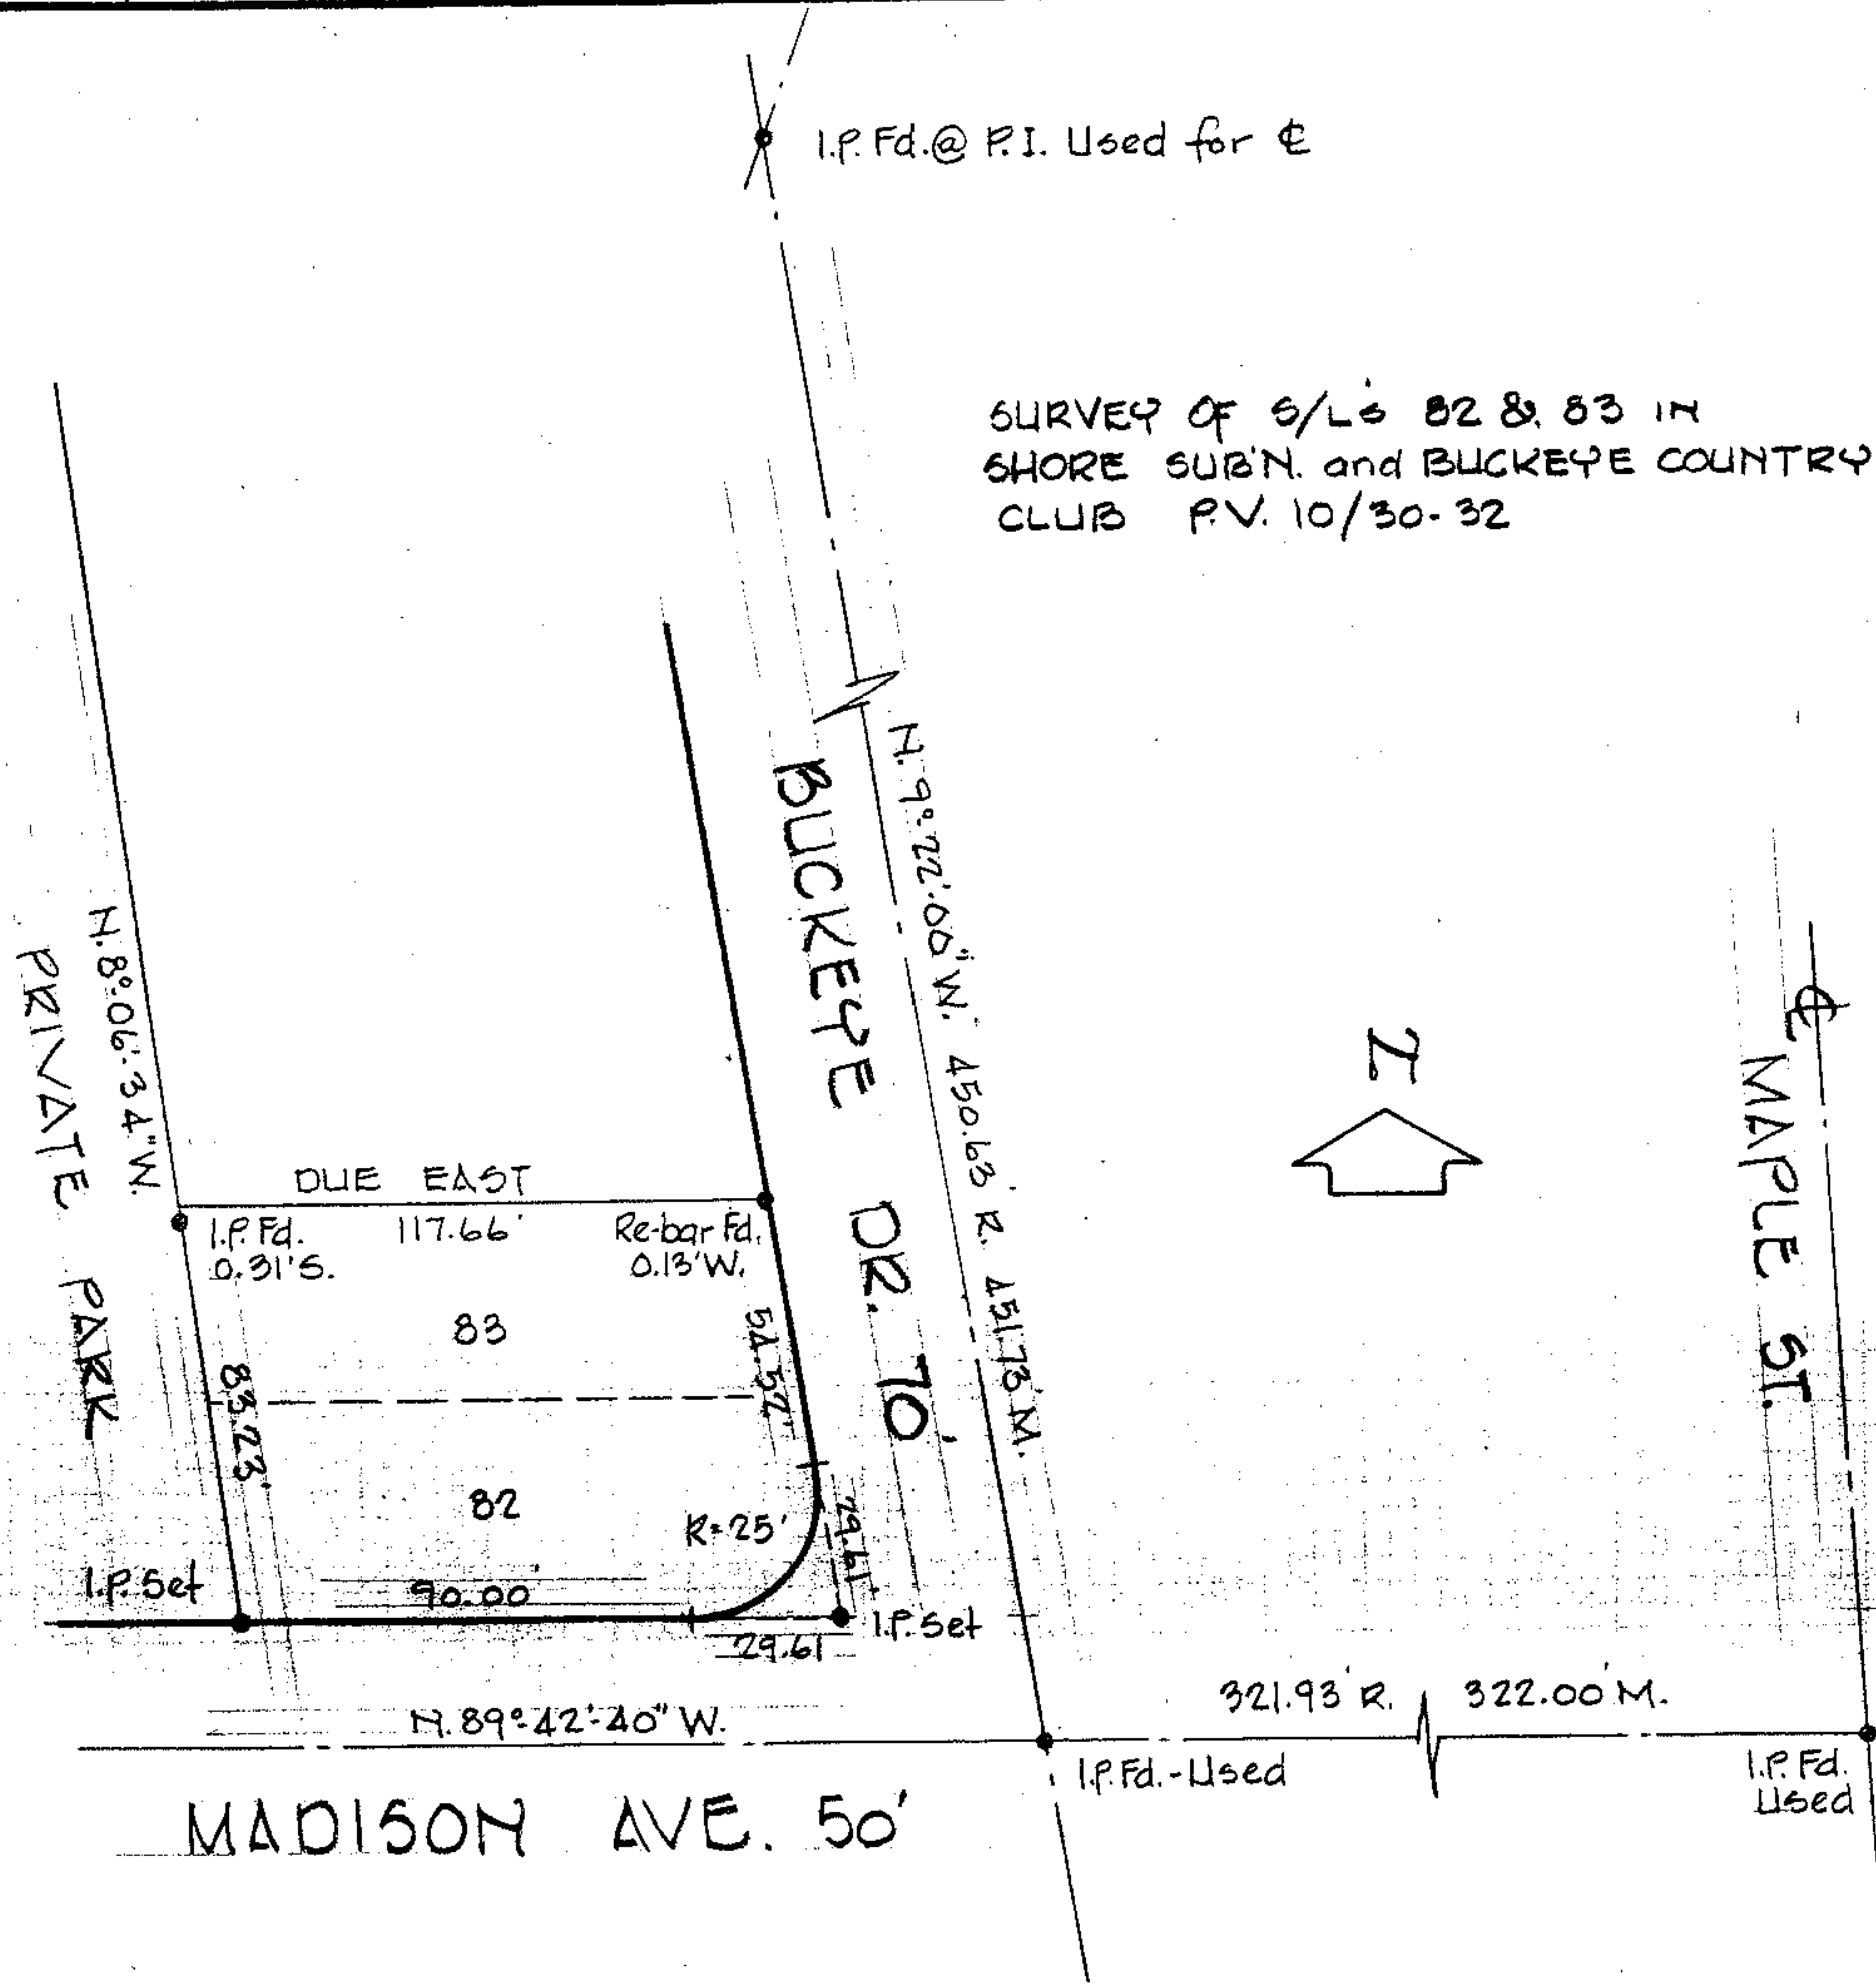

MADISON AVE. 50'