

44827

09-00-076-103-035
036
034
033



LAUNDON • SIMON • CAHL & ASSOC., INC.
CONSULTING ENGINEERS & SURVEYORS
110 MIDDLE AVE., ELYRIA, O. 44035


SURVEY FOR: 09-00-076-A

NORTH SHORE PROPERTIES

09-00-076-103-036

| | | |
|--------------------|------------------|------------------------------|
| Orig. Lot 76 | City of OBERLIN | Date JAN. 1993 Scale 1"=40' |
| Orig. Sec | Village of | Dwn. by R.G.S. Chkd. by R.C. |
| Tract | County of LORAIN | Job No. 92-2283 F.B. 226/73 |
| Township of RUSSIA | State of OHIO | Printed |

NORTH PLEASANT ST. 49.50'

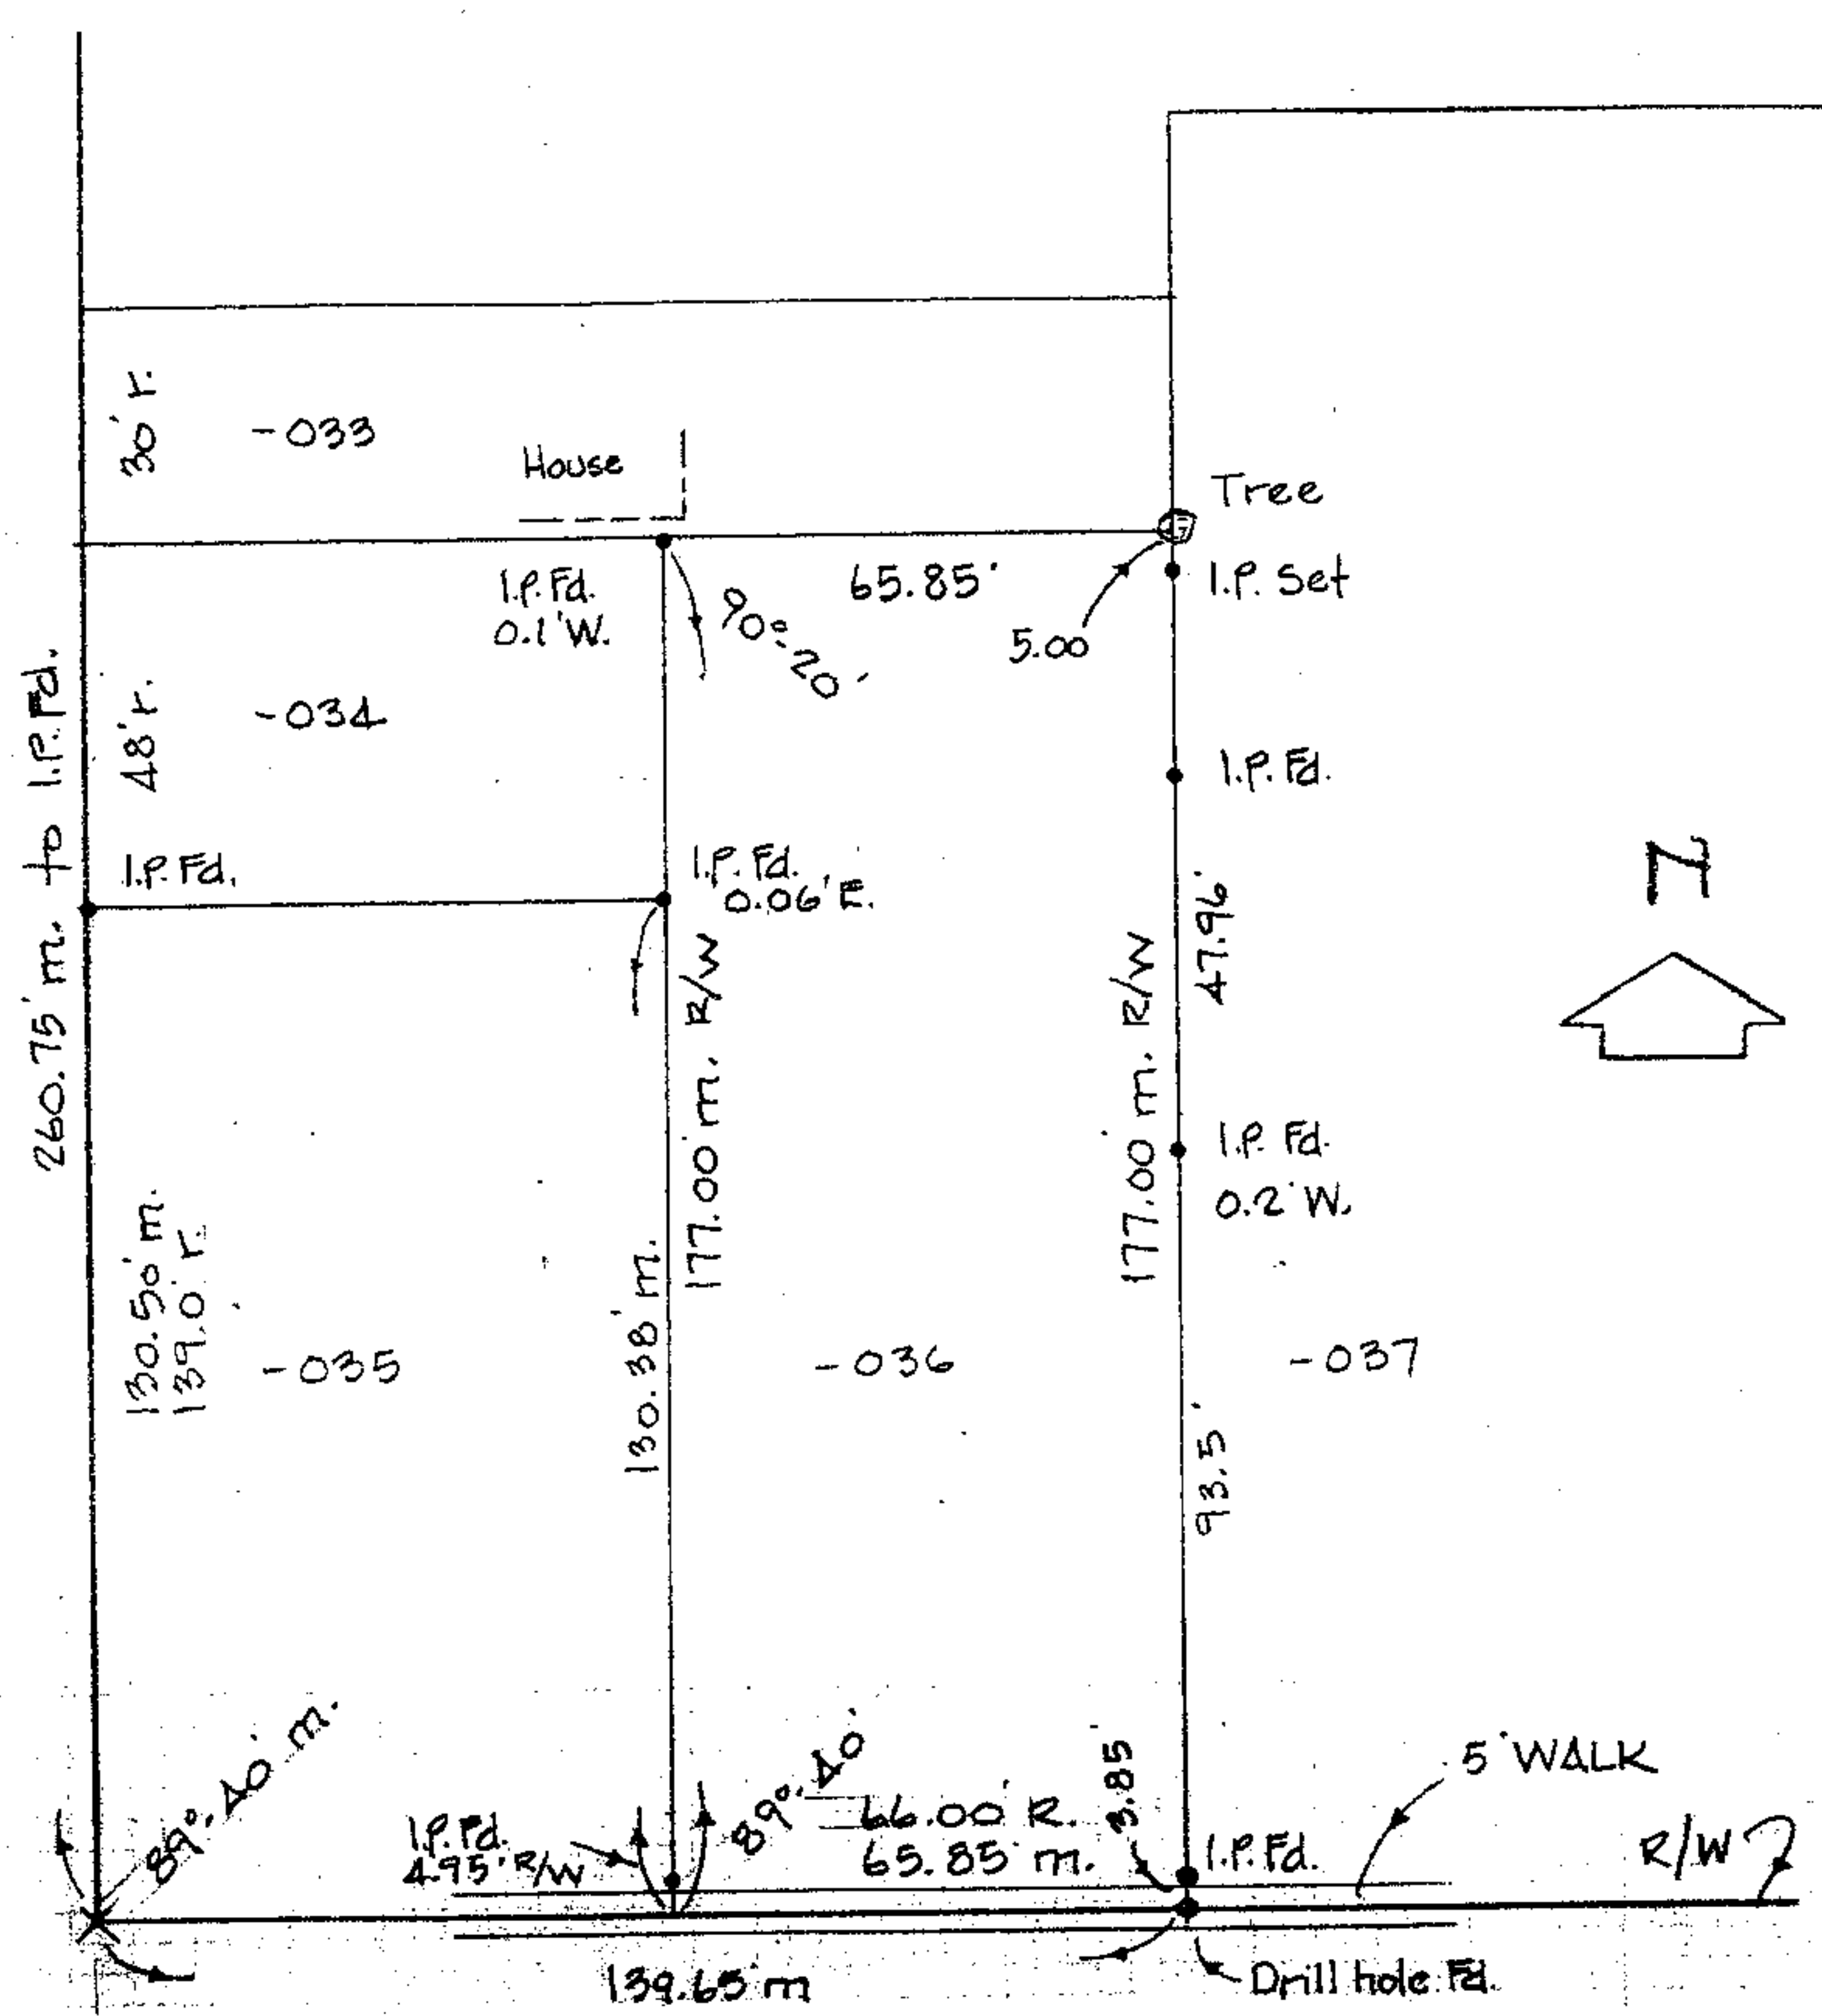

EAST LORAIN ST. 66'

