

44841

05-00-026-103-001

05-00-024-B



LAUNDON • SIMON • CAHL & ASSOC., INC.
CONSULTING ENGINEERS & SURVEYORS
110 MIDDLE AVE., ELYRIA, O. 44035

SURVEY FOR:


H.A. & L.A. PAINE

PLAZA HEIGHTS ALLOT. P.V. 22 P. 12 S/L 23

Orig. Lot 26	City of AMHERST	Date JUNE '92 Scale 1"=50'
Orig. Sec	Village of	Dwn. by R.G.S. Chkd. by R.C.
Tract	County of LORAIN	Job No. 92-2216 F.B. -
Township of AMHERST	State of OHIO	Printed

PLAZA DR. 60'

5.2°-32'-00" W.

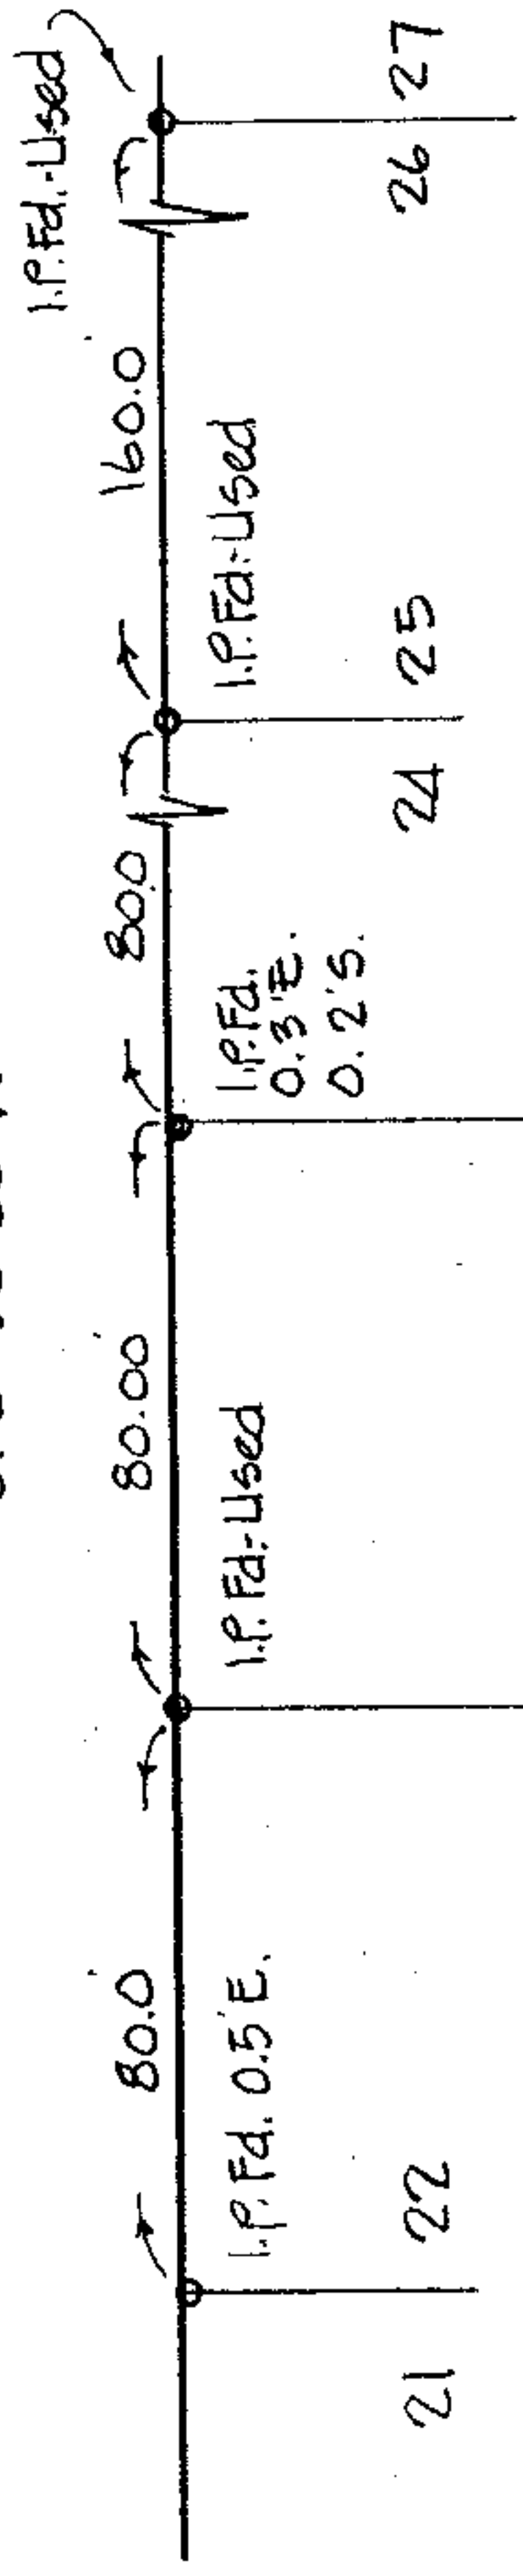

N. 87°-28'-00" W.
224.65'

225.45'
S. 87°-28'-00" E.

23

5 UTIL. EASMT.

80.00'
S. 3°-03'-00" W.

Drilled hole in rock
@ base of 18" Maple

I.P. Set