

# 44852


10-00-005-107-071  
10-00-005-H



LAUNDON • SIMON • CAHL & ASSOC., INC.  
CONSULTING ENGINEERS & SURVEYORS  
110 MIDDLE AVE., ELYRIA, O. 44035

SURVEY FOR:  
MICHAEL P. & DIANE E.  
SALVA

Orig. Lot	City of	Date MAY '92 Scale 1"=100'
Orig. Sec 5	Village of	Dwn. by R.G.S. Chkd. by R.C.
Tract	County of LORAIN	Job No. 92-2185 F.B. 223/3738-71
Township of CARLISLE	State of OHIO	Printed

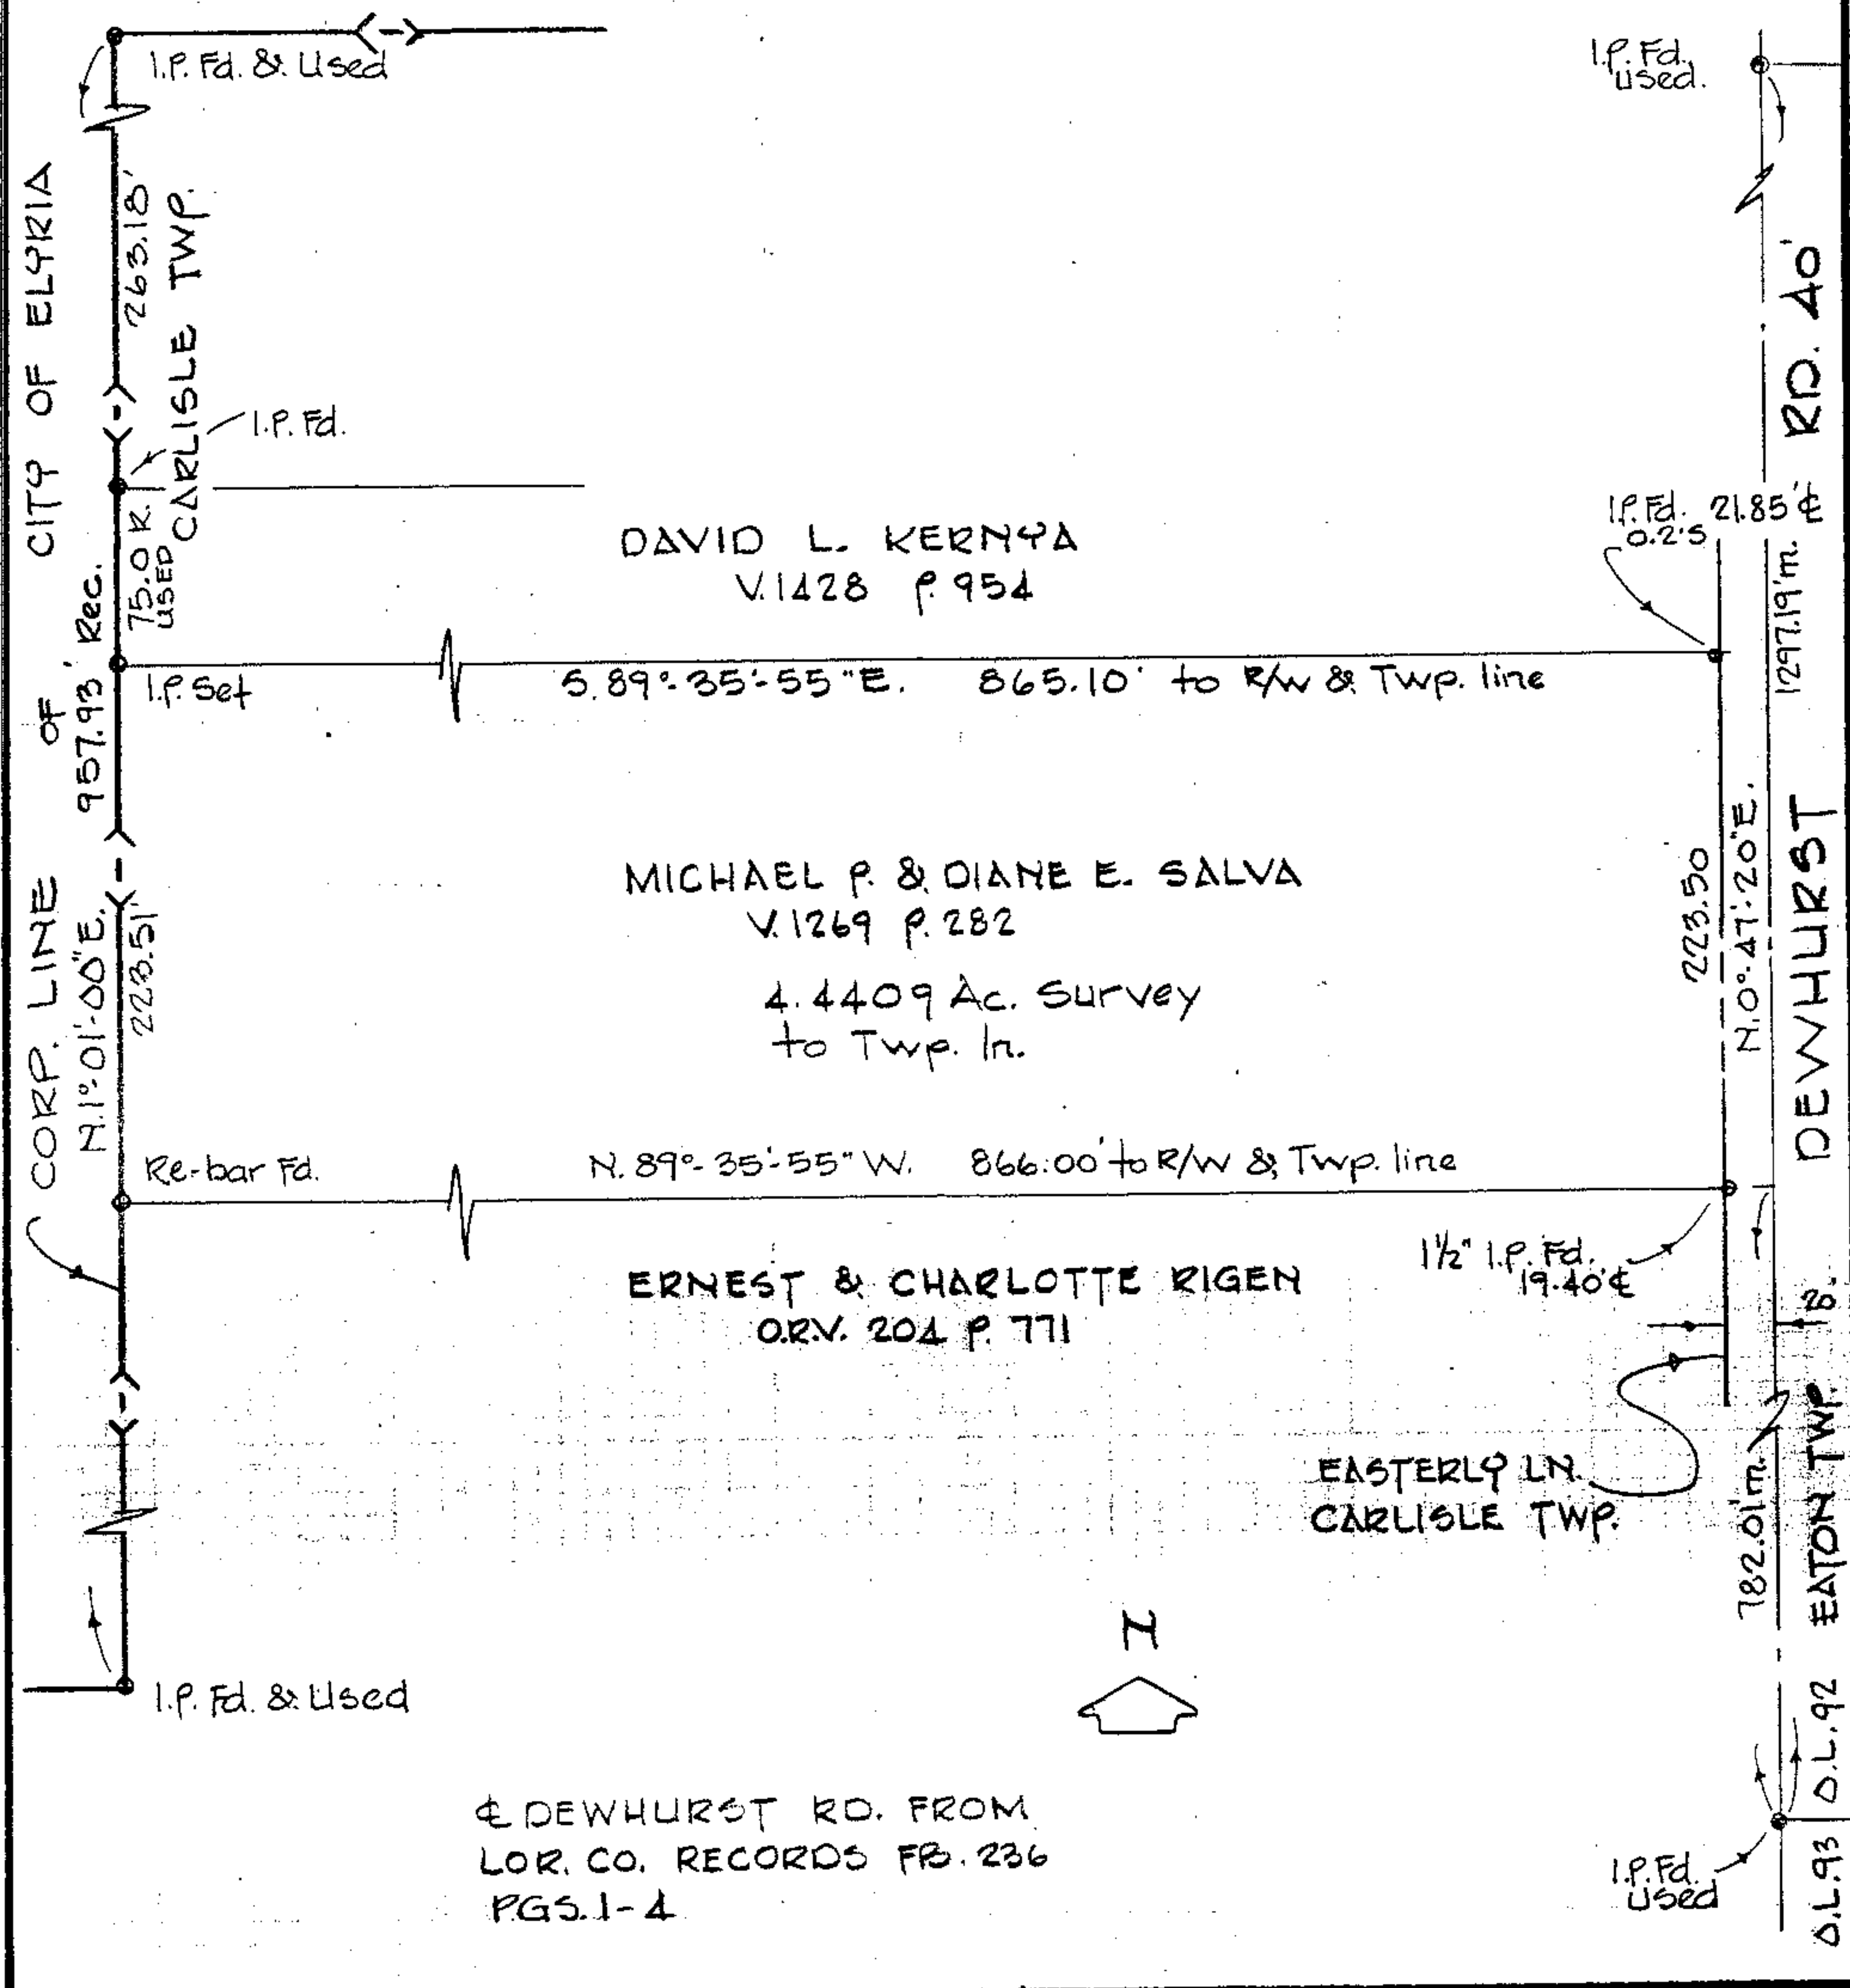

DEWHURST RD. FROM  
LOR. CO. RECORDS FB. 236  
PGS. 1-4