

44860

14-00-053-000-009
010




LAUNDON • SIMON • CAHL & ASSOC., INC.
CONSULTING ENGINEERS & SURVEYORS
110 MIDDLE AVE., ELYRIA, O. 44035

SURVEY FOR: 14-B

JDL MULL FARMS

Orig. Lot 53	City of	Date AUG. 1955	Scale 1"=150'
Orig. Sec	Village of	Dwn. by R.G.S.	Chkd. by R.C.
Tract	County of LORAIN	Job No. 95-2752	F.B. 235/48
Township of PITTSFIELD	State of OHIO	Printed	

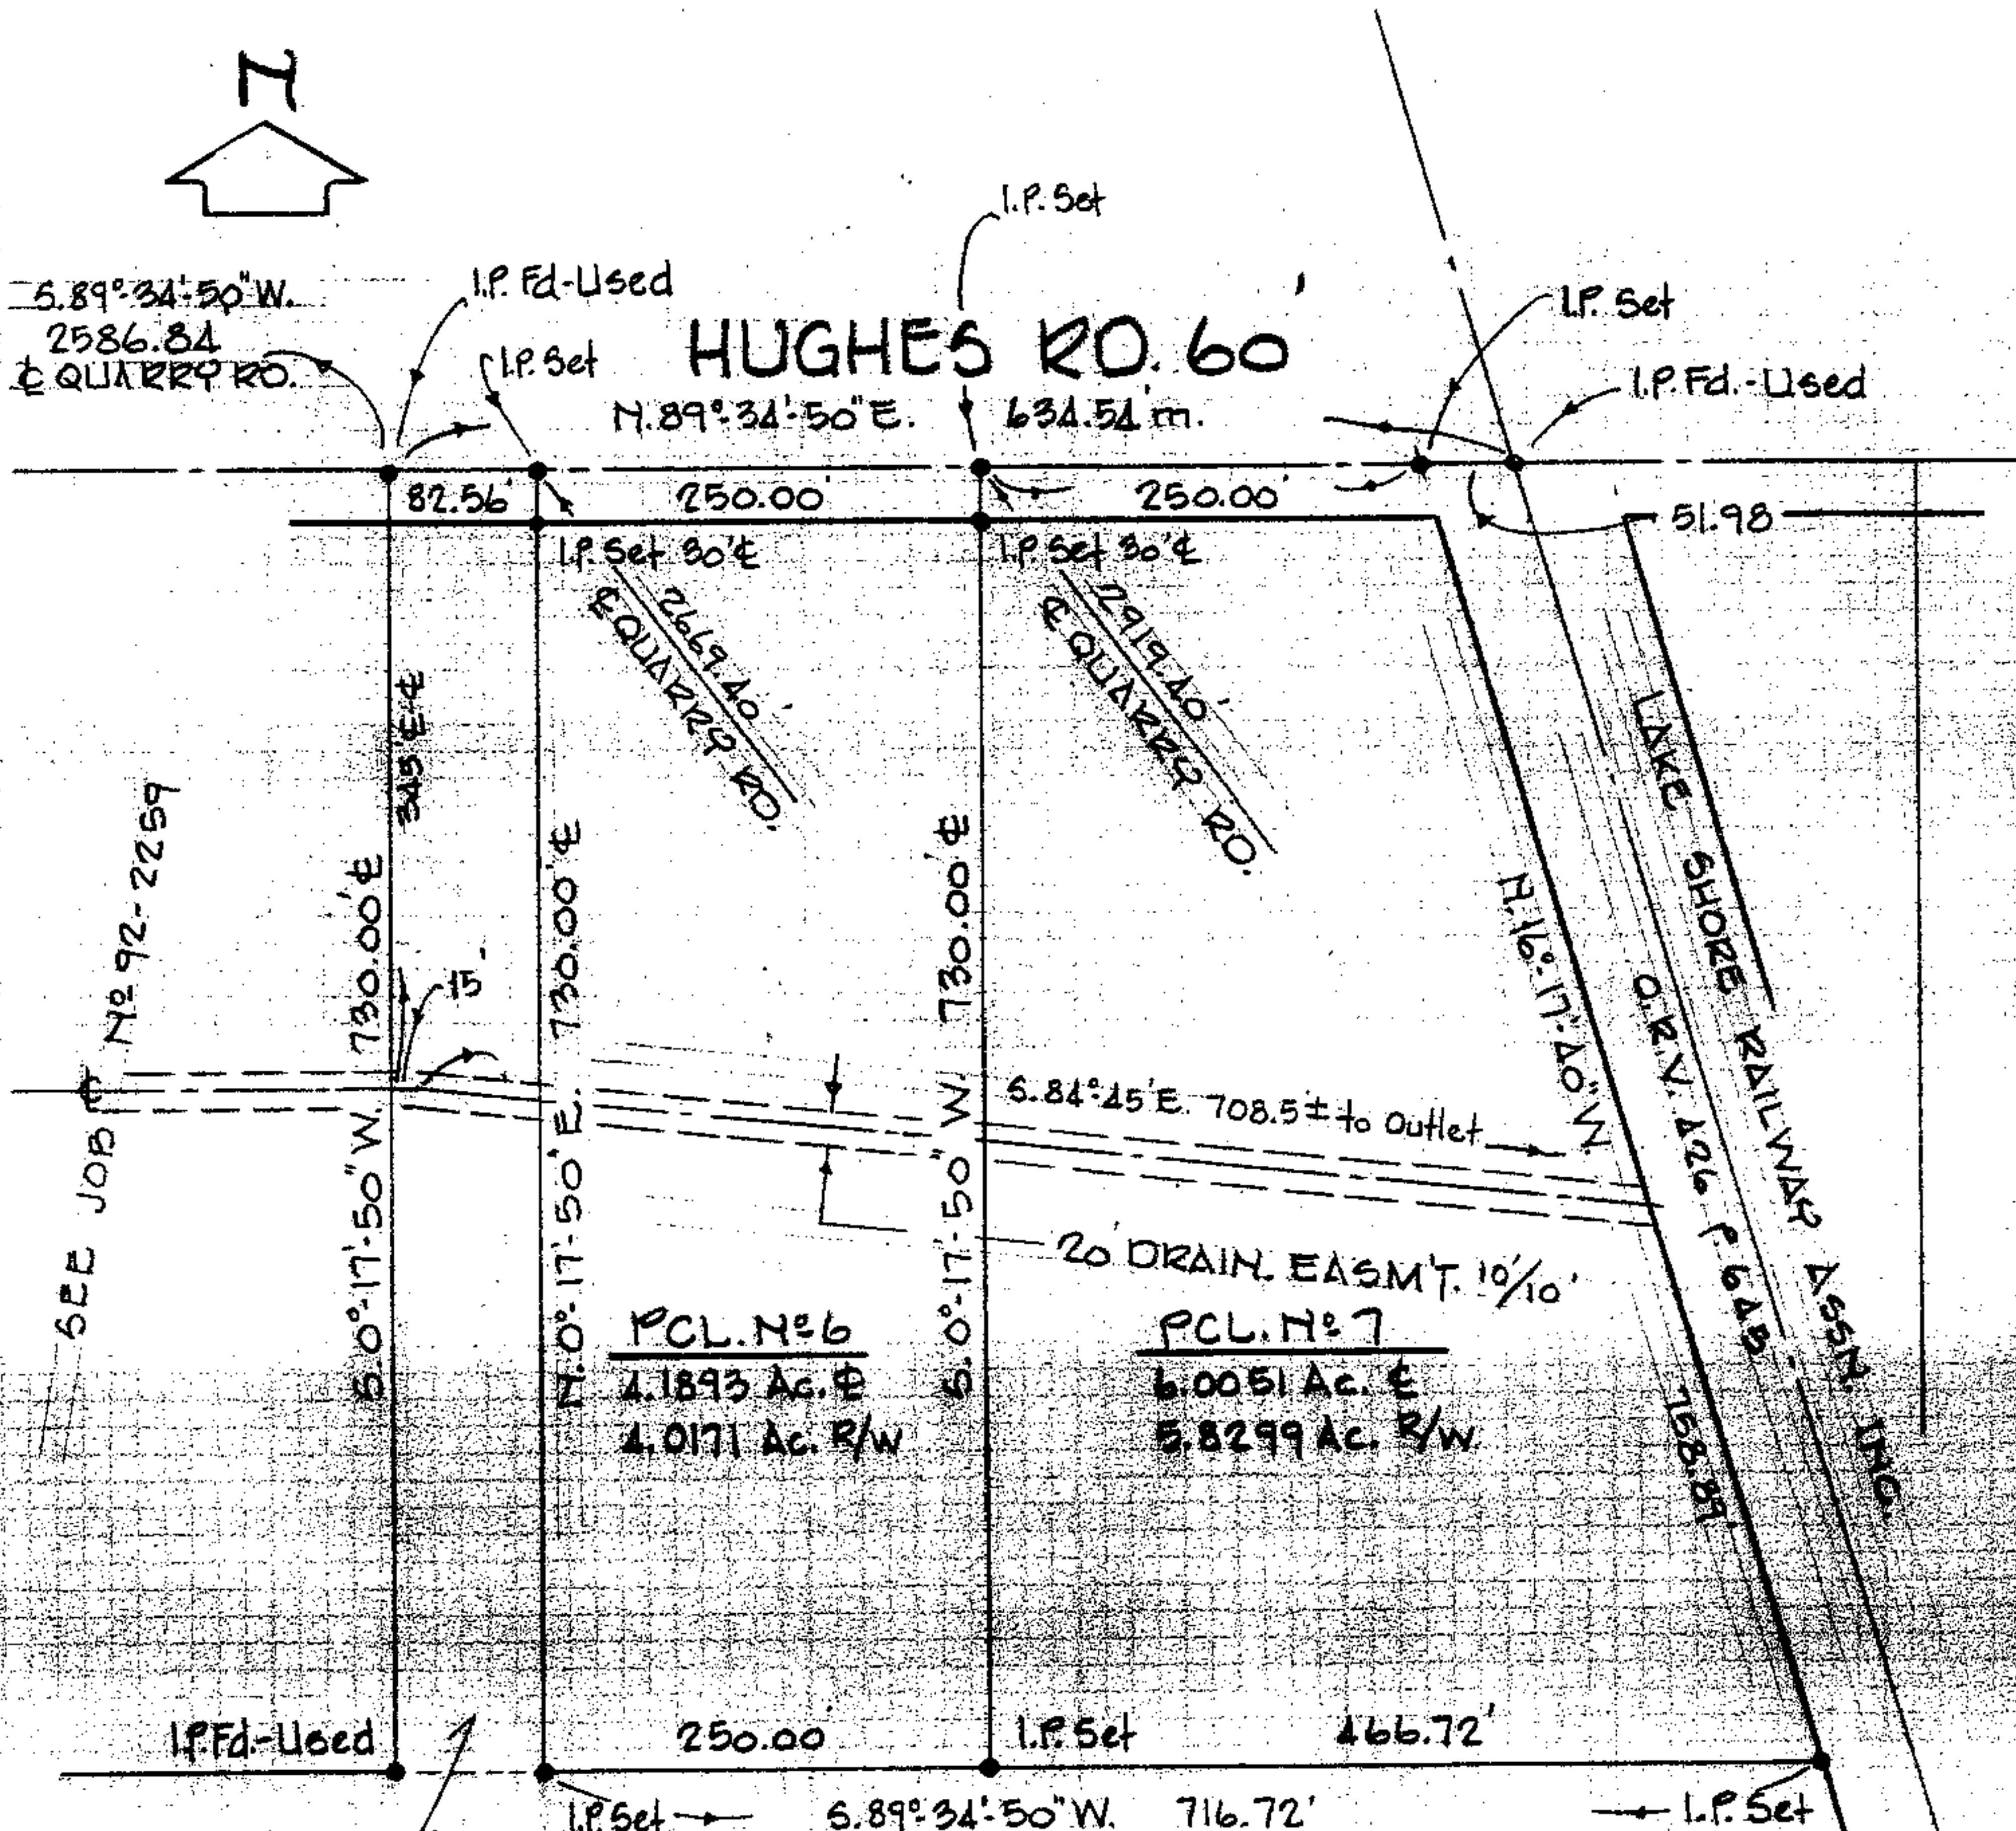

JDL MULL FARMS
D.V. 1379 P. 748