

# 44867

02-01-004-114-005

02-01-004-B



LAUNDON • SIMON • CAHL & ASSOC., INC.  
CONSULTING ENGINEERS & SURVEYORS  
106 MIDDLE AVE., ELYRIA, O. 44035


SURVEY FOR  
CHARLES H. FAUROT

Orig. Lot 4	City of LORAIN	Date 12-4-91	Scale 1"=30'
Orig. Sec	Village of	Dwn. by RC	Chkd. by RS
Tract 1	County of LORAIN	Job No. 91-2131	F.B. 222/33
Township of BLACK RIVER	State of OHIO	Printed	



ALLEY

WASHINGTON

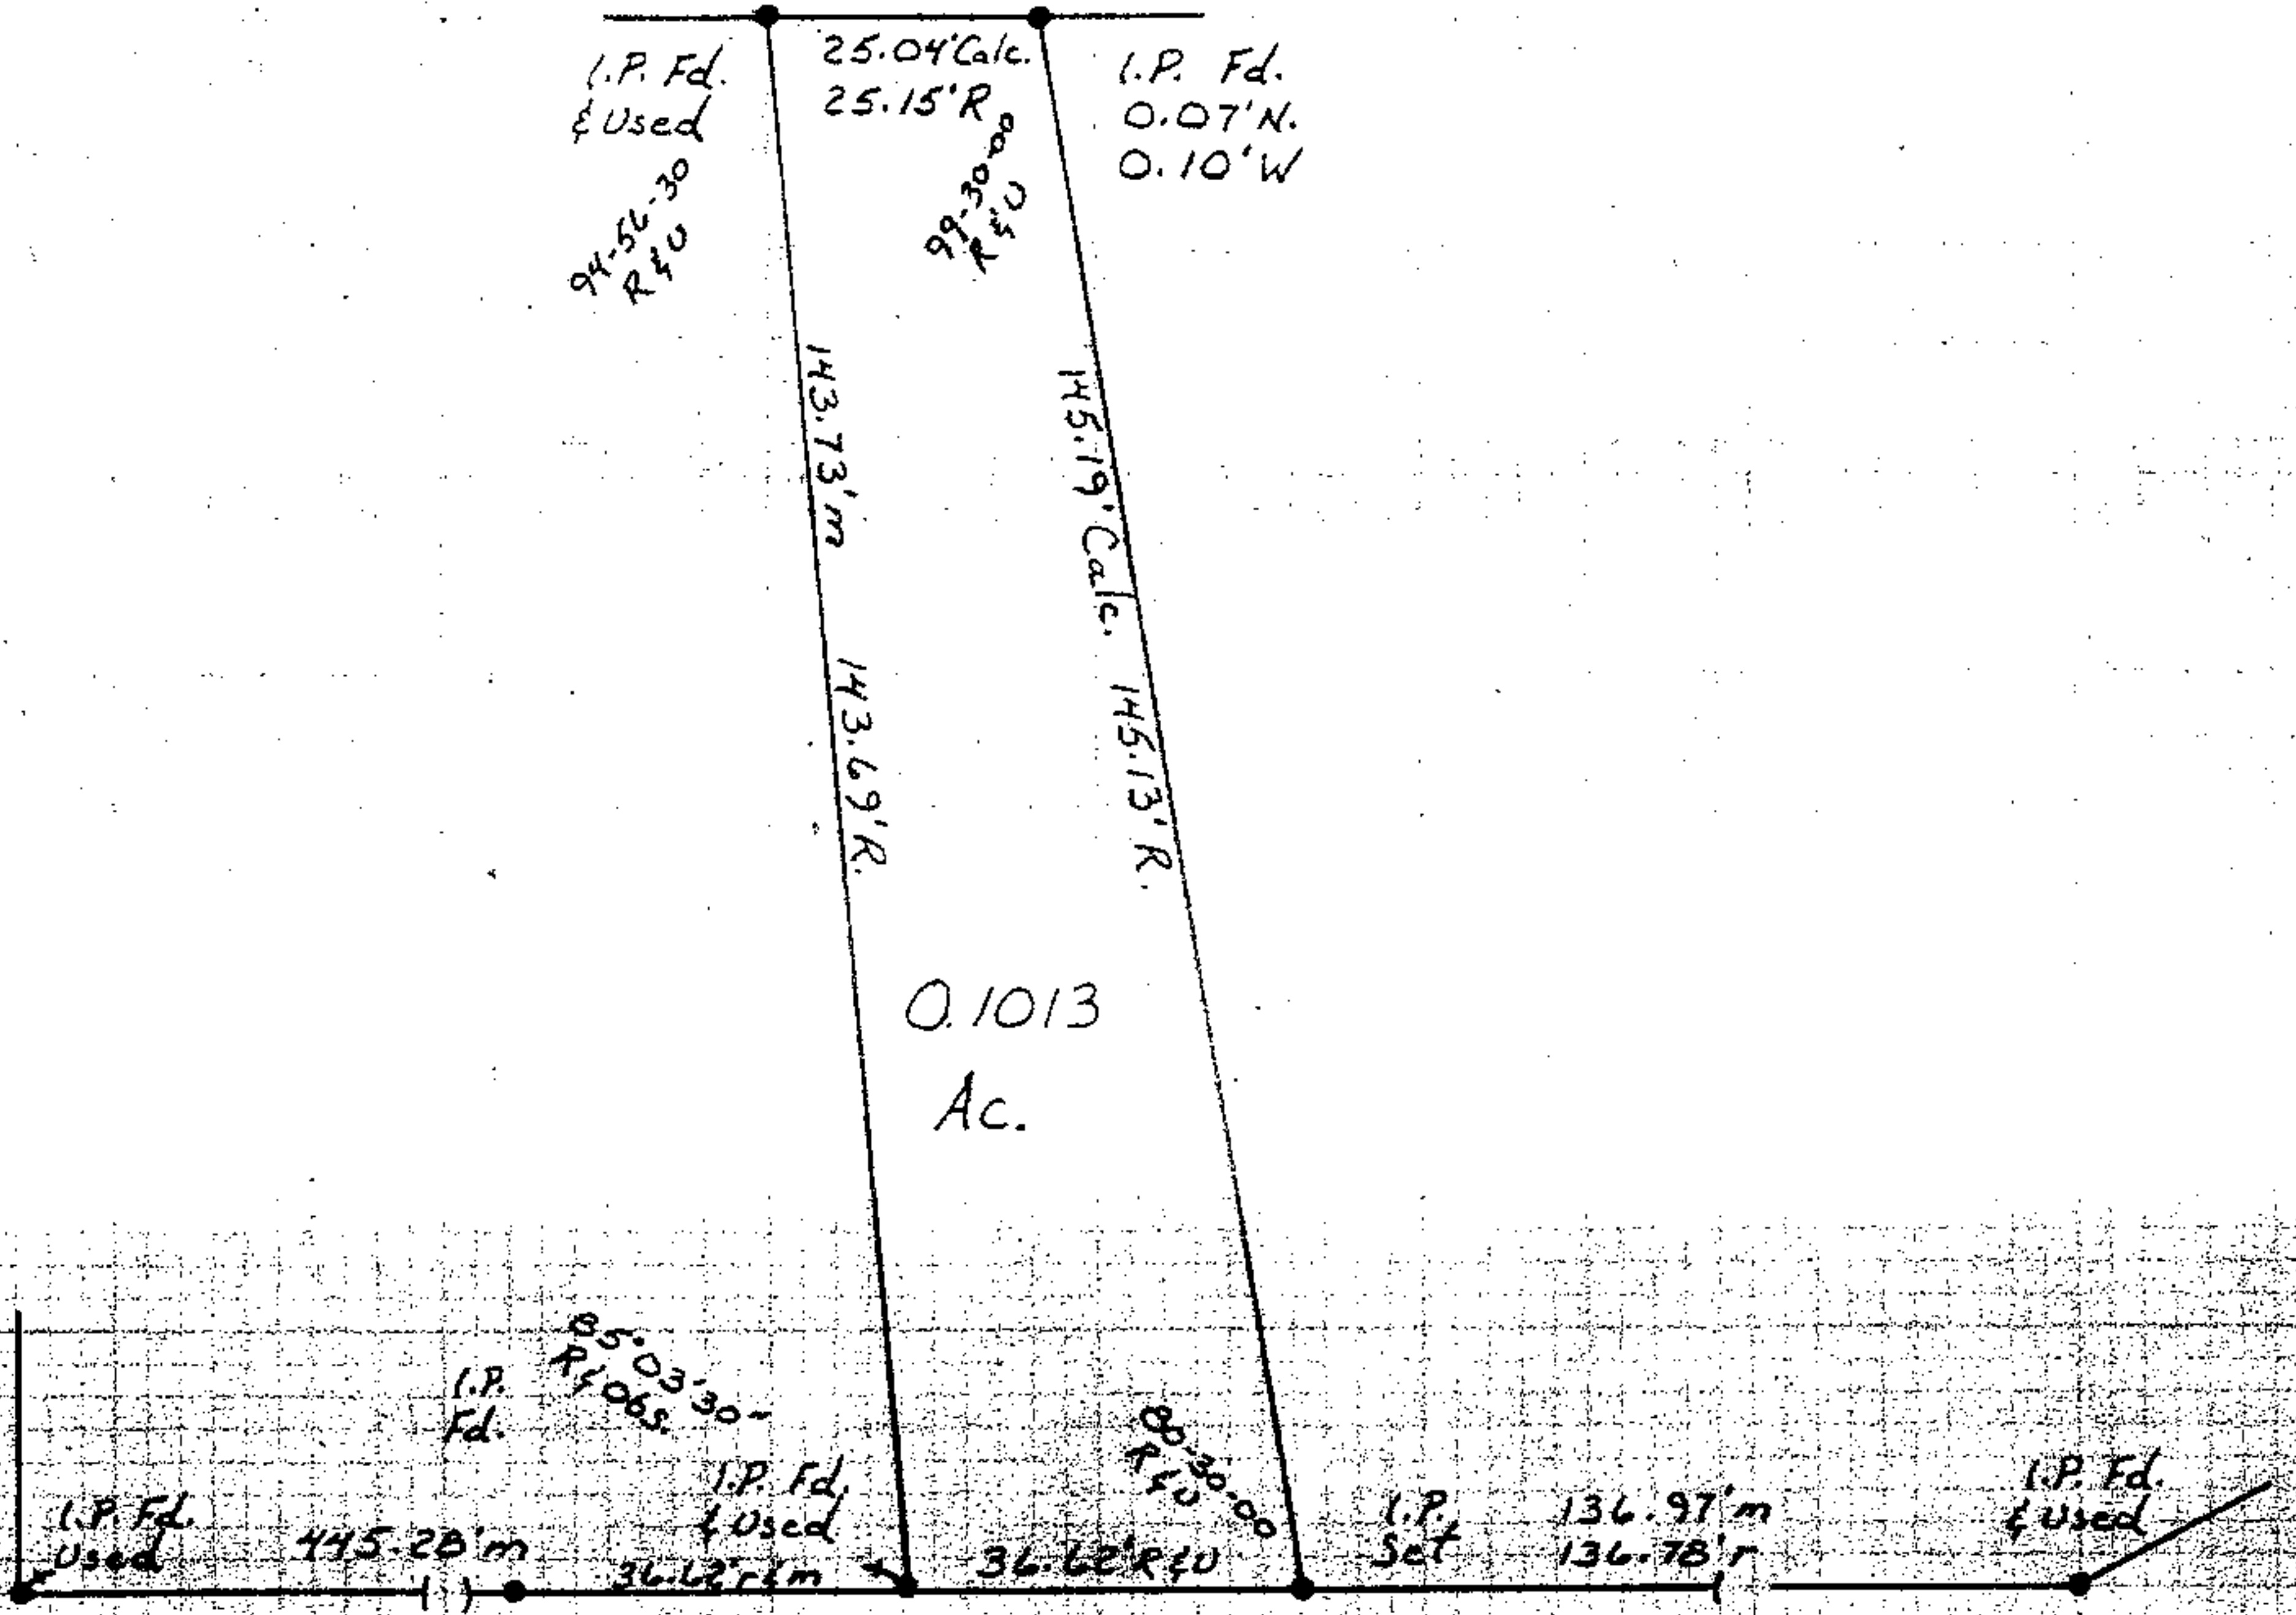

W. 11<sup>TH</sup> ST. 60'