

#44880

02-01-006-170-020
02-01-006-E 021



LAUNDON . SIMON . CAHL & ASSOC. INC.
CONSULTING ENGINEERS & SURVEYORS
219 COURT ST. ELYRIA, OHIO 44035



SURVEY FOR:
HELEN P MARCINIAK

Orig. Lot 6	City of LORAIN	Date 8-26-91	Scale 1"=30'
Orig. Sec	Village of	Dwn. by R.G.S.	Chkd. by R.C.
Tract	County of LORAIN	Job No. 91-2082 F.B.	
Township of BLACK RIVER	State of OHIO	Printed	

S/L 15 FALBO SUBN.
P.V. 15 P. 73



HAMILTON AVE. 60'

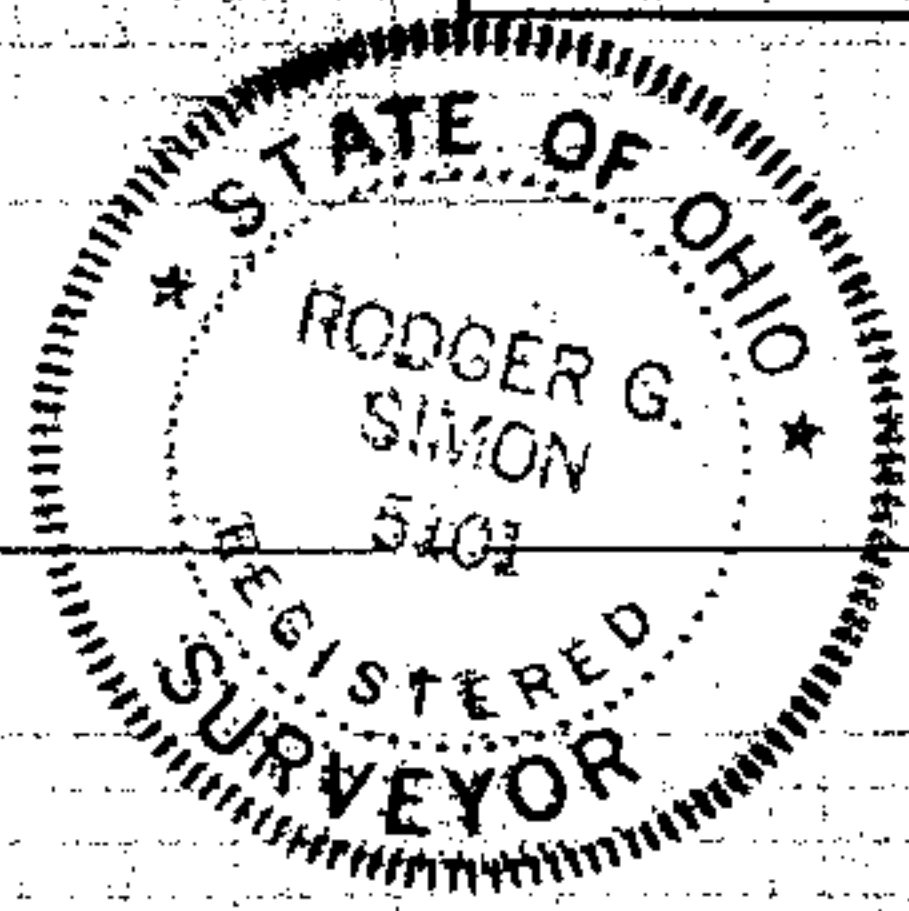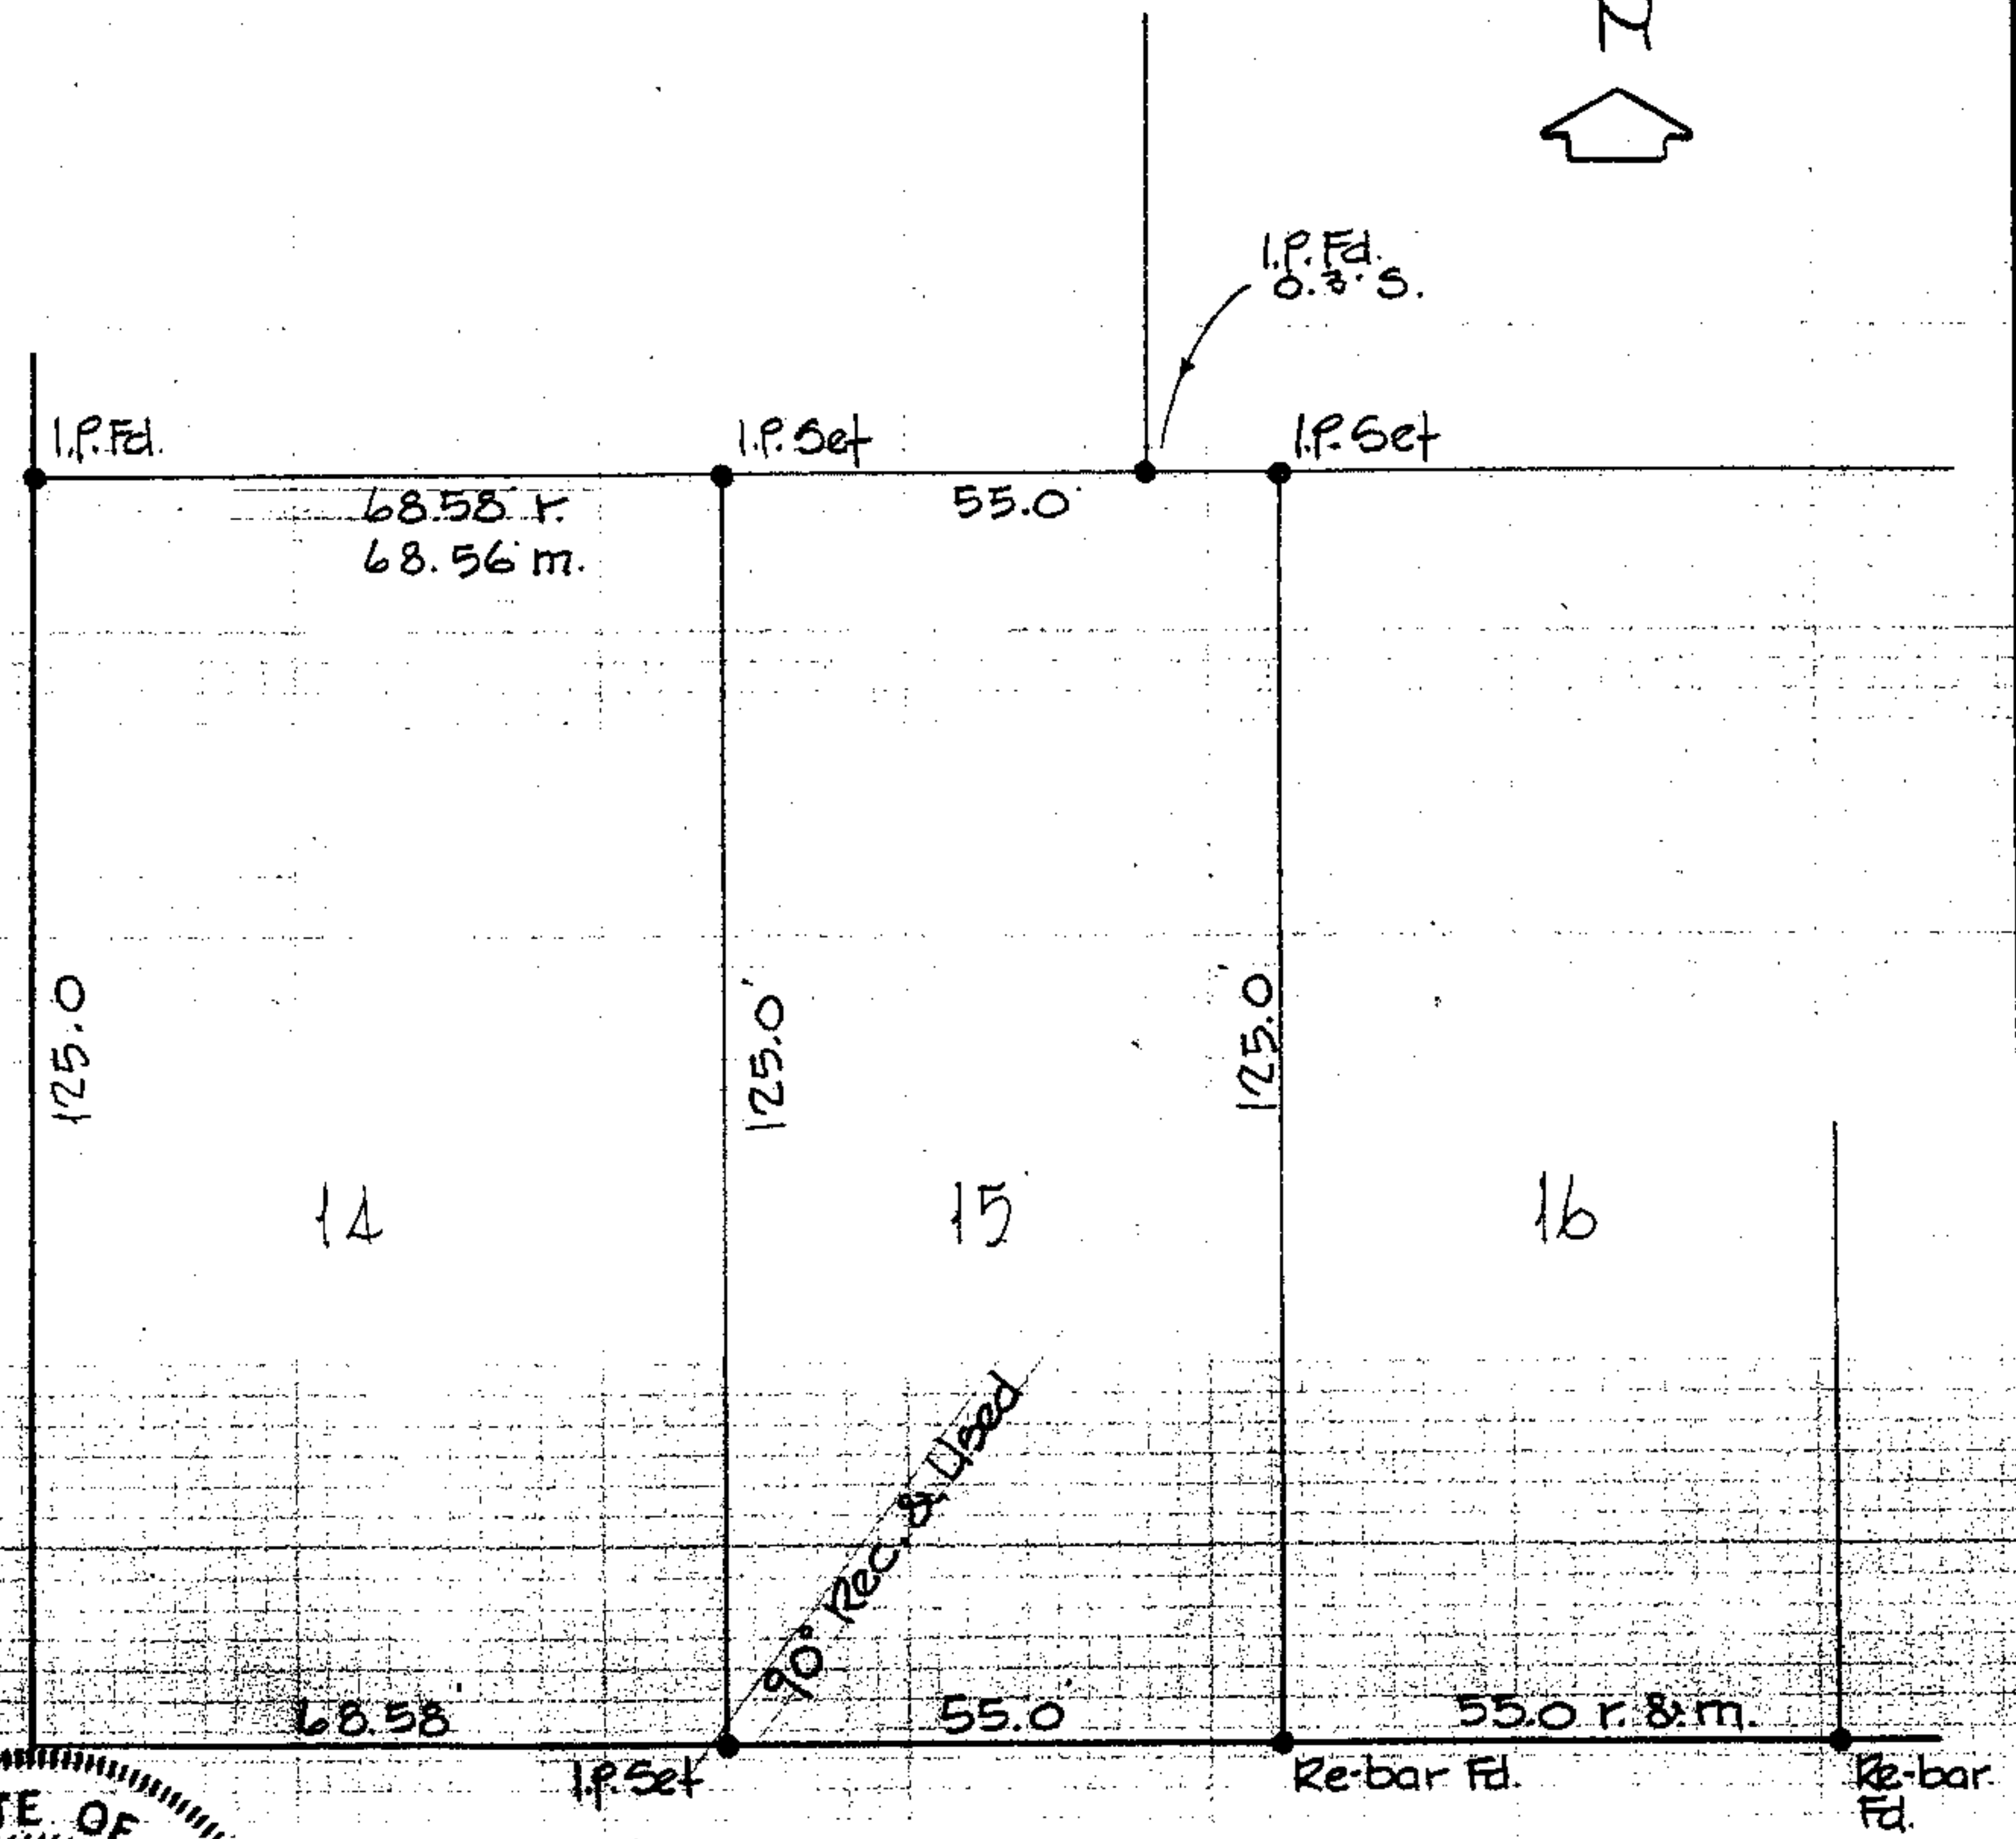

WEST 30TH ST. 60'