

#44885


05-00-039.106-026



LAUNDON . SIMON . CAHL & ASSOC. INC.
CONSULTING ENGINEERS & SURVEYORS
ELYRIA, OHIO 44035

SURVEY FOR: 05-00-039-A
JOHN C. KITCHEN
5/4 44 WOODHILL ACRES SUBN. N#3
P.V. 22 P. II

Orig. Lot	City of AMHERST	Date AUG. 7, '91 Scale 1"=40'
Orig. Sec	Village of	Dwn. by R.G.S. Chkd. by R.C.
Tract	County of LORAIN	Job No. 91-2072 F.B. 221/37
Township of AMHERST	State of OHIO	Printed

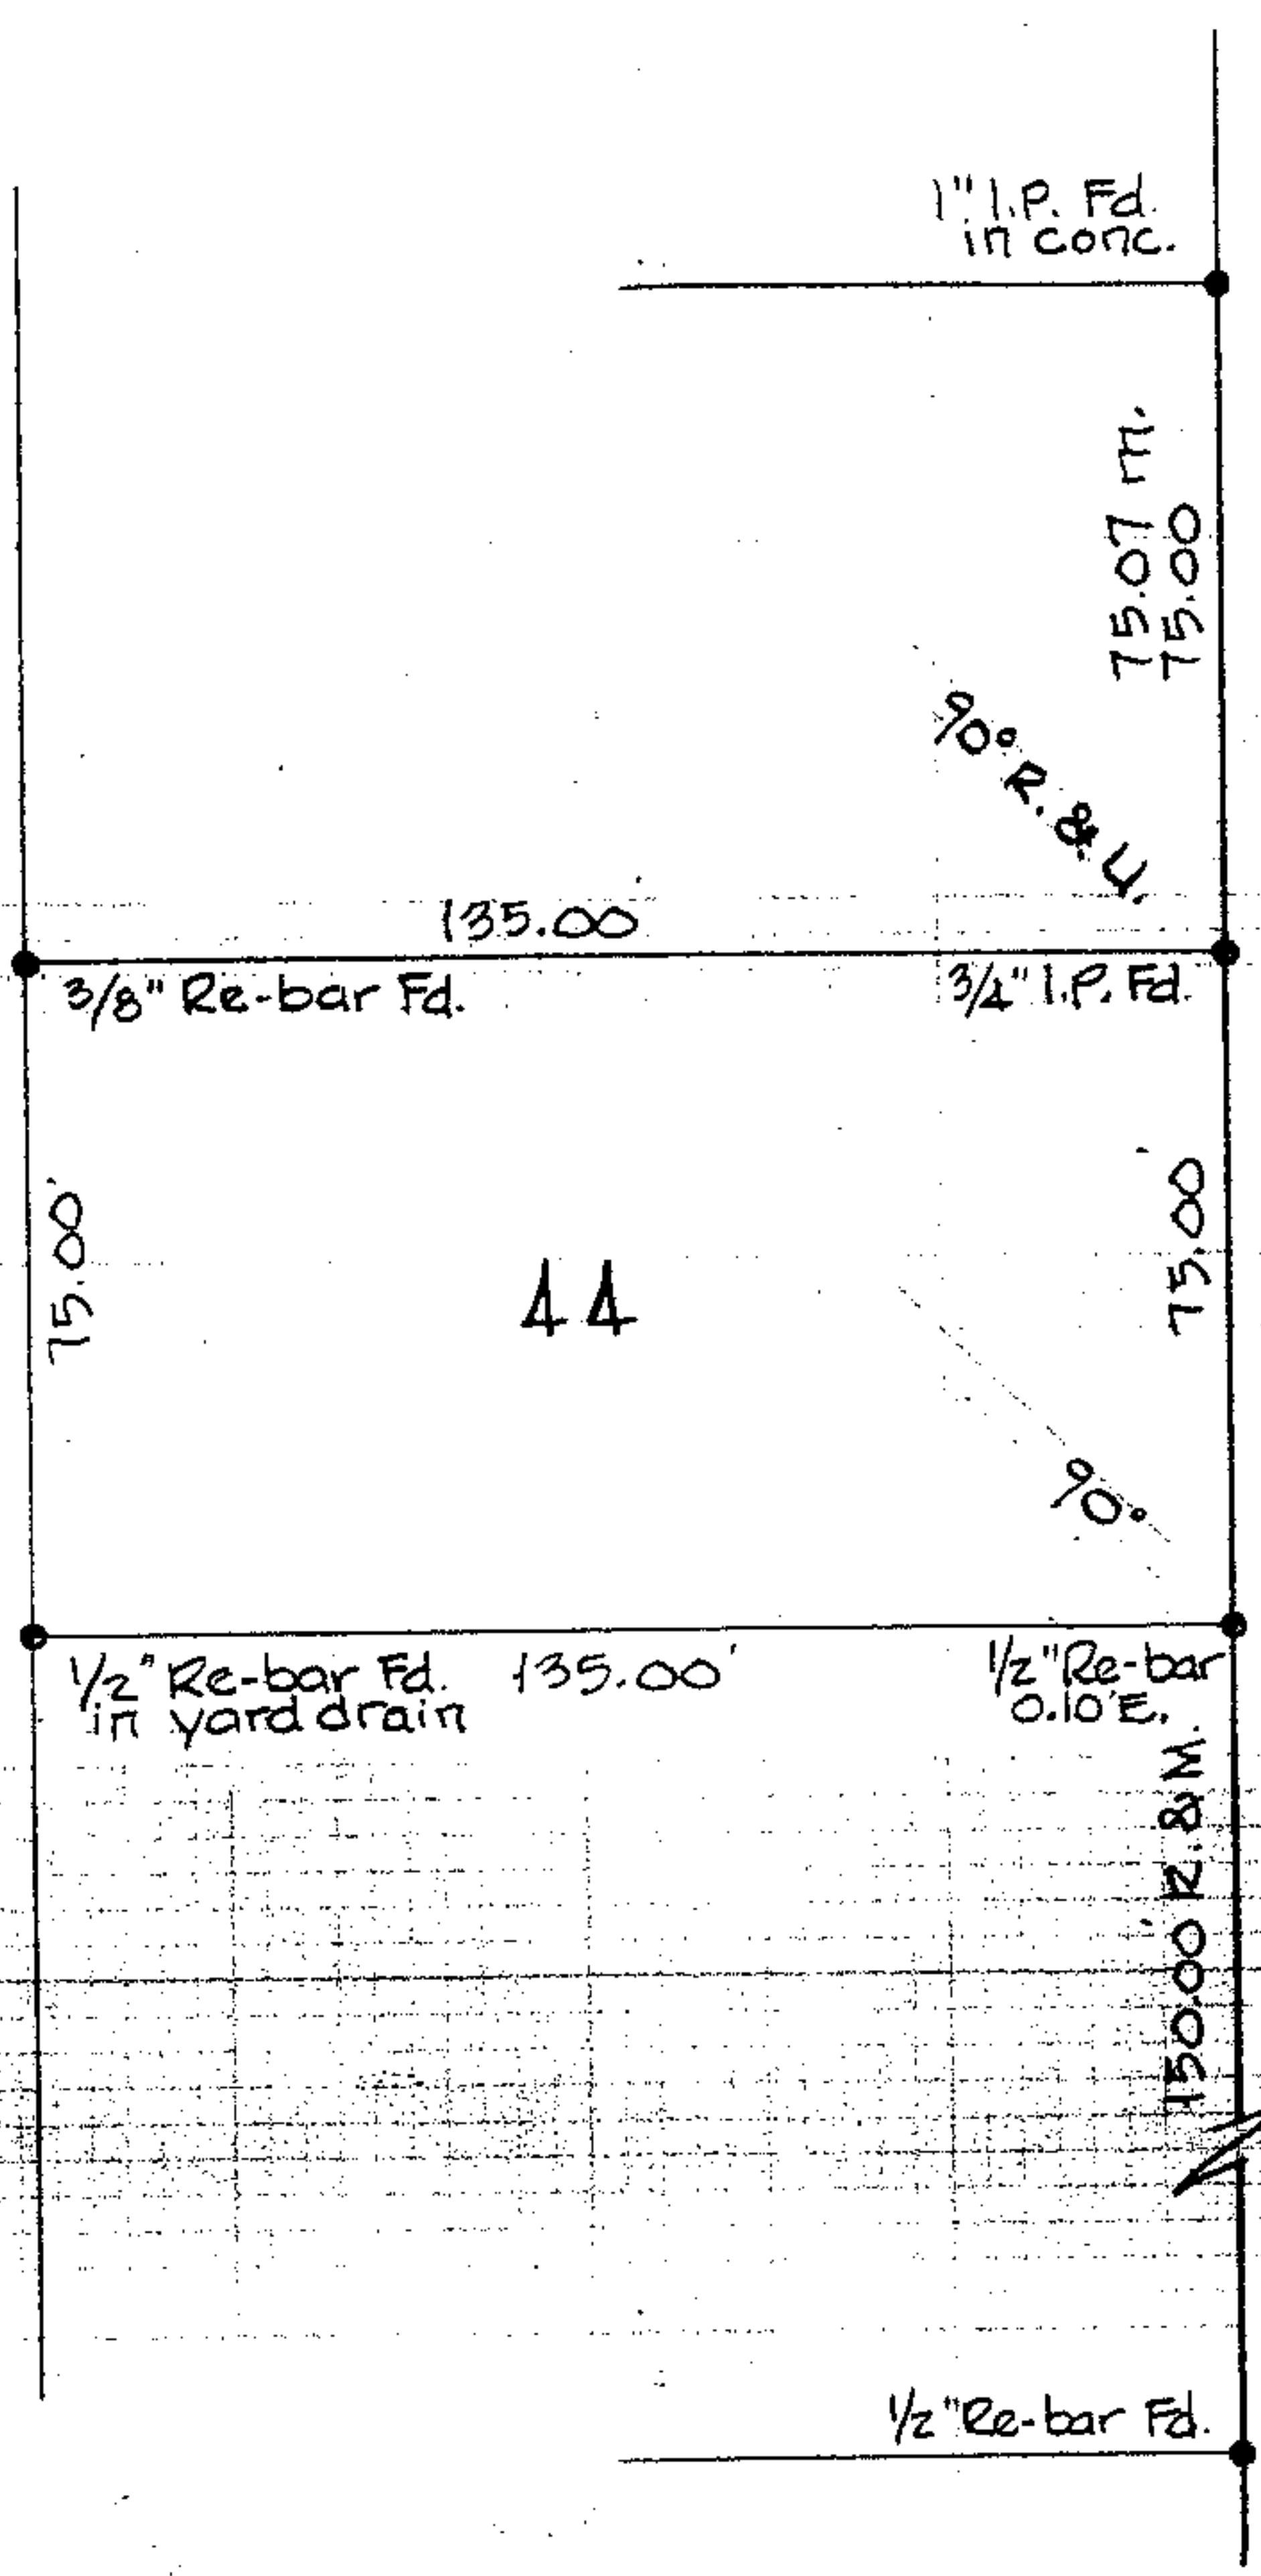

NORTH WOODHILL DR. 60'

