

# 44888

02-01-003-112-027  
02-01-003-B 028




LAUNDON . SIMON . CAHL & ASSOC. INC.  
CONSULTING ENGINEERS & SURVEYORS  
219 COURT ST. ELYRIA, OHIO 44035

SURVEY FOR:

RICHARD G. & SANDRA S.  
POZEGA

Orig. Lot 3	City of LORAIN	Date JULY '91 Scale " = 40'
Orig. Sec	Village of	Dwn. by R.G.S. Chkd. by R.C.
Tract	County of LORAIN	Job No. 91-2063 FB 221/15
Township of BLACK RIVER	State of OHIO	Printed

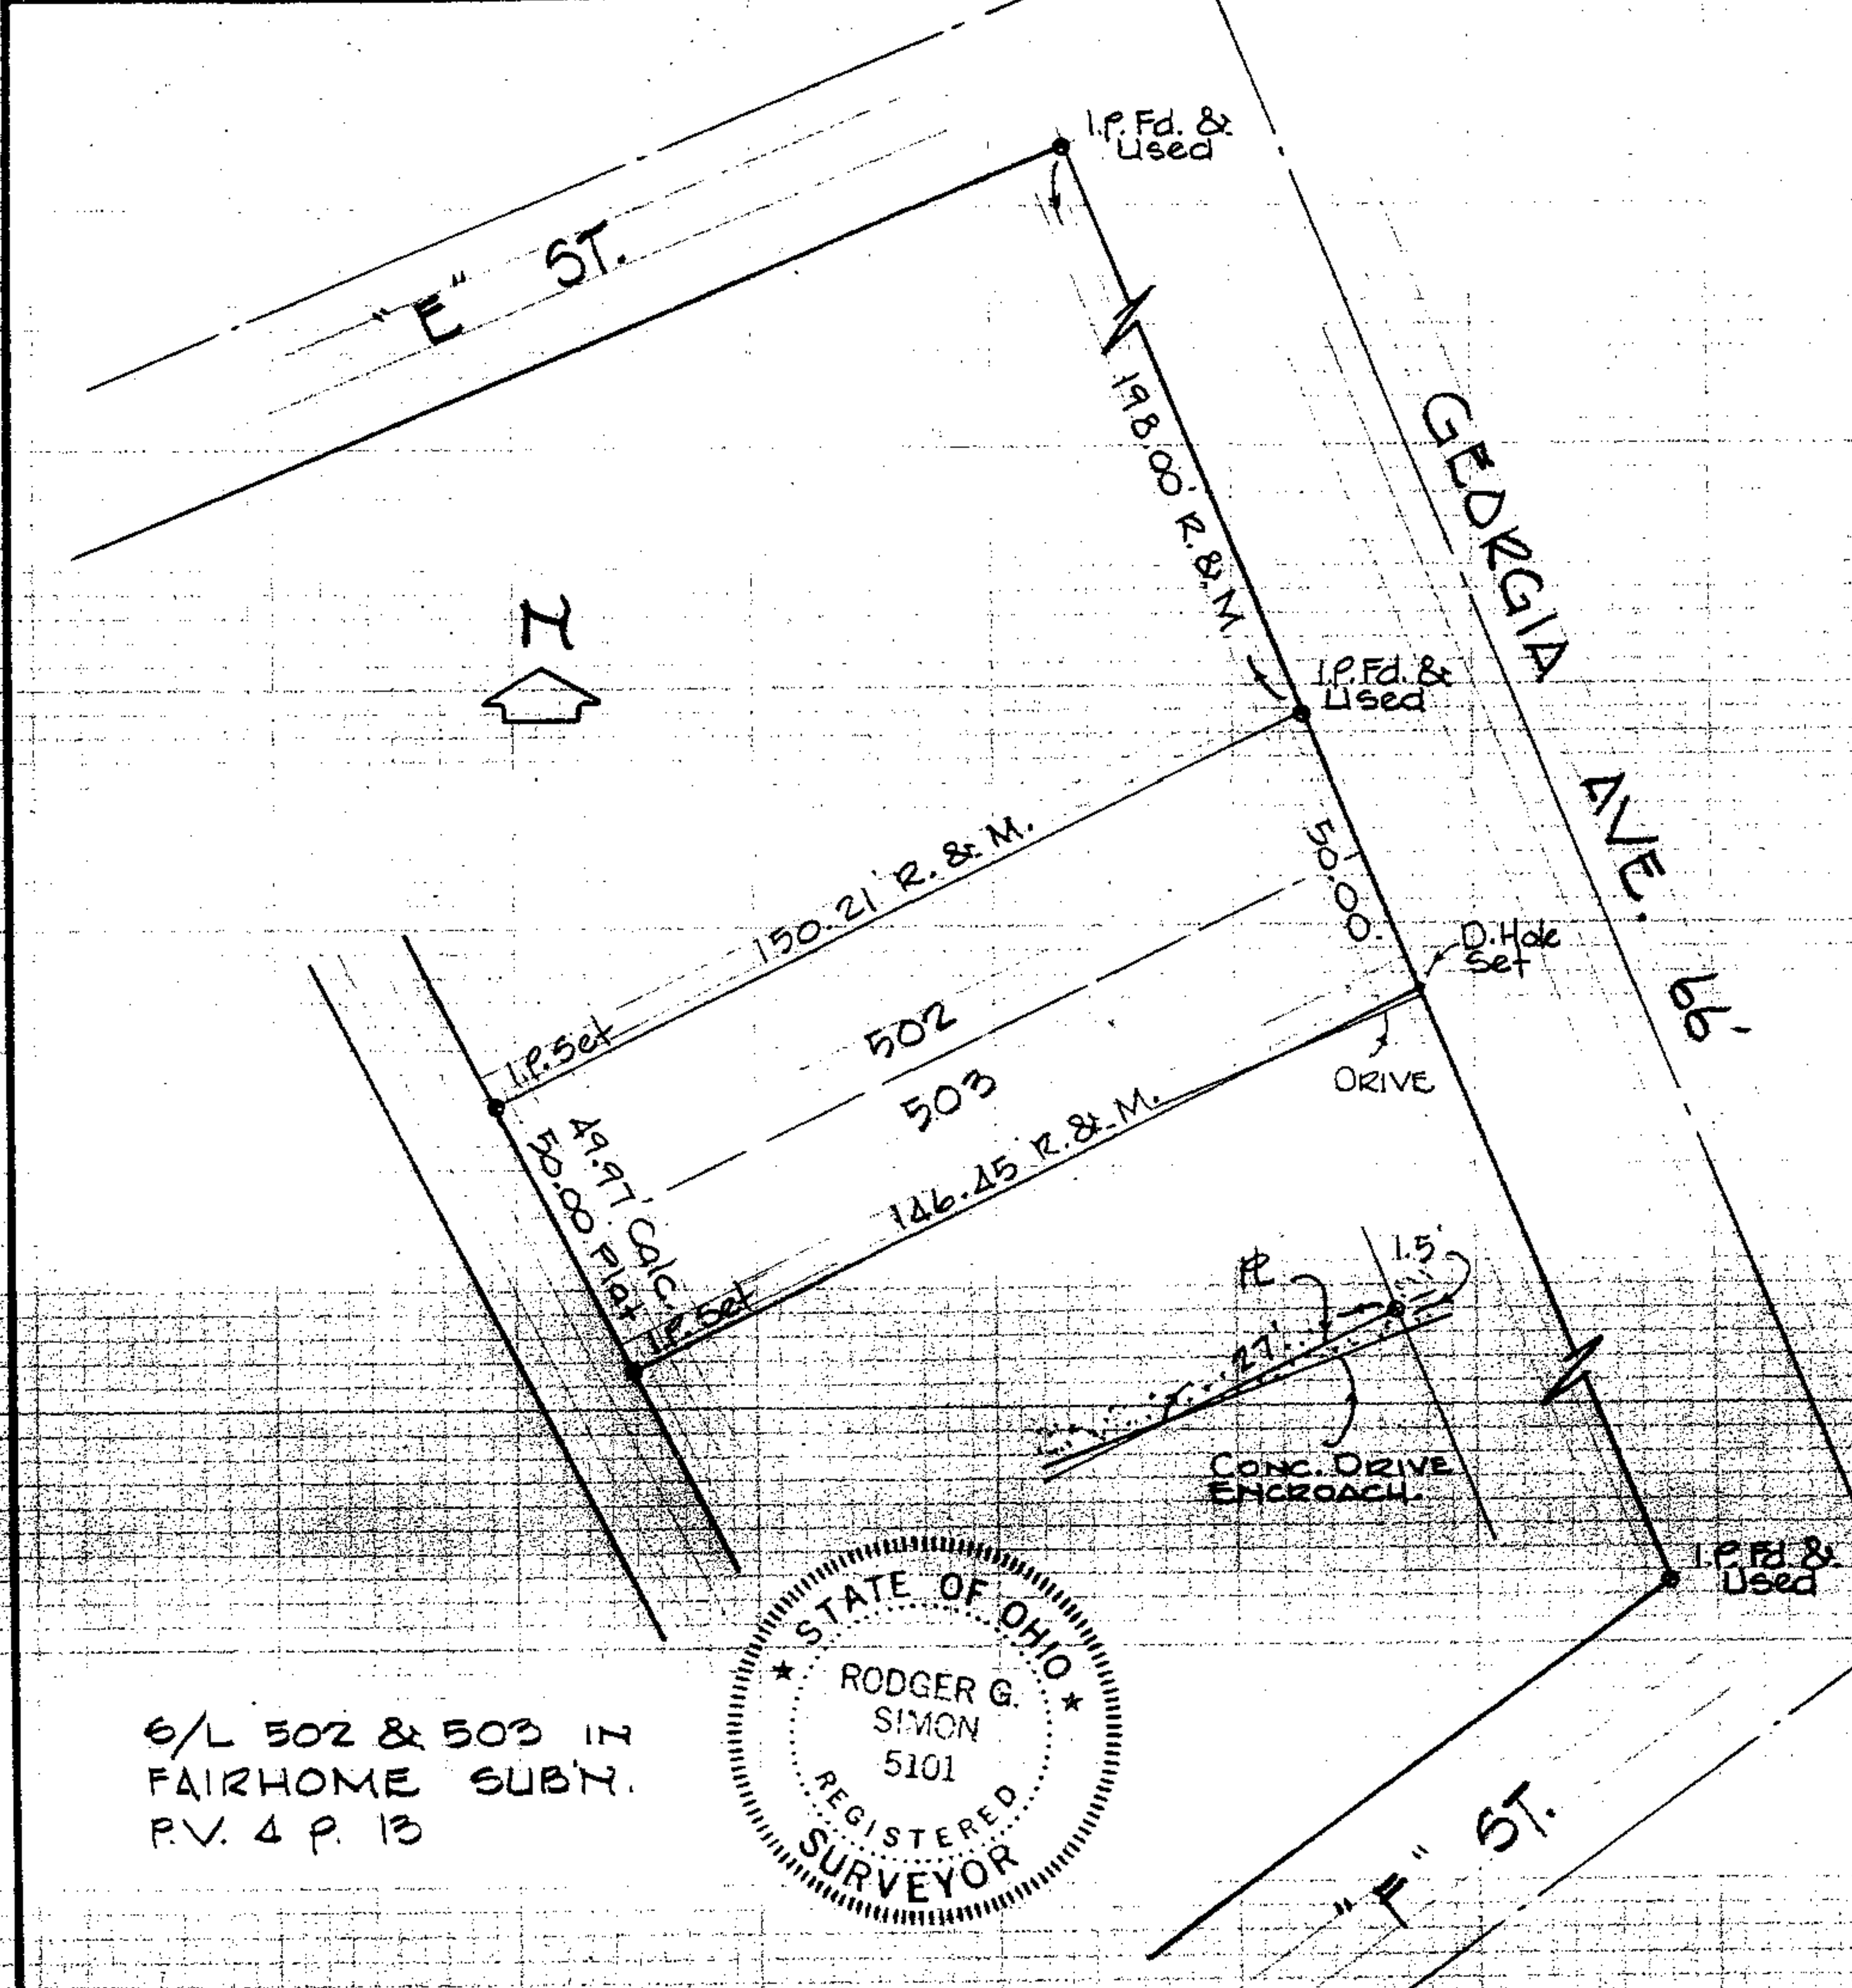

6/L 502 & 503 IN  
FAIRHOME SUB'D.  
P.V. 4 P. 13

