

#44936

14-00-088-000-014

14-F




LAUNDON . SIMON . CAHL & ASSOC. INC.
CONSULTING ENGINEERS & SURVEYORS
219 COURT ST. ELYRIA, OHIO 44035

SURVEY FOR:

J.D.L. MULL FARMS

Orig. Lot 88	City of	Date MAR 9, '89 Scale 1"=200'
Orig. Sec	Village of	Dwn. by R.G.S. Chkd. by C.J.
Tract	County of LORAIN	Job No. 89-1795 F.B.
Township of PITTSFIELD	State of OHIO	Printed

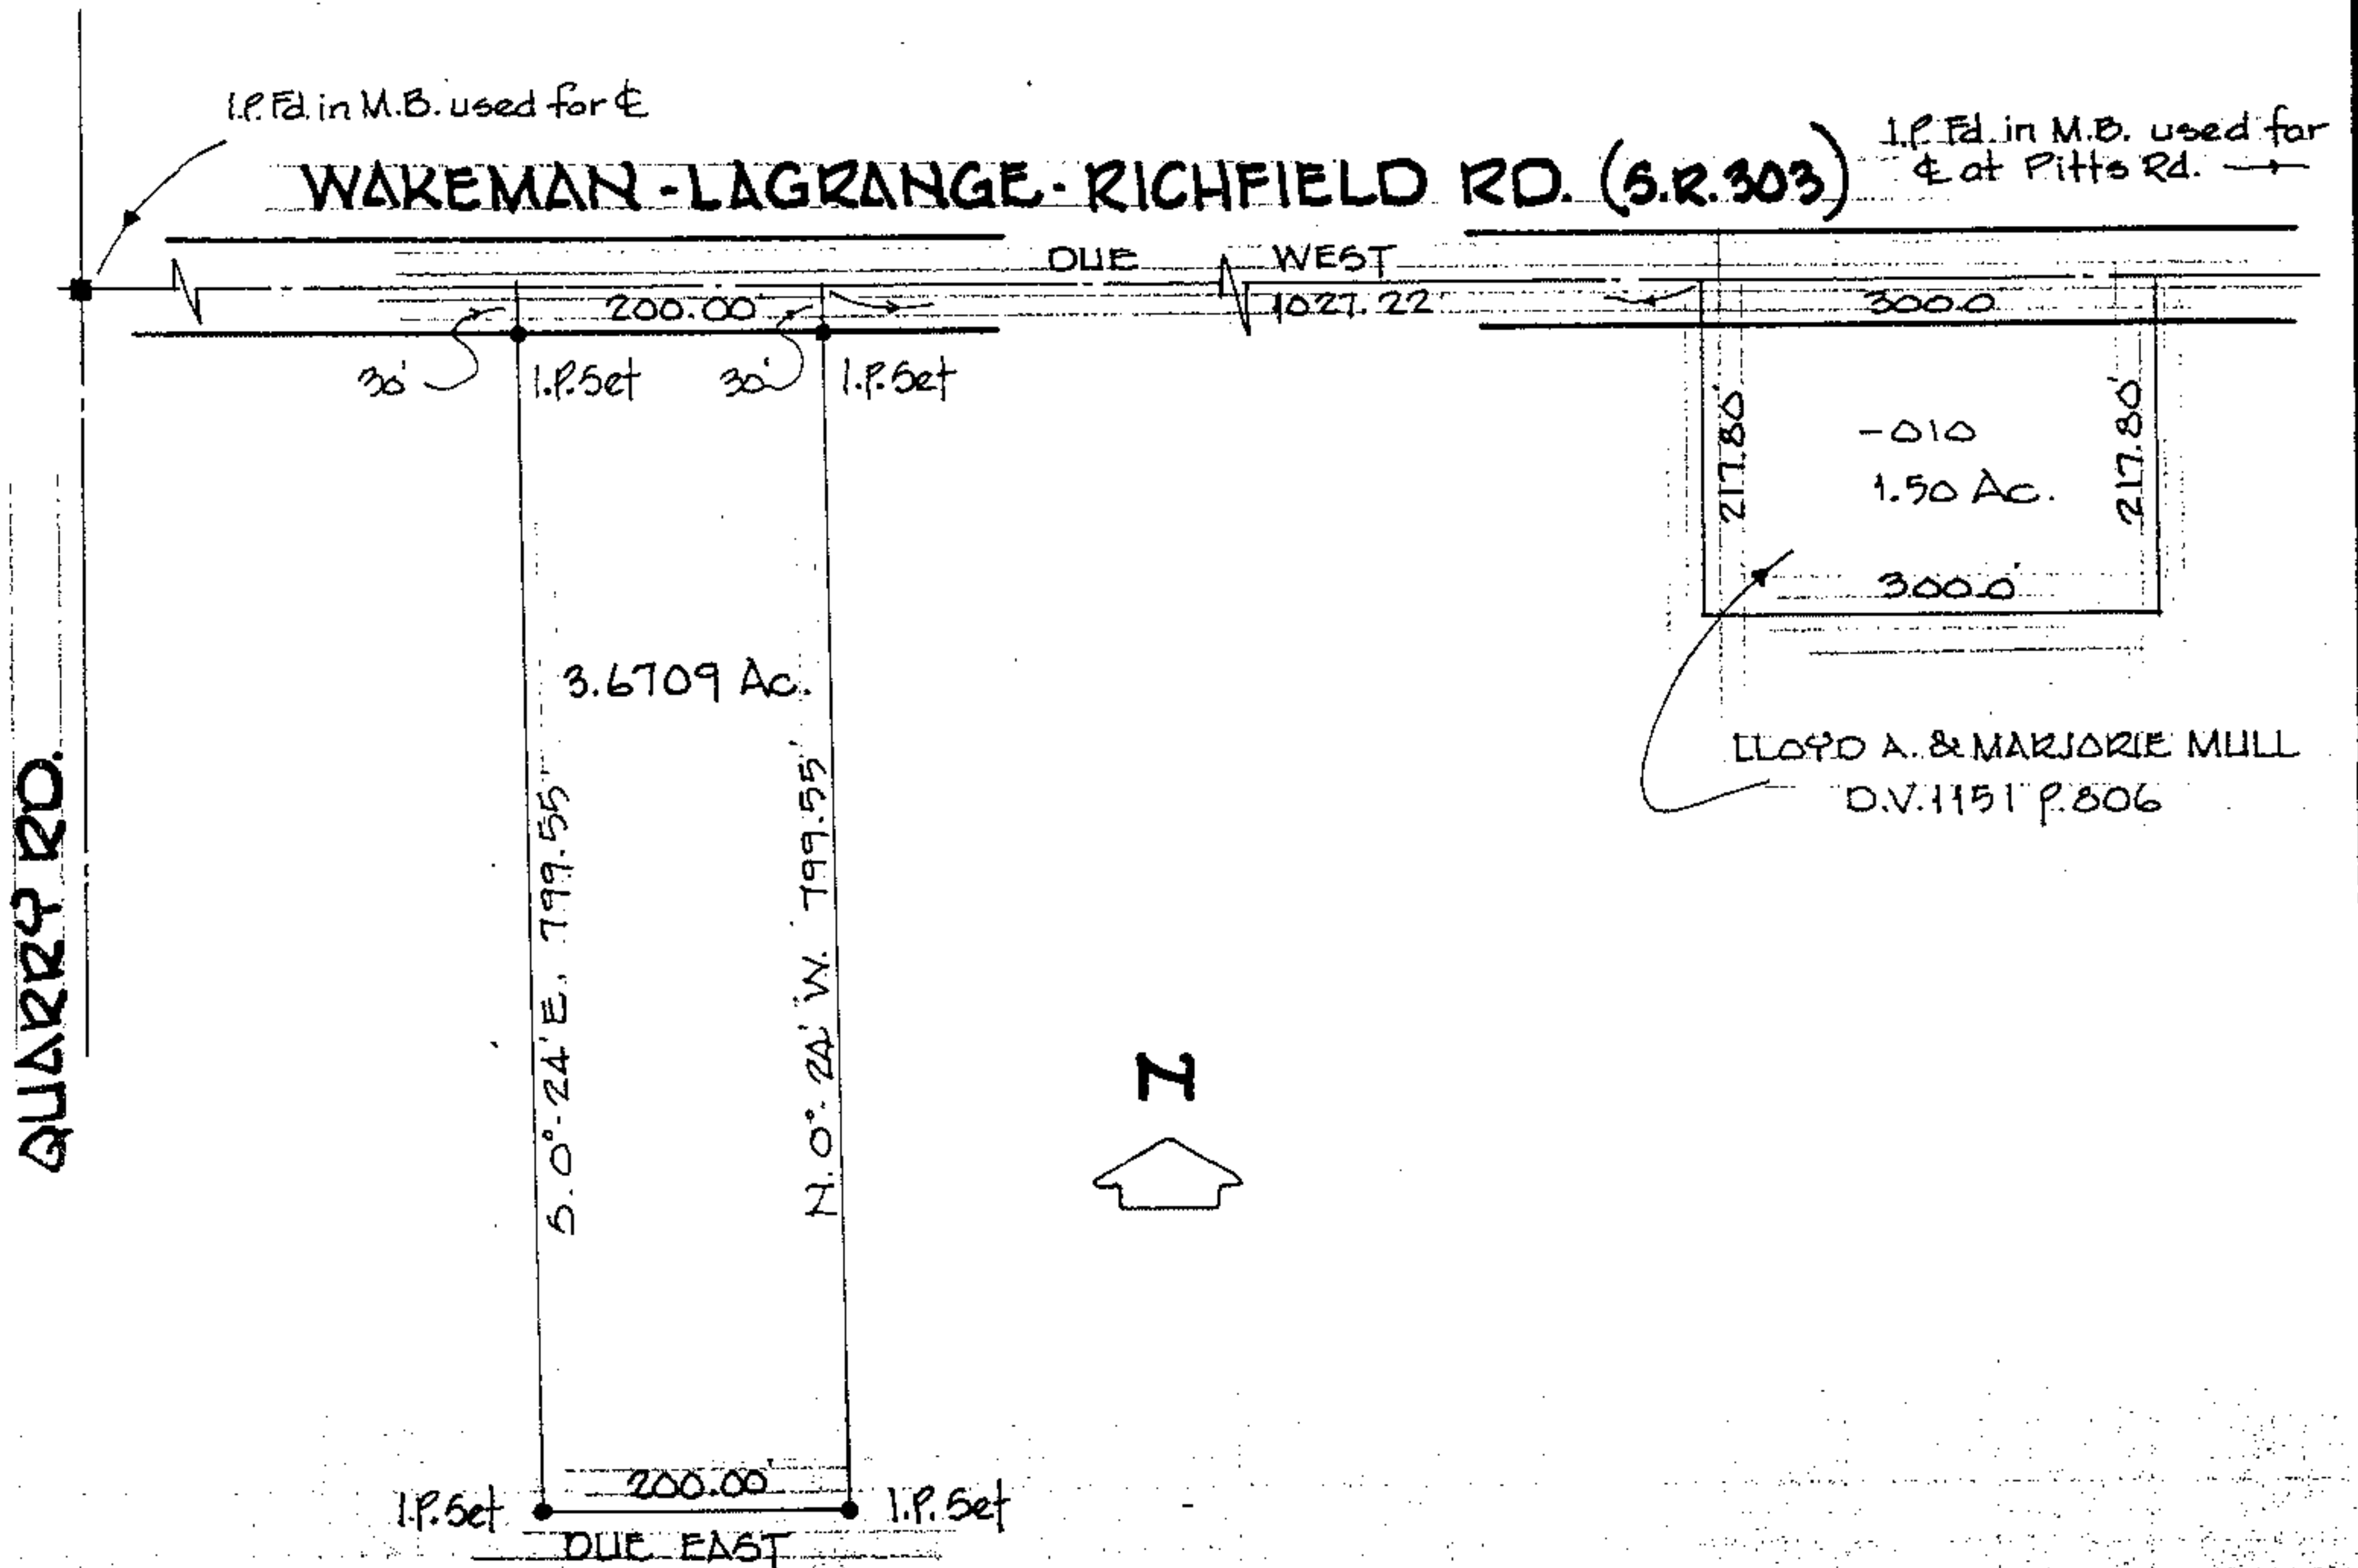

LLOYD A. & MARJORIE MULL
D.V. 1151 P. 806

J.D.L. MULL FARMS

D.V. 1265 P. 529

Rmldr. 73.09 Ac. calc.