

#44952

16-00-059-000-004  
005



LAUNDON · SIMON · CAHL & ASSOC. INC.  
CONSULTING ENGINEERS & SURVEYORS  
219 COURT ST. ELYRIA, OHIO 44035


SURVEY FOR:

16-E

KEVIN PATES

Orig. Lot 59	City of	Date JUNE 3, 88 Scale 1"=200'
Orig. Sec	Village of	Dwn. by R.G.S. Chkd. by C.J.
Tract	County of LORAIN	Job No. 88-4715 F.B.
Township of GRAFTON	State of OHIO	Printed

V. 458 P. 167

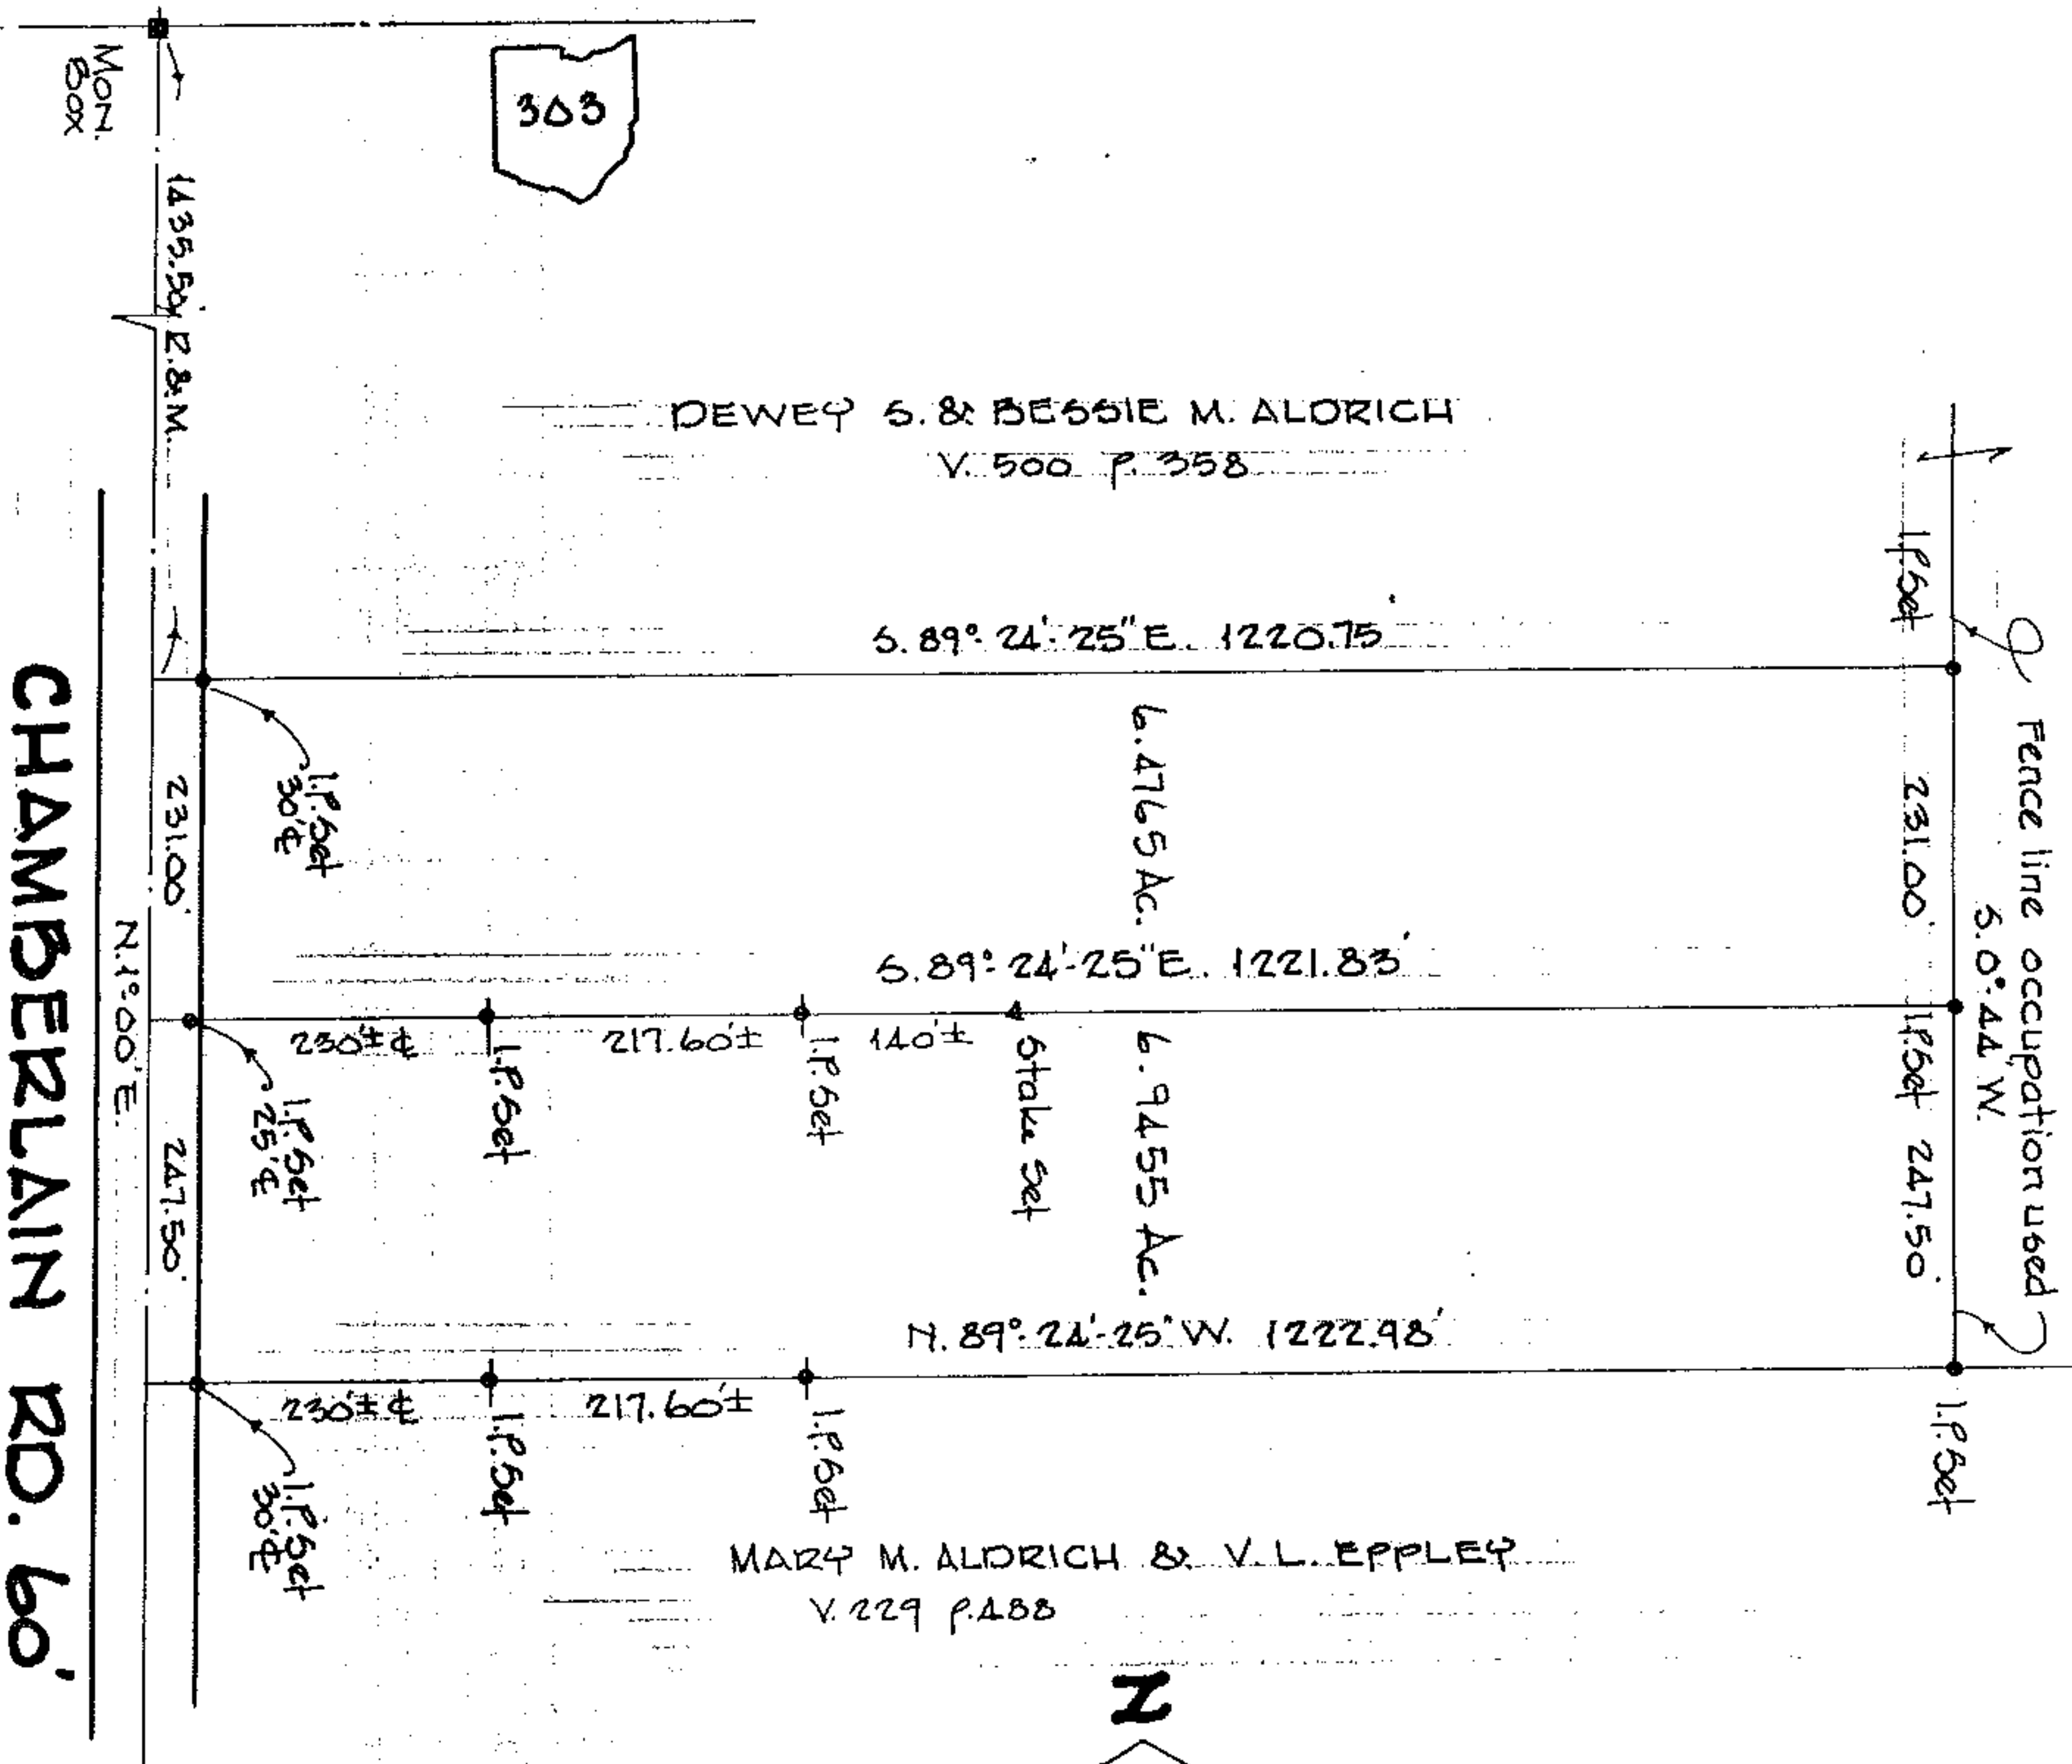

CHAMBERLAIN RD. 60'