


Plat of Survey
Mike Ritsko

Carlsisle Twp. Section 7
Lorain Co. Ohio
October 2008
Carlson Surveys Job: 1002-26

Adjoining owners
-042 Jeffrey N. & Martha Greene
O.R.V. 539 P. 4
-055 Clarence & Martha Gray
V. 1336 P. 249

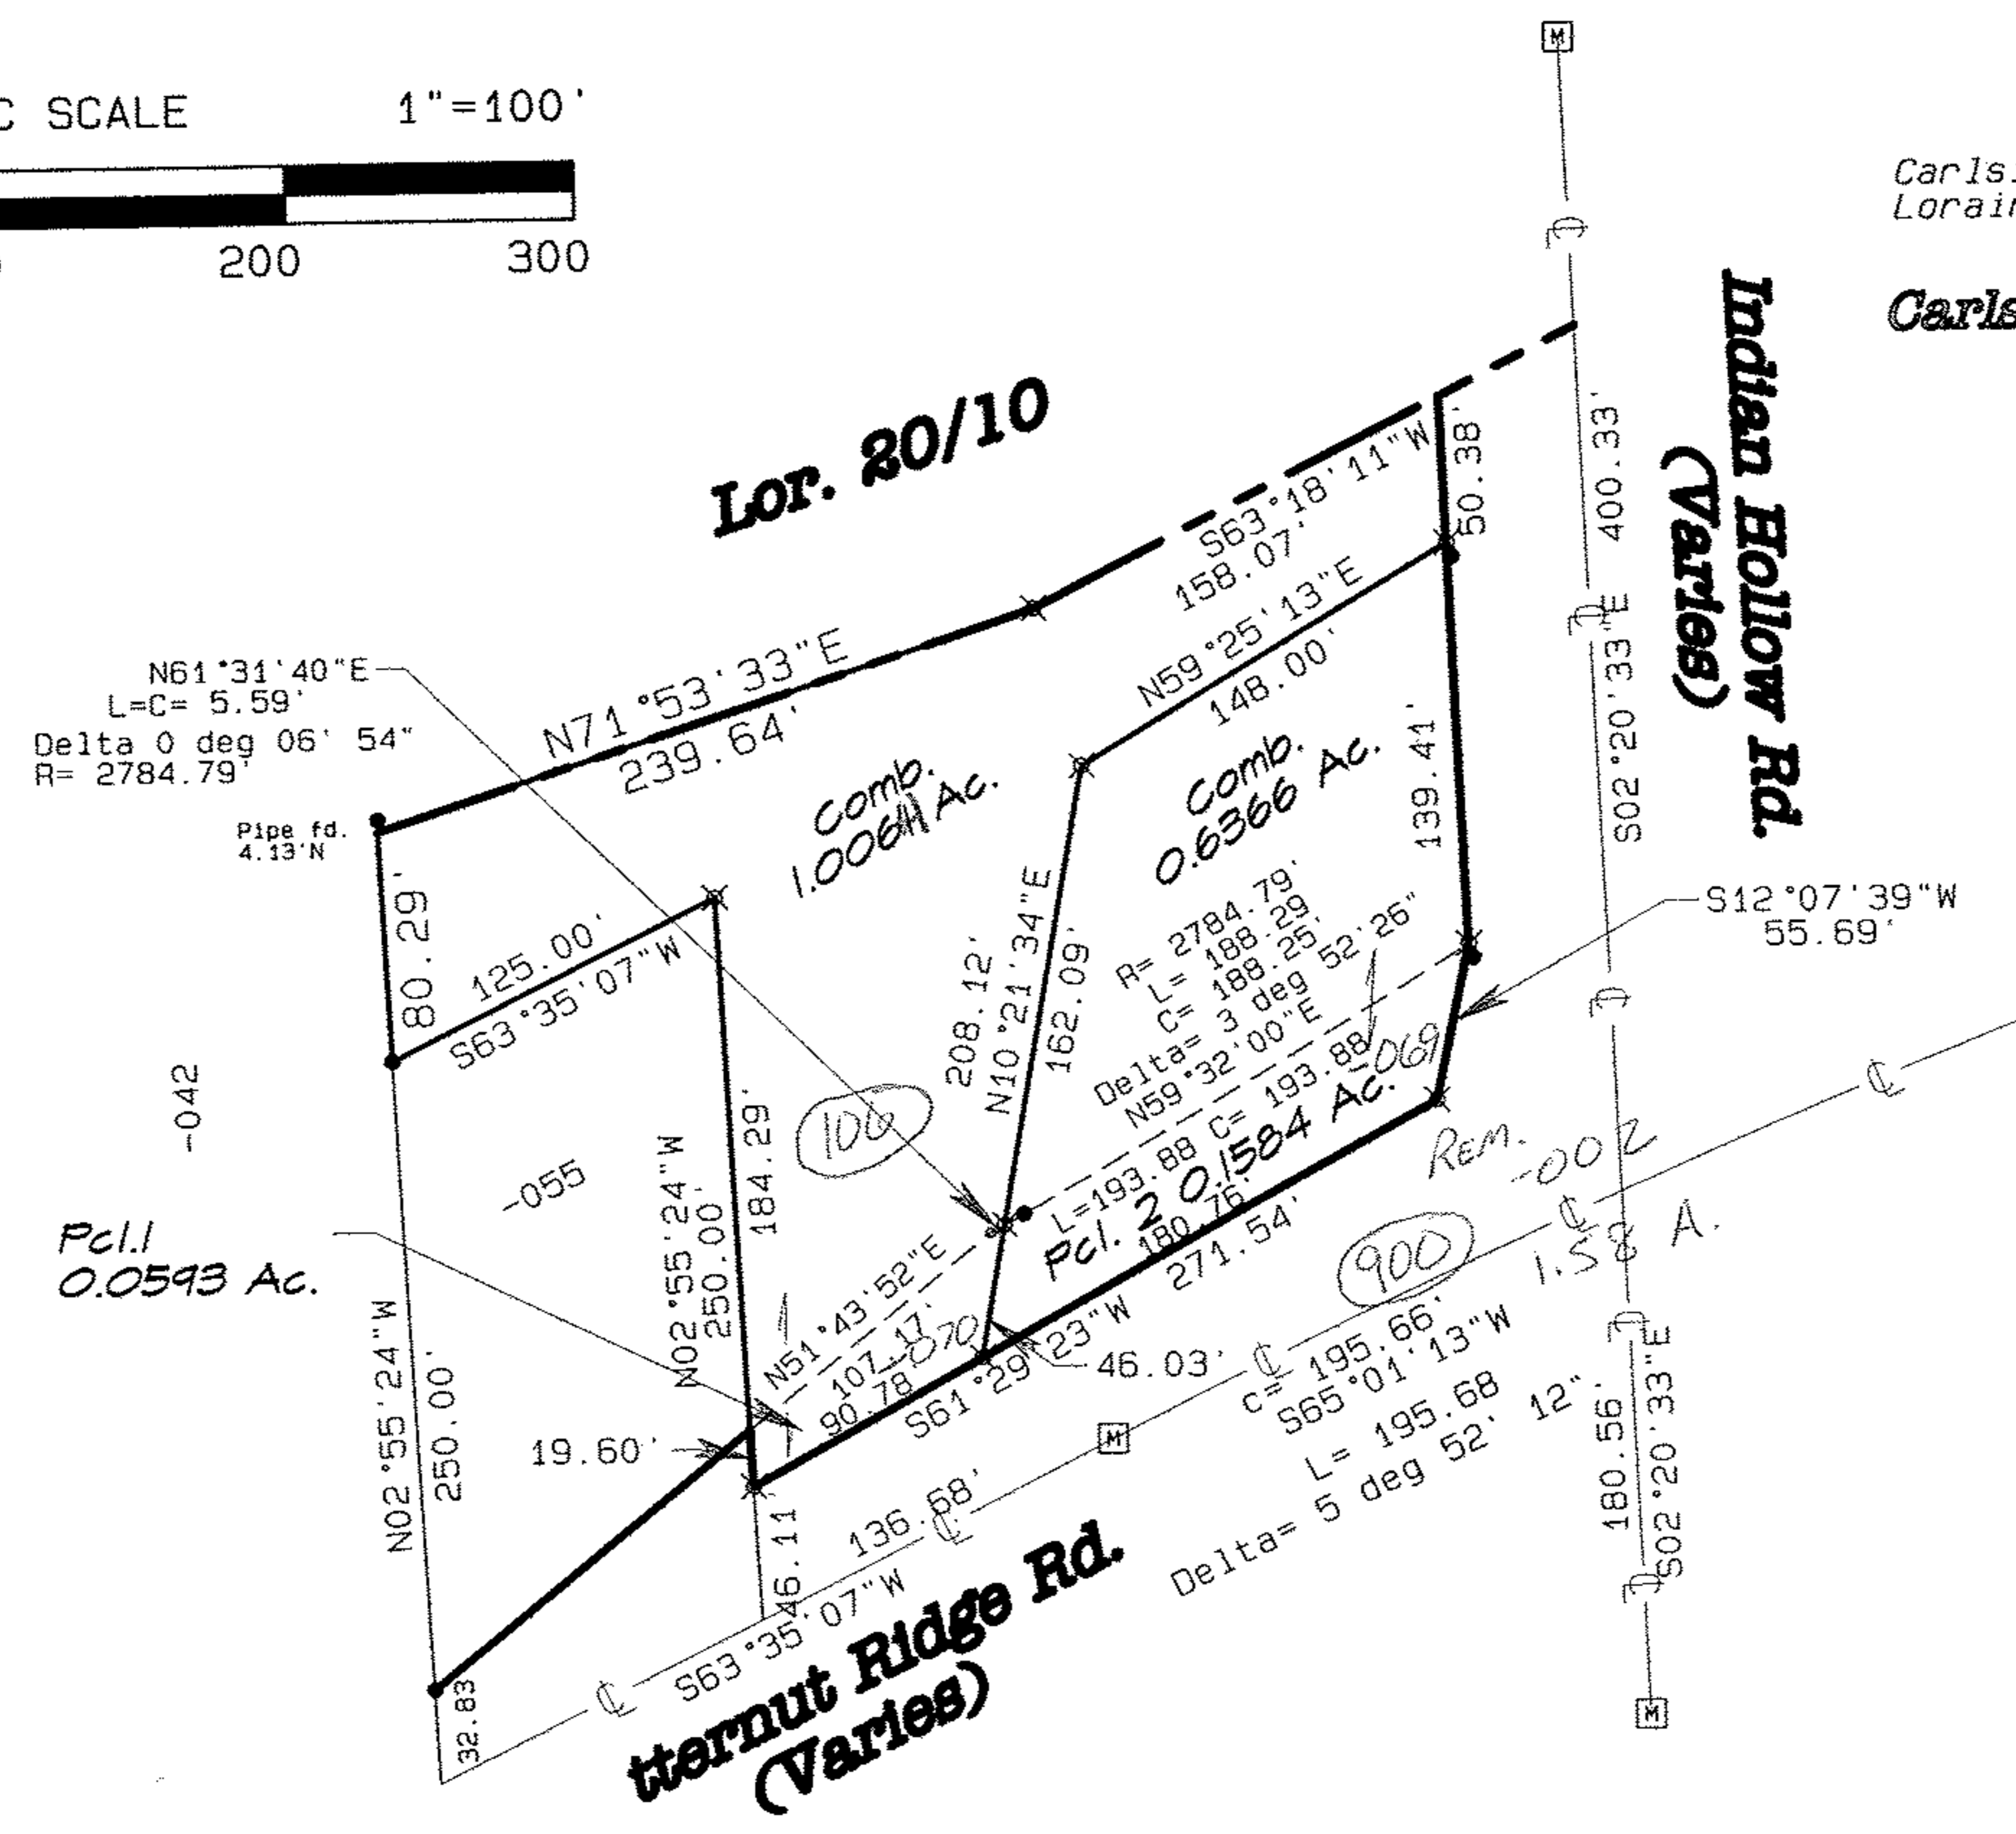

102812
APPROVED
LORAIN CO.
MAP DEPT.
DATE 5/7/10
BY 10-00-007-H
T. SPILLMAN
10-02812

