

MAP OF SURVEY AND LOT SPLIT

PREPARED FOR

LEROY F. AND SHARON M. JORDAN


SITUATED IN THE TOWNSHIP OF PITTSFIELD, COUNTY OF LORAIN, STATE OF OHIO AND BEING KNOWN AS PART OF ORIGINAL PITTSFIELD TOWNSHIP LOT 66 AND 73



100' 0' 100' 200'
SCALE: 1" = 100'

J.O.L. MULL FIELDS
P.P.#14-00-068-000-002
VOL.1265 PG.529

APPROVED
LORAIN CO.
MAP DEPT
DATE 9-13-10
PAGE 14-B
BY R. MAINES
#ID 02091A
14-00-068-000-013
SCAN # 45038

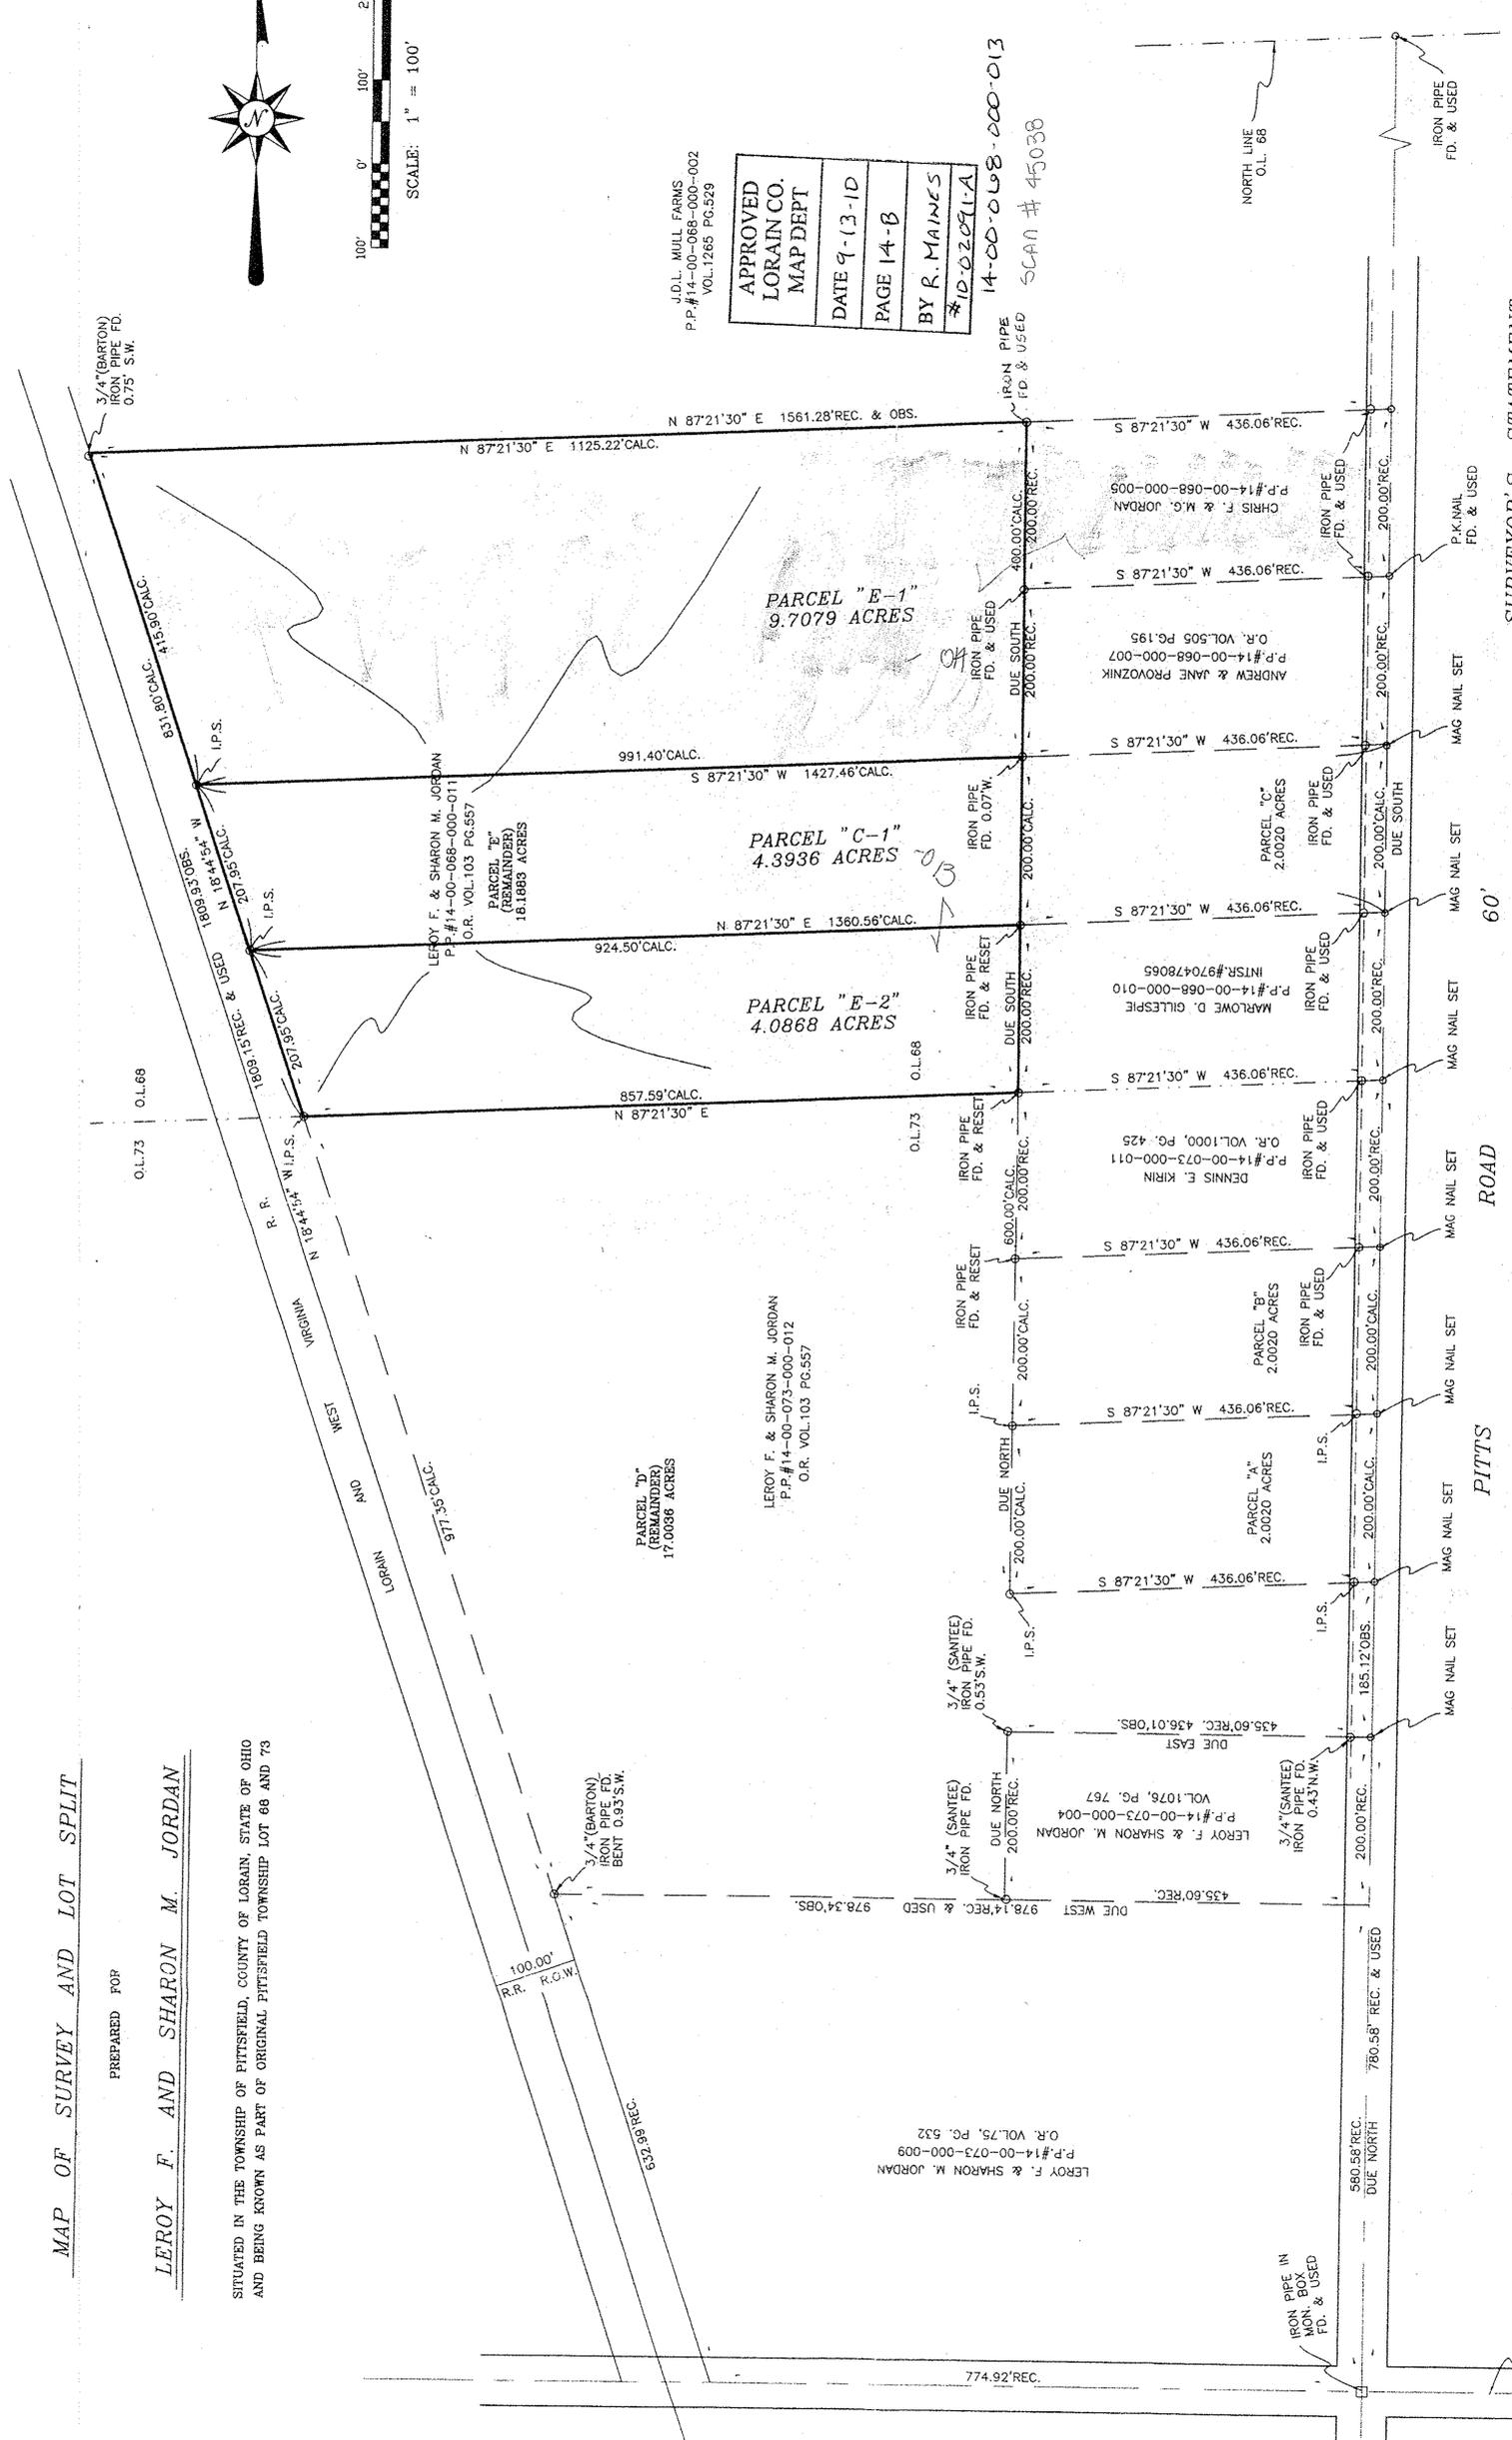

NOTE:
ALL IRON PINS SET ALONG THE WEST SIDE OF PITTS ROAD WERE SET AT 25.00' FROM THE CENTERLINE OF SAID ROADWAY CONSISTENT WITH ALL EXISTING IRON PINS AND PIPES FOUND.

SURVEYOR'S STATEMENT

DISTANCES ARE EXPRESSED IN FEET AND DECIMAL PARTS THEREOF. BEARINGS ARE TO AN ASSUMED MERIDIAN AND ARE USED TO INDICATE ANGLES ONLY. PERMANENT MONUMENTS WERE FOUND OR SET AS INDICATED HEREON. 0— I.P.S. INDICATES A 5/8" IRON PIN WITH CAP SET. ALL OF WHICH I DECLARE TO BE CORRECT TO THE BEST OF MY ABILITIES AND BELIEFS.



DATE 11-22-10

THOMAS M. SNEZEK, R.L.S. #77051

000997
APPROVED
LORAIN CO.
MAP DEPT
DATE 3-1-02
PAGE 14-B
BY J.HATFIELD
#02-00997