


02-00-051-103-062

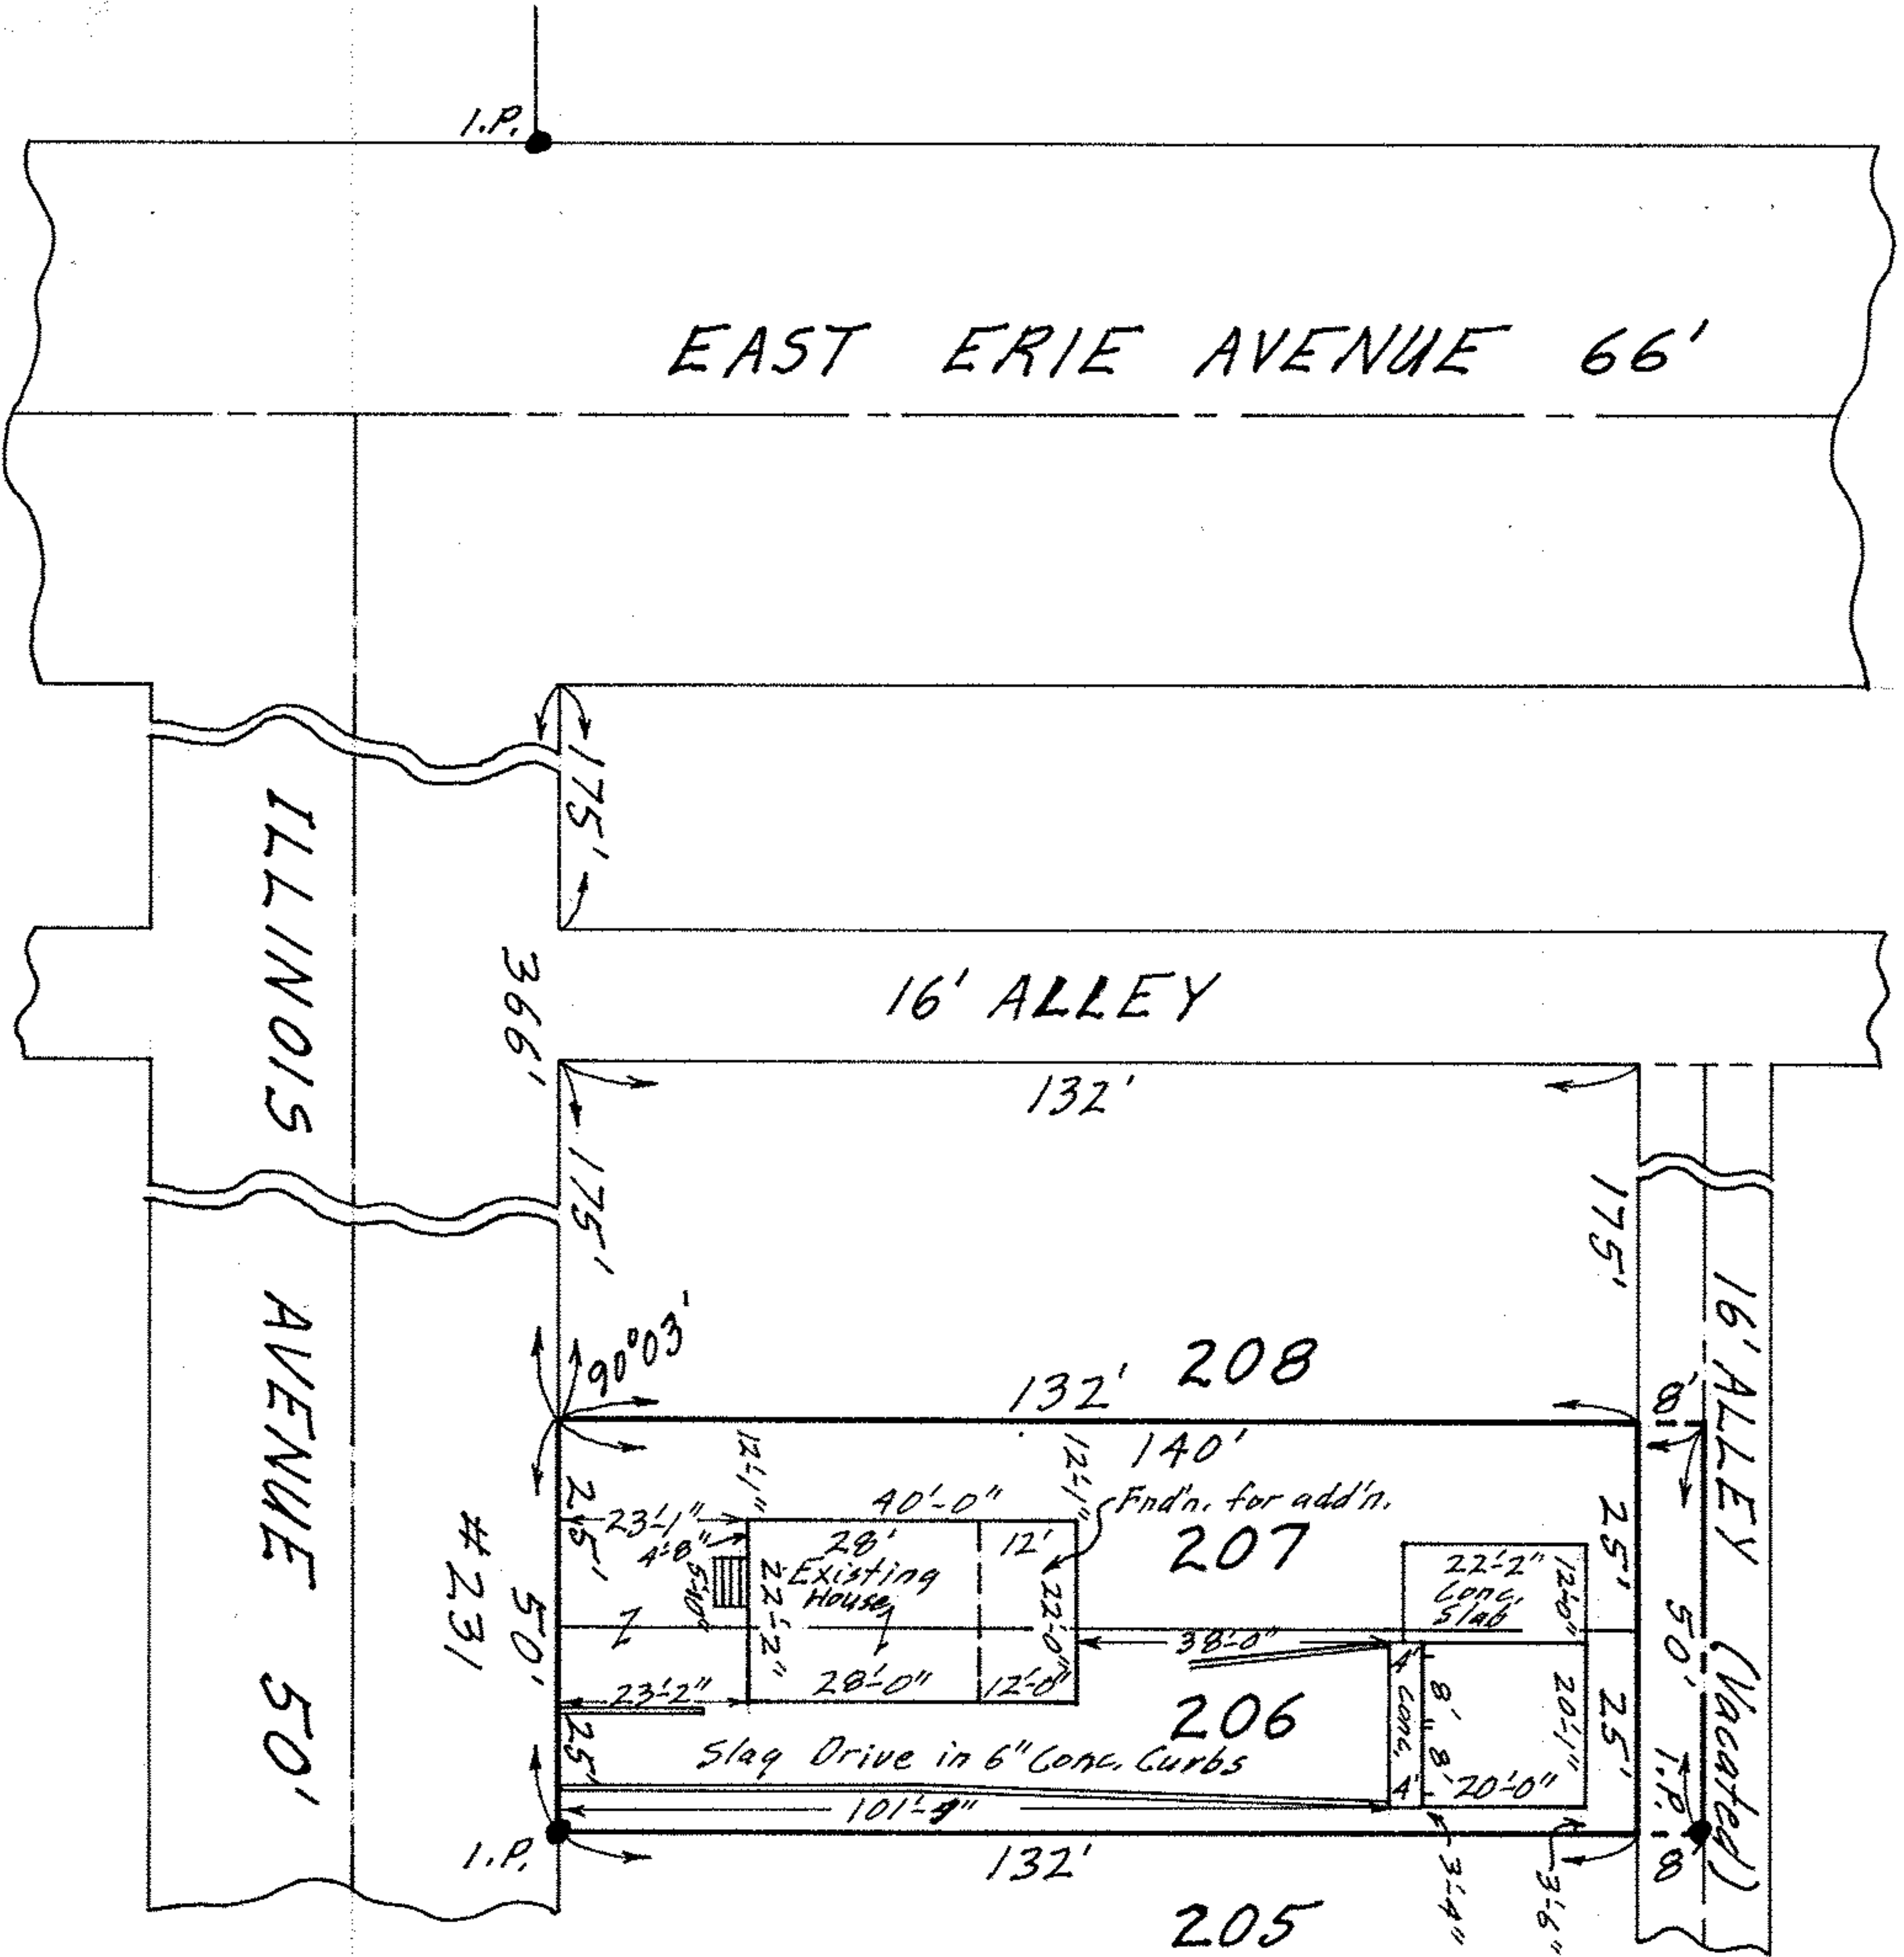

MAP OF SUB-LOTS NOS. 206 & 207
 C. A. STURTEVANT'S FAIR HOME ALL'T. Vol. 4 Pg. 13
 ORIG. LOT 51 SHEFFIELD TOWNSHIP
 LORAIN CITY - LORAIN COUNTY - OHIO
 SCALE: 1" = 30' SEPT. 15-1967 1:30 P.M.
 Gary E. Penfound REG. SURVEYOR

Fred E. Simmons, Sr. & Emma Simmons

02-00-051