


02-00-051-23-023, 007  
02-00-051-150-00-20

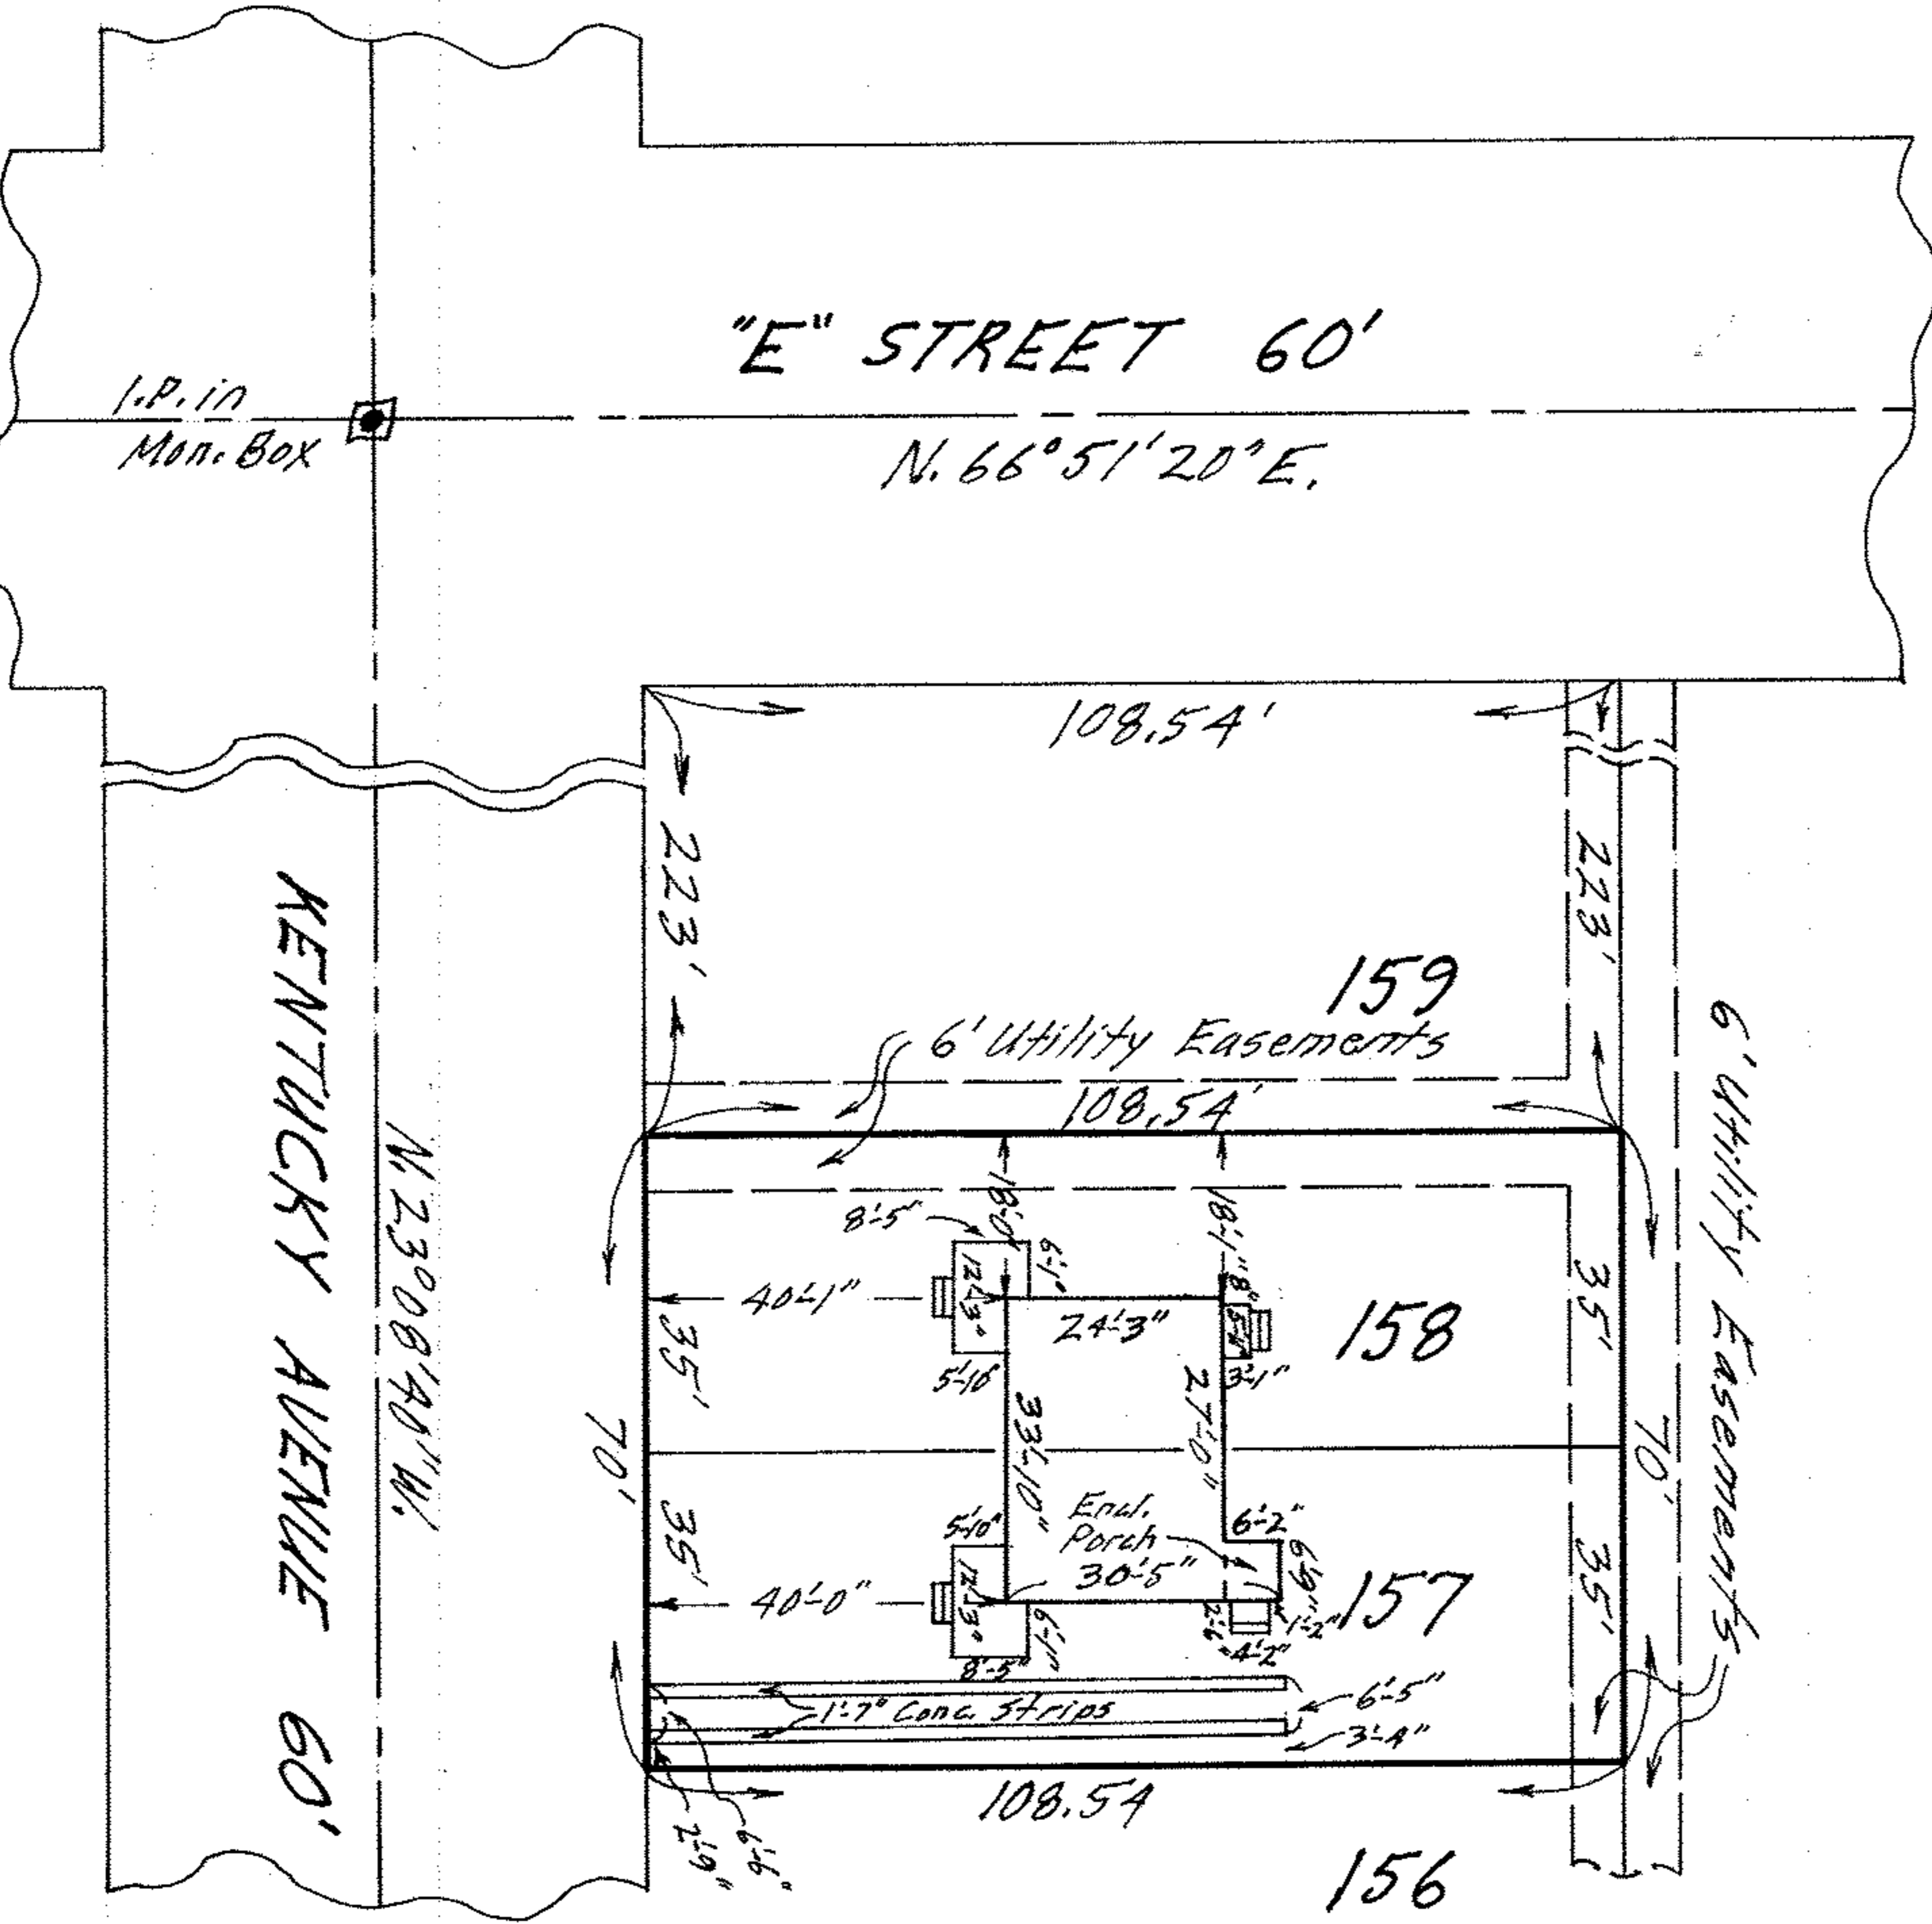

MAP OF SUB-LOTS NOS. 157 & 158

THE FEDERAL HOME BUILDING COMPANY SUB'D.

VOL. 9 PG. 25 PLATS B. R.

ORIG. LOT 51 SHEFFIELD TOWNSHIP

LORAIN CITY - LORAIN COUNTY - OHIO

SCALE: 1" = 30' SEPT. 27-1970 5:00 P.M.

NOTE: There are no encroachments on this property.

Gary E. Penfound REG. SURVEYOR NO. 4457

CITY TITLE Co. Order No. E-1312

Huntz to Maurer

