


02-00-051-135-012  
02-00-051-B

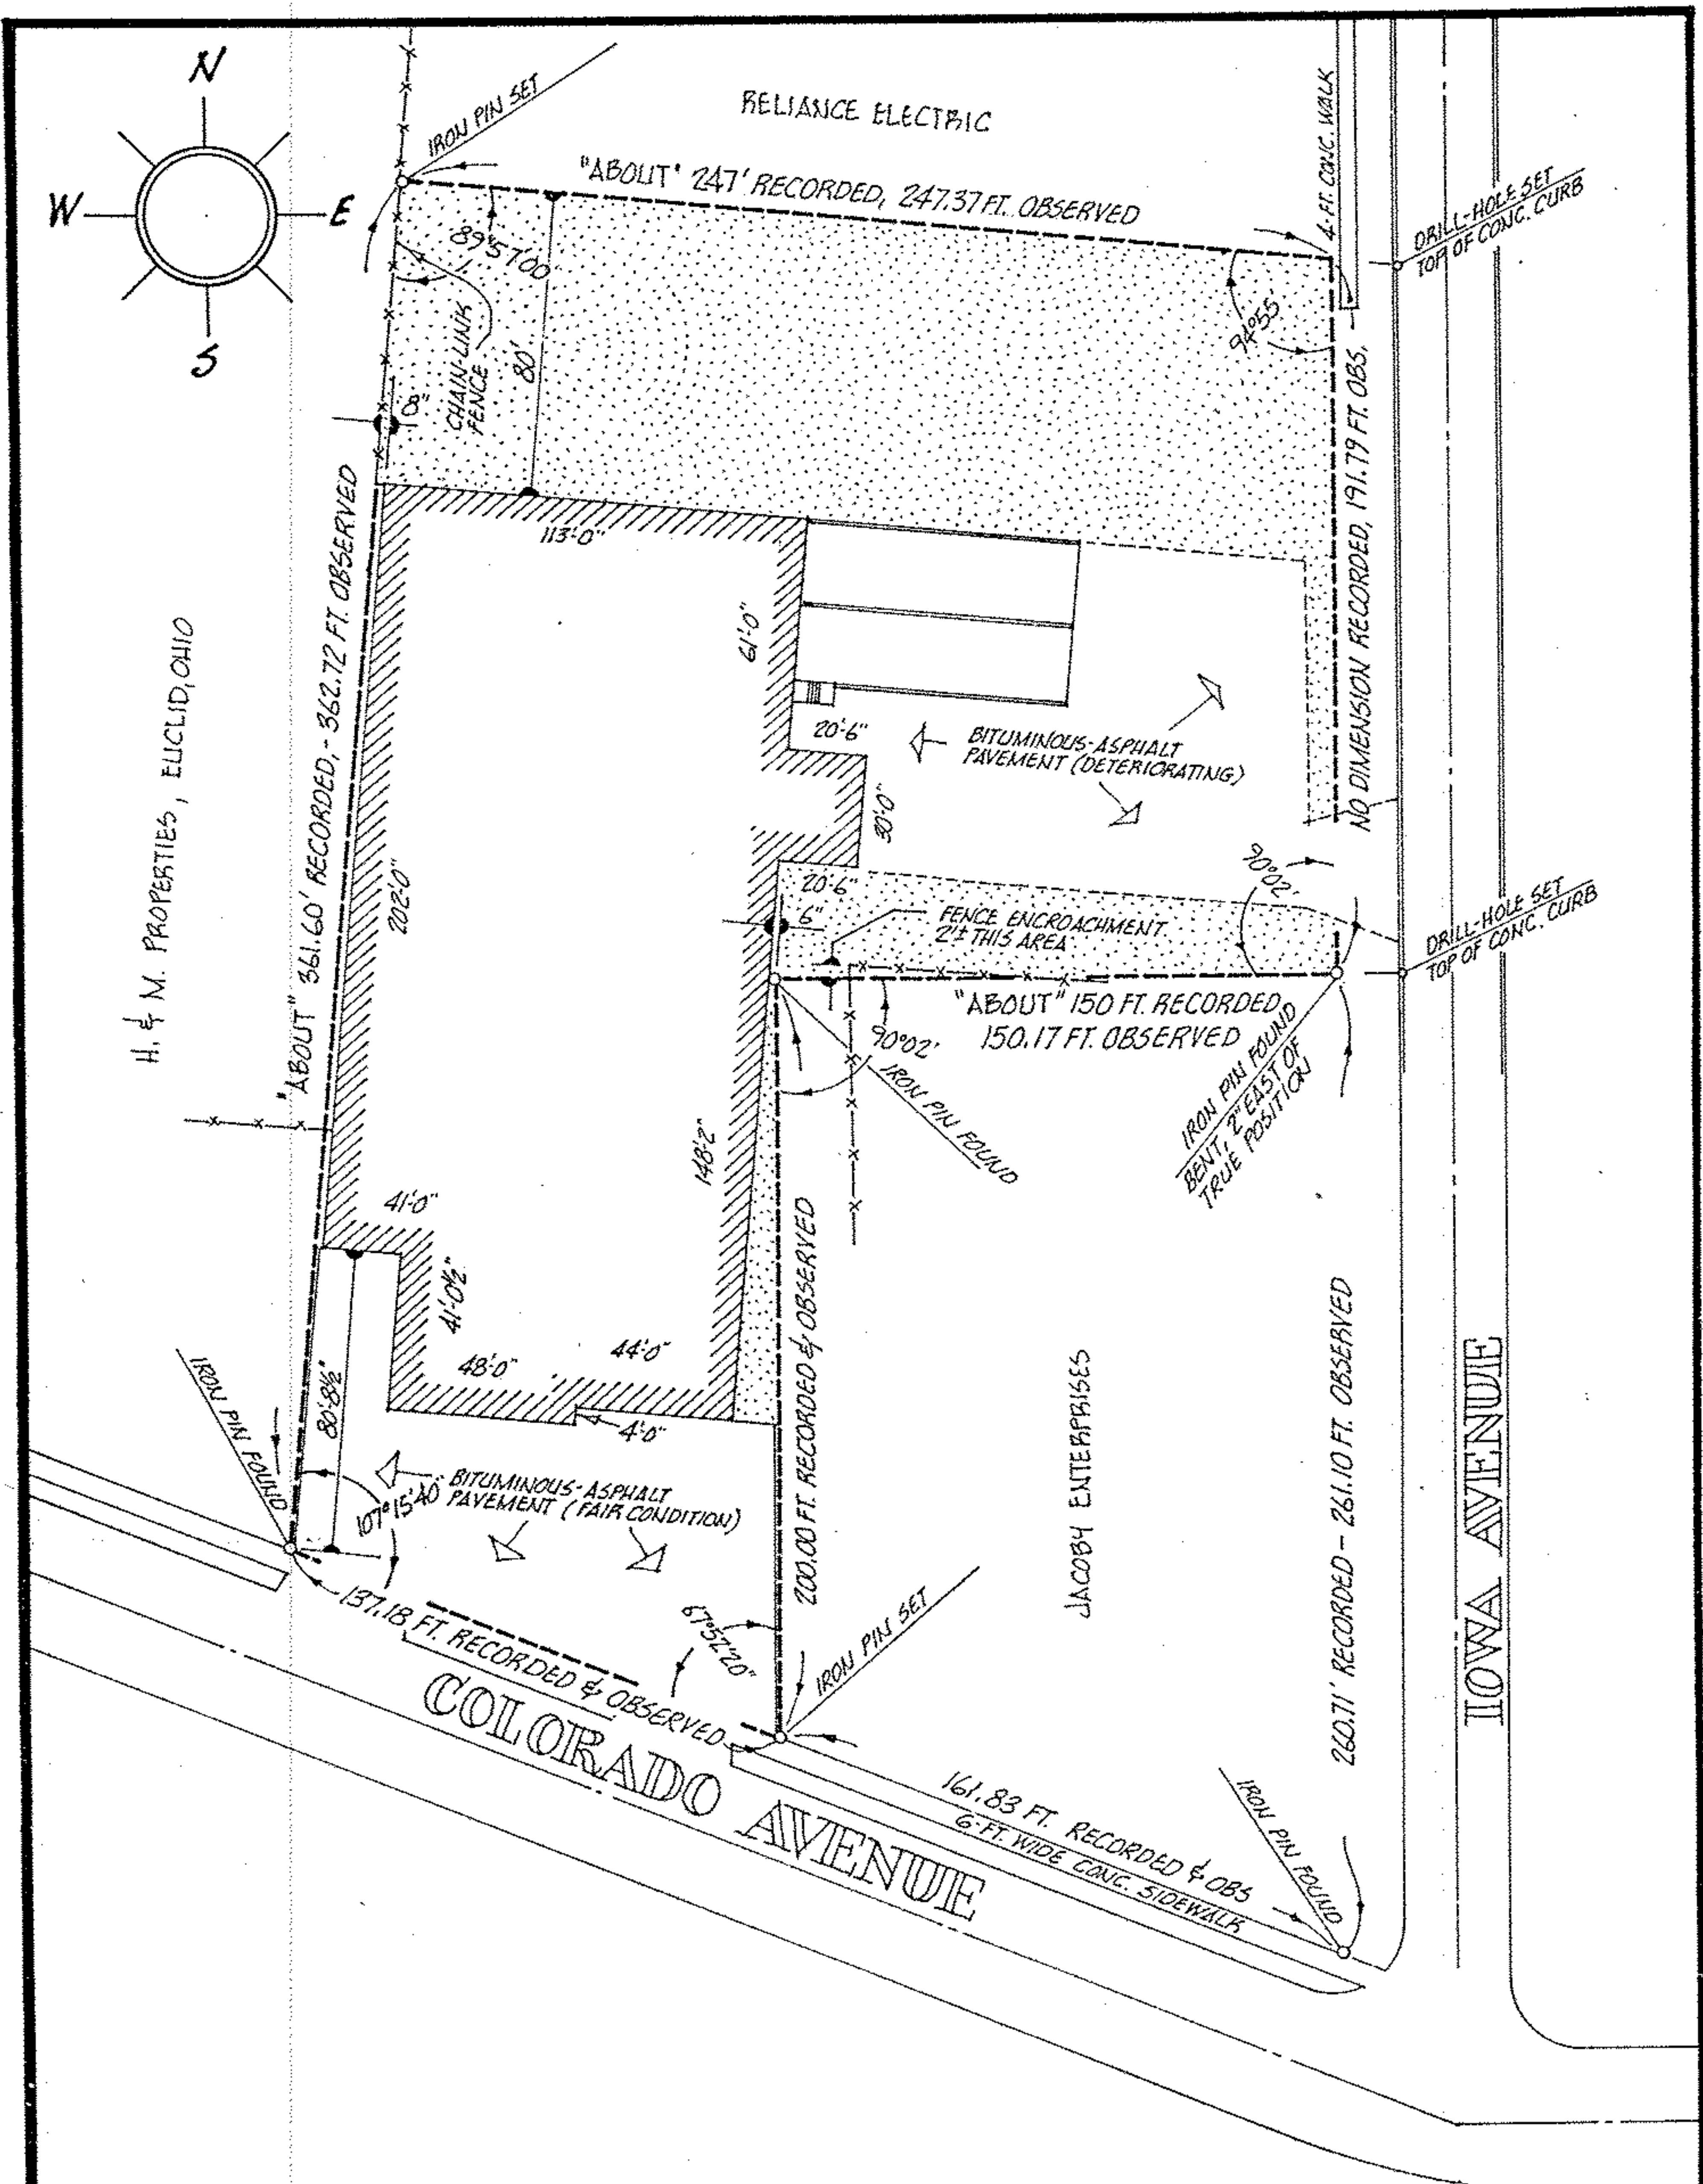

REVISED 6-07-86 - CORRECTED IOWA AVE. FRONTAGE

ACREAGE	1.7031676	PREPARED FOR	RELIANCE ELECTRIC	266-7000
DATE	04-03-86		29325 CHAGRIN BLVD., CLEVELAND, 44122	
DRAWN	MGH	<b>MICHAEL G. HURA, registered surveyor.</b> 12706 MASON RD., VERMILION, O., Ph (216) 965 4040		
SCALE	1" = 60 ft.			
		<b>PERIMETER SURVEY</b>		
		SUBLOT(s) _____ of _____ _____, Volume _____ Page _____ of PLATS		
		PART OF O.L. <u>51</u> TRACT _____ SECTION _____ OF <u>BLACK RIVER</u> TOWNSHIP <u>LORAIN</u> CO., OHIO		
		PERMANENT PARCEL NO <u>02-00-051-135-012</u>		

CITY OF  
LORAIN