


#13010

APPROVED
LORAIN CO.
MAP DEPT.
DATE 8-22-79
<i>Carlyle</i>
02-00-051-B
VOID AFTER 13010

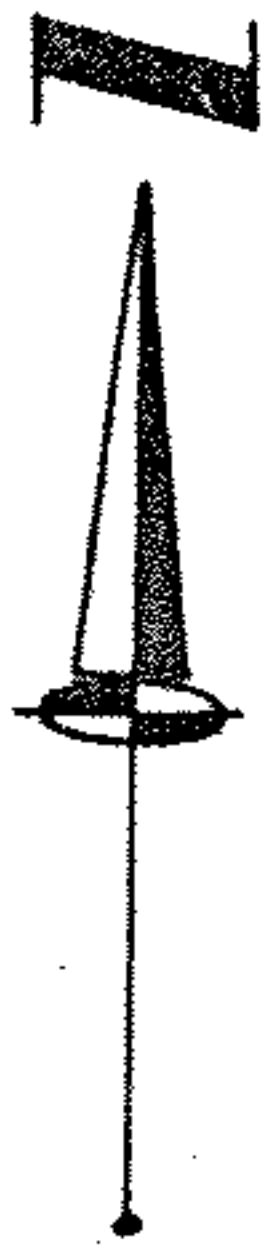

Survey by
Kleinholder
Schmidt

7-7-78


Scale 1" = 60'

P.P.W. 02-00-051-135-013

014

BOUNDARY SURVEY

OF PART OF
BLACK RIVER TOWNSHIP ORIG. LOT 51

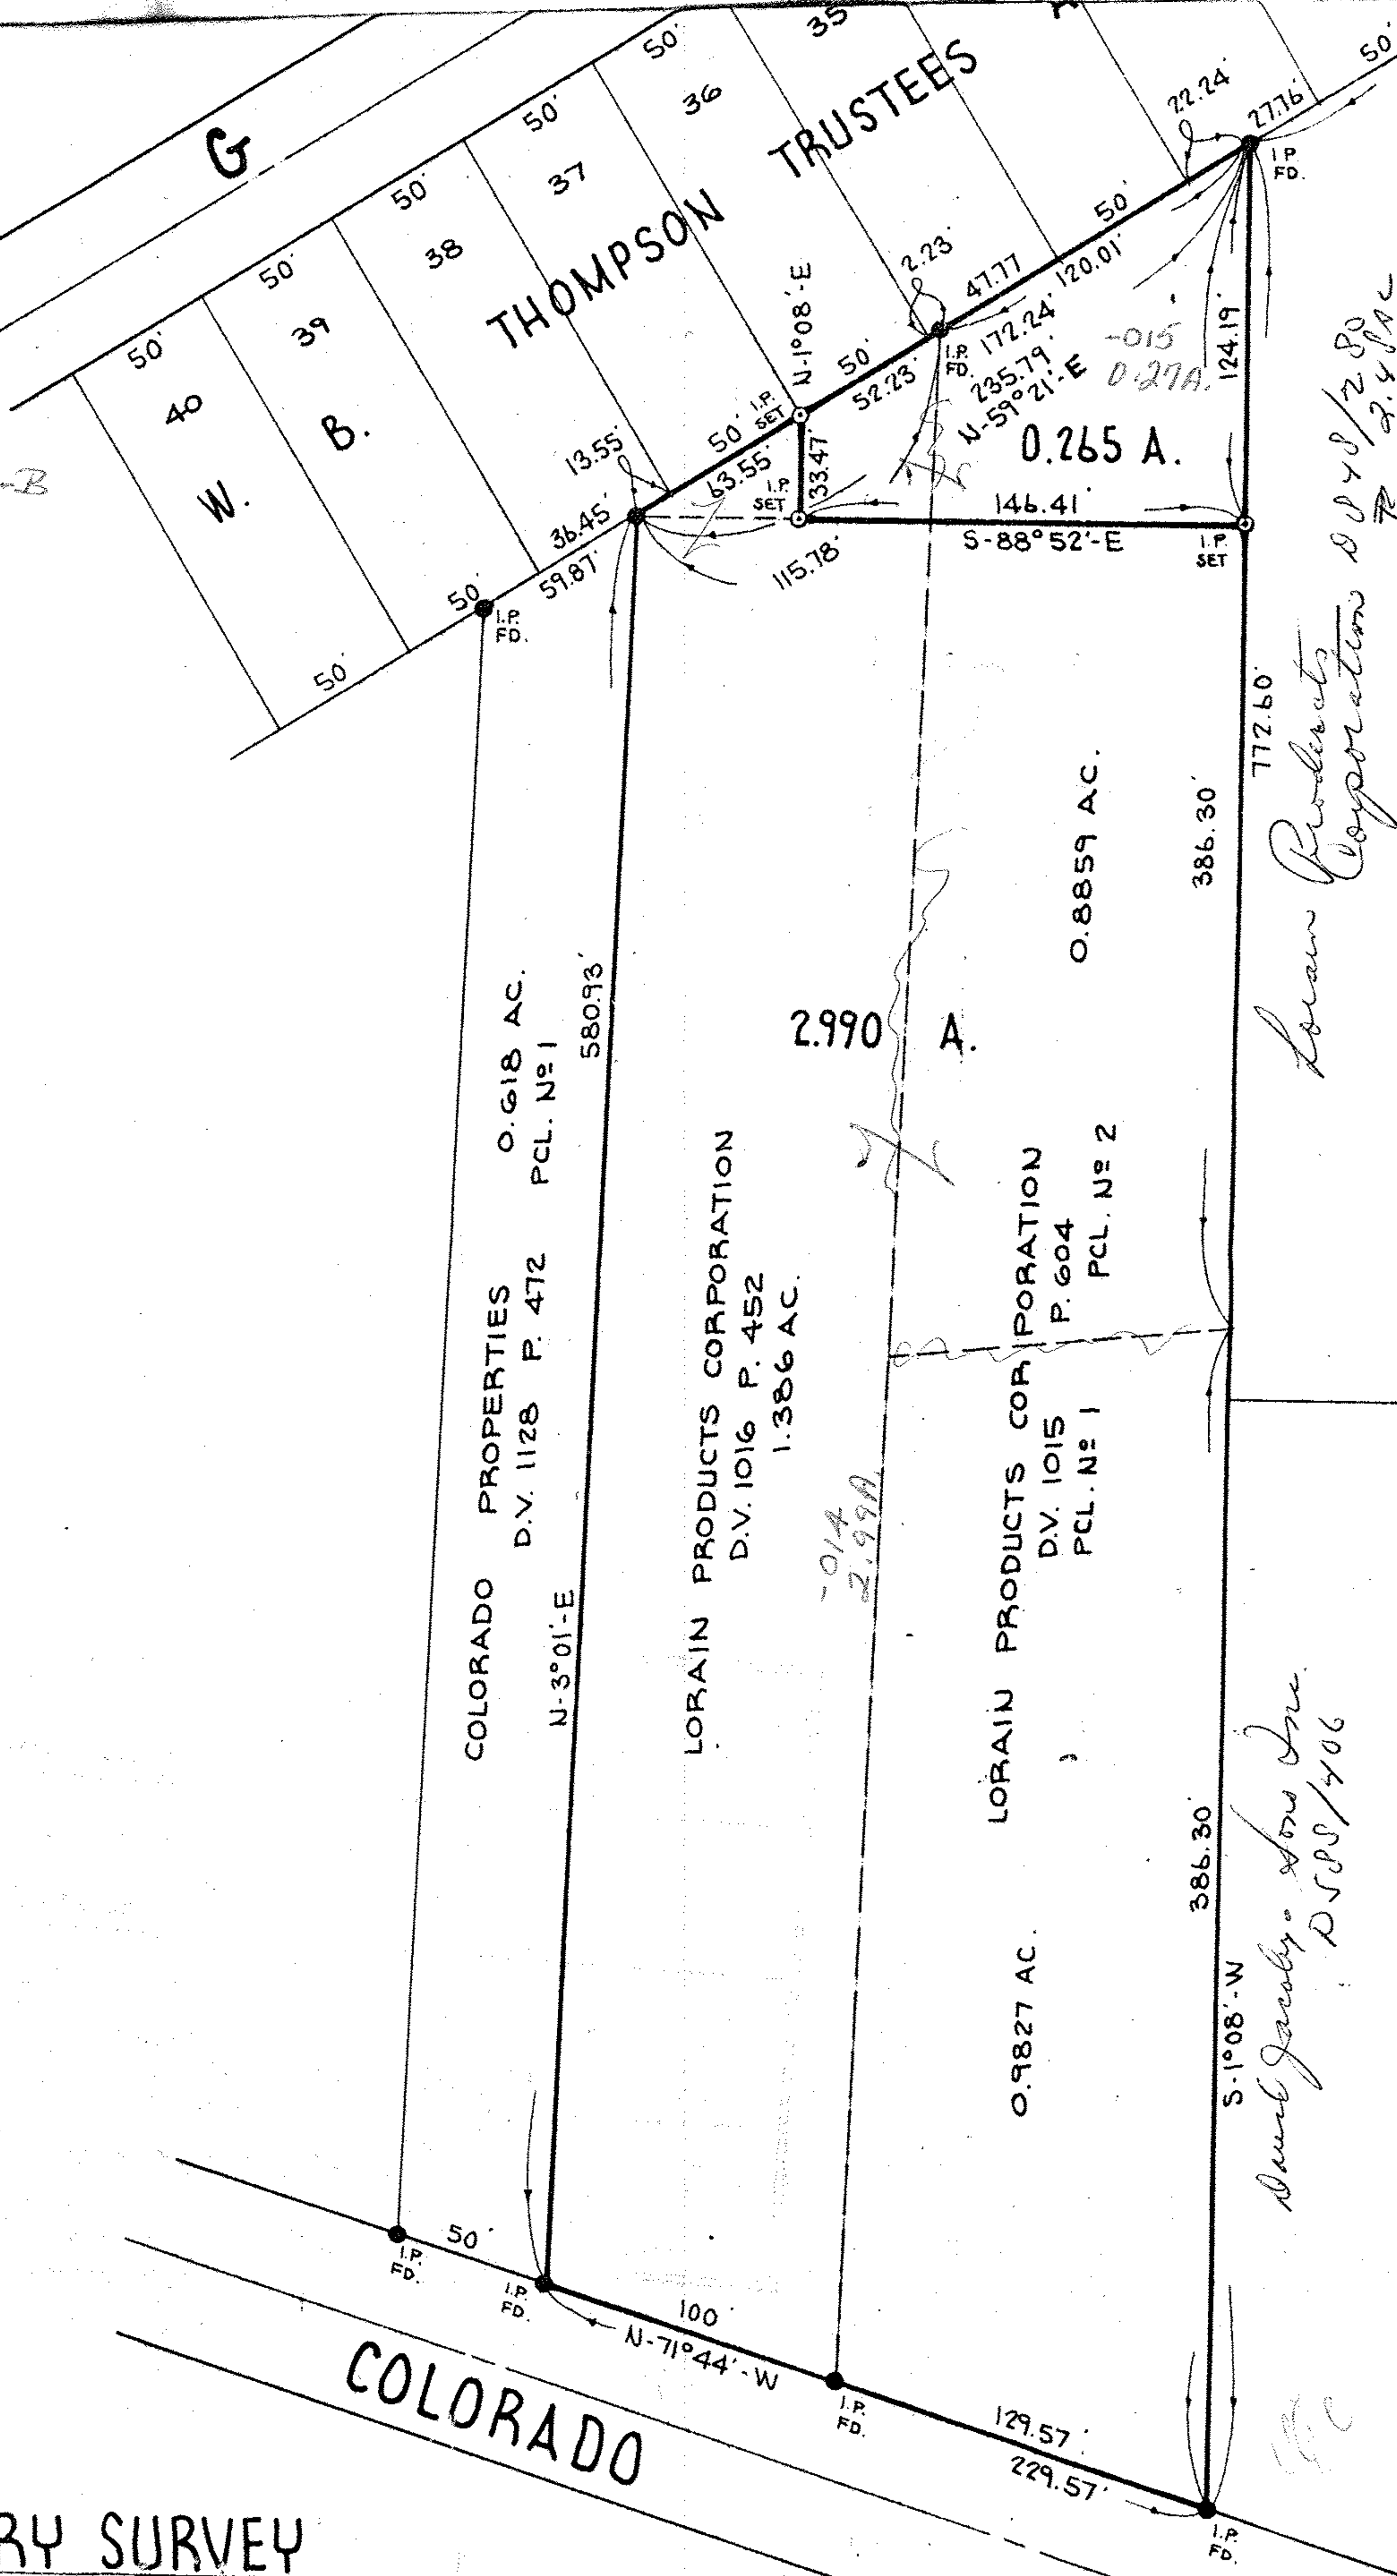

Lorain Products Corporation 02-00-051-135-013

David Jacoby - Son Inc. P. 588/406