


02-00-093-114-011
 02-00-093-B
 SCAN # 45054

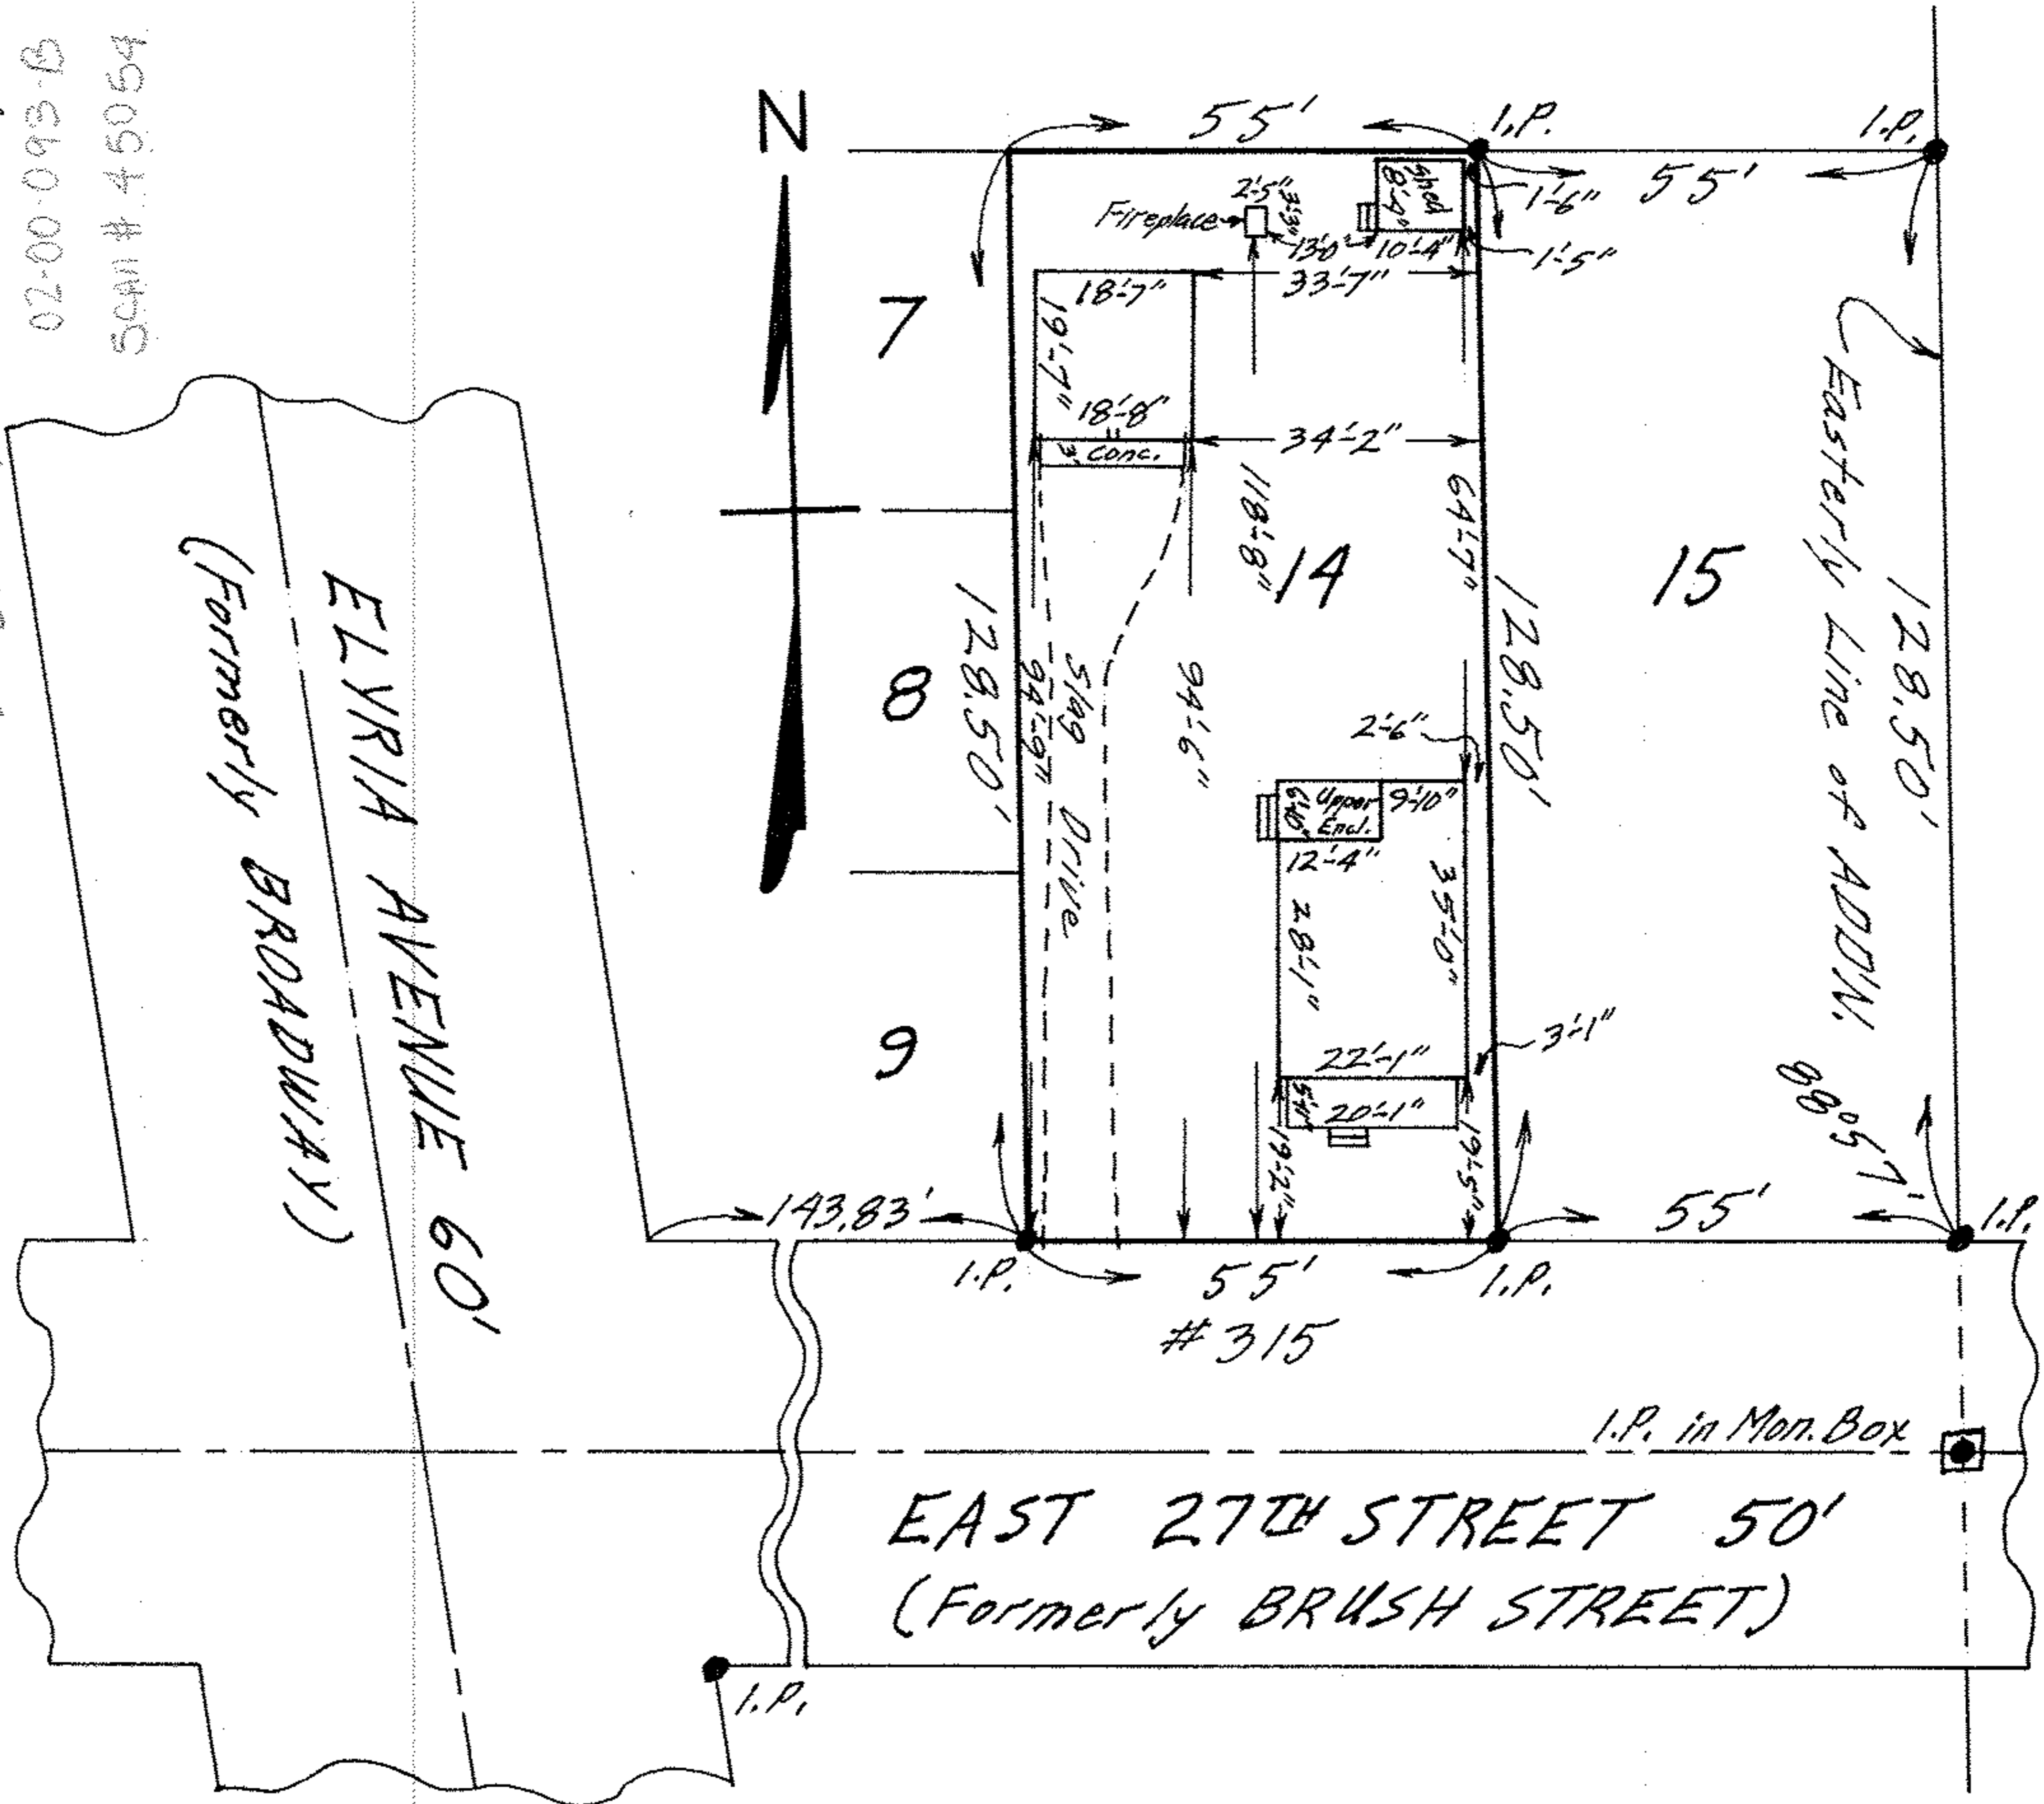

MAP OF SUB-LOT NO. 1A
 WILLIAMS & WOOD'S ADD'N. VOL. 5 Pg. 1A
 ORIG. LOT NO. 93 SHEFFIELD TOWNSHIP
 LORAIN CITY - LORAIN COUNTY - OHIO
 SCALE: 1" = 30' SEPT. 7-1970 6:15 P.M.
 NOTE: There are no encroachments on this property.
 Gary E. Penfound REG. SURVEYOR NO. 4457
 CITY TITLE Co. Order No. E-1272-3
 Chulik to Toledo