


210-11-012
 02-00-00-20
 02-00-00-20
 SCAN # 45056

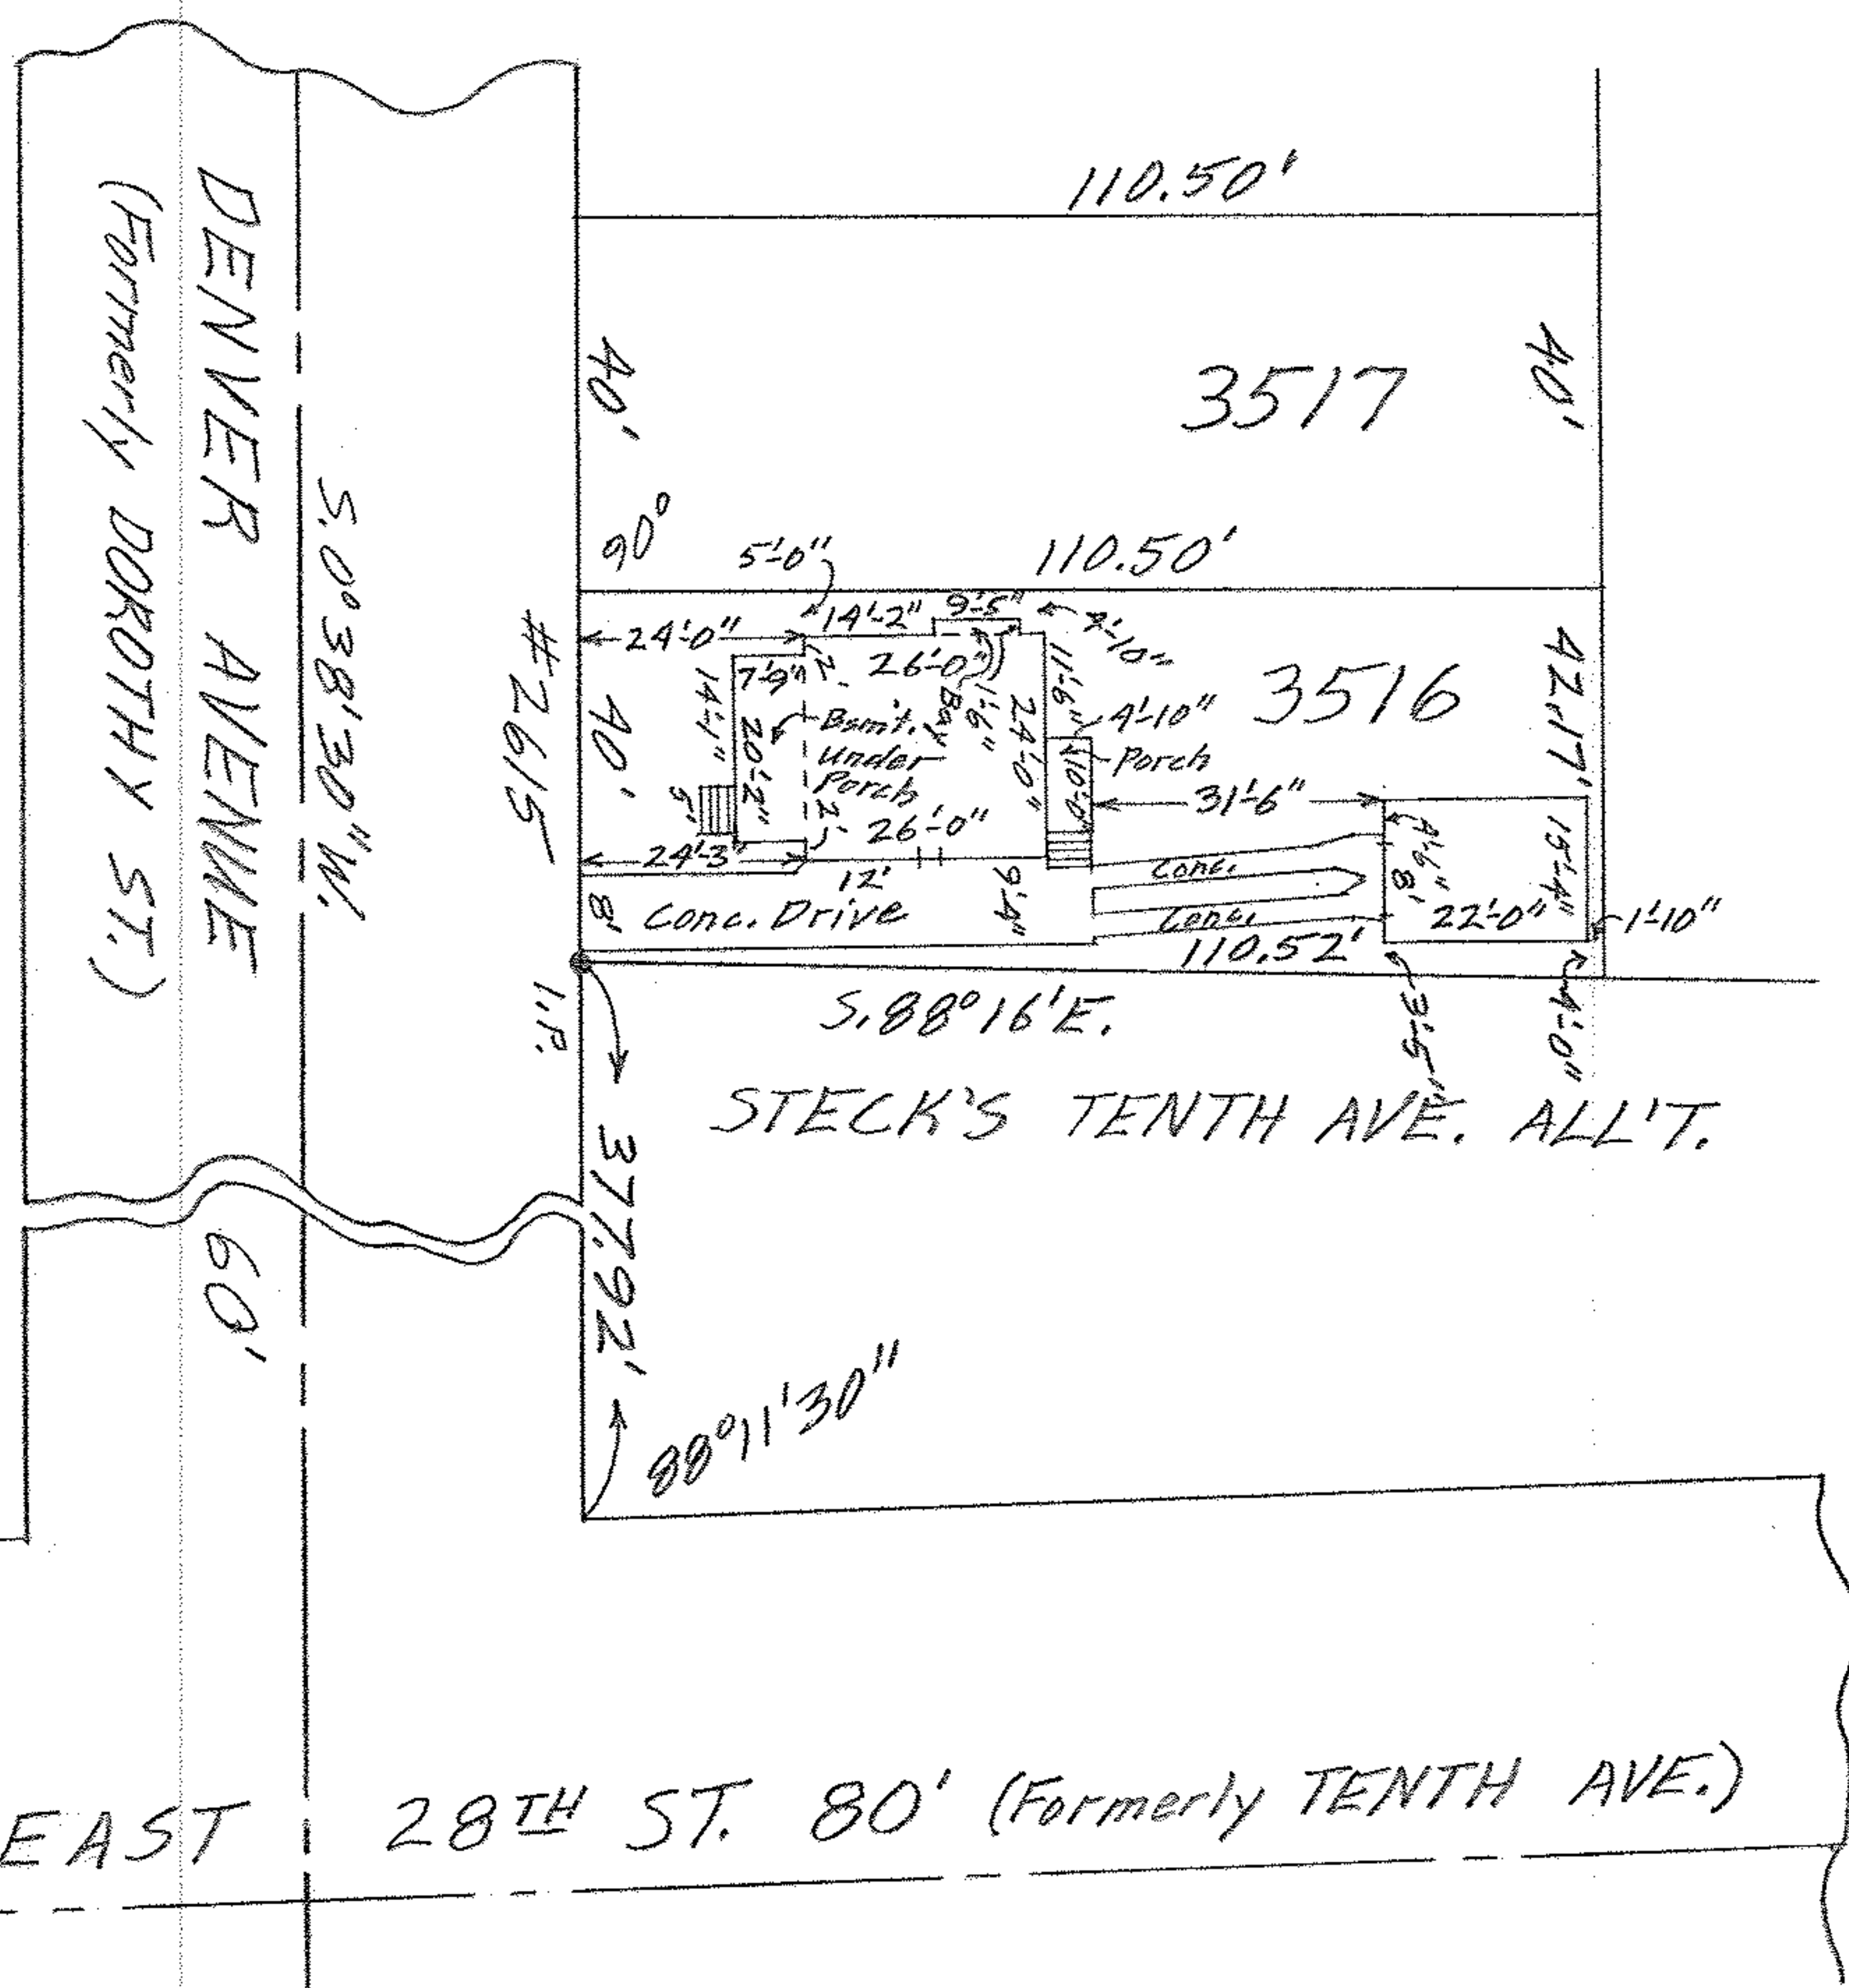

MAP OF SUB-LOT NO. 3516 OF THE SHEFFIELD
 LAND & IMPROVEMENT CO.'S SUB'D. NO. 6 Vol. 6 Pg. 12
 LORAIN CITY LORAIN COUNTY OHIO
 SCALE: 1" = 30' SEPT. 23-1964 5:45 P.M.
 Gary E. Penfound REG. SURVEYOR

Angel & Mary Hurtado