


02-01-003-102-009  
02-01-003-B

Scan# 45063 W

GEORGIA AVENUE 40'

EAST ERIE AVENUE 66'

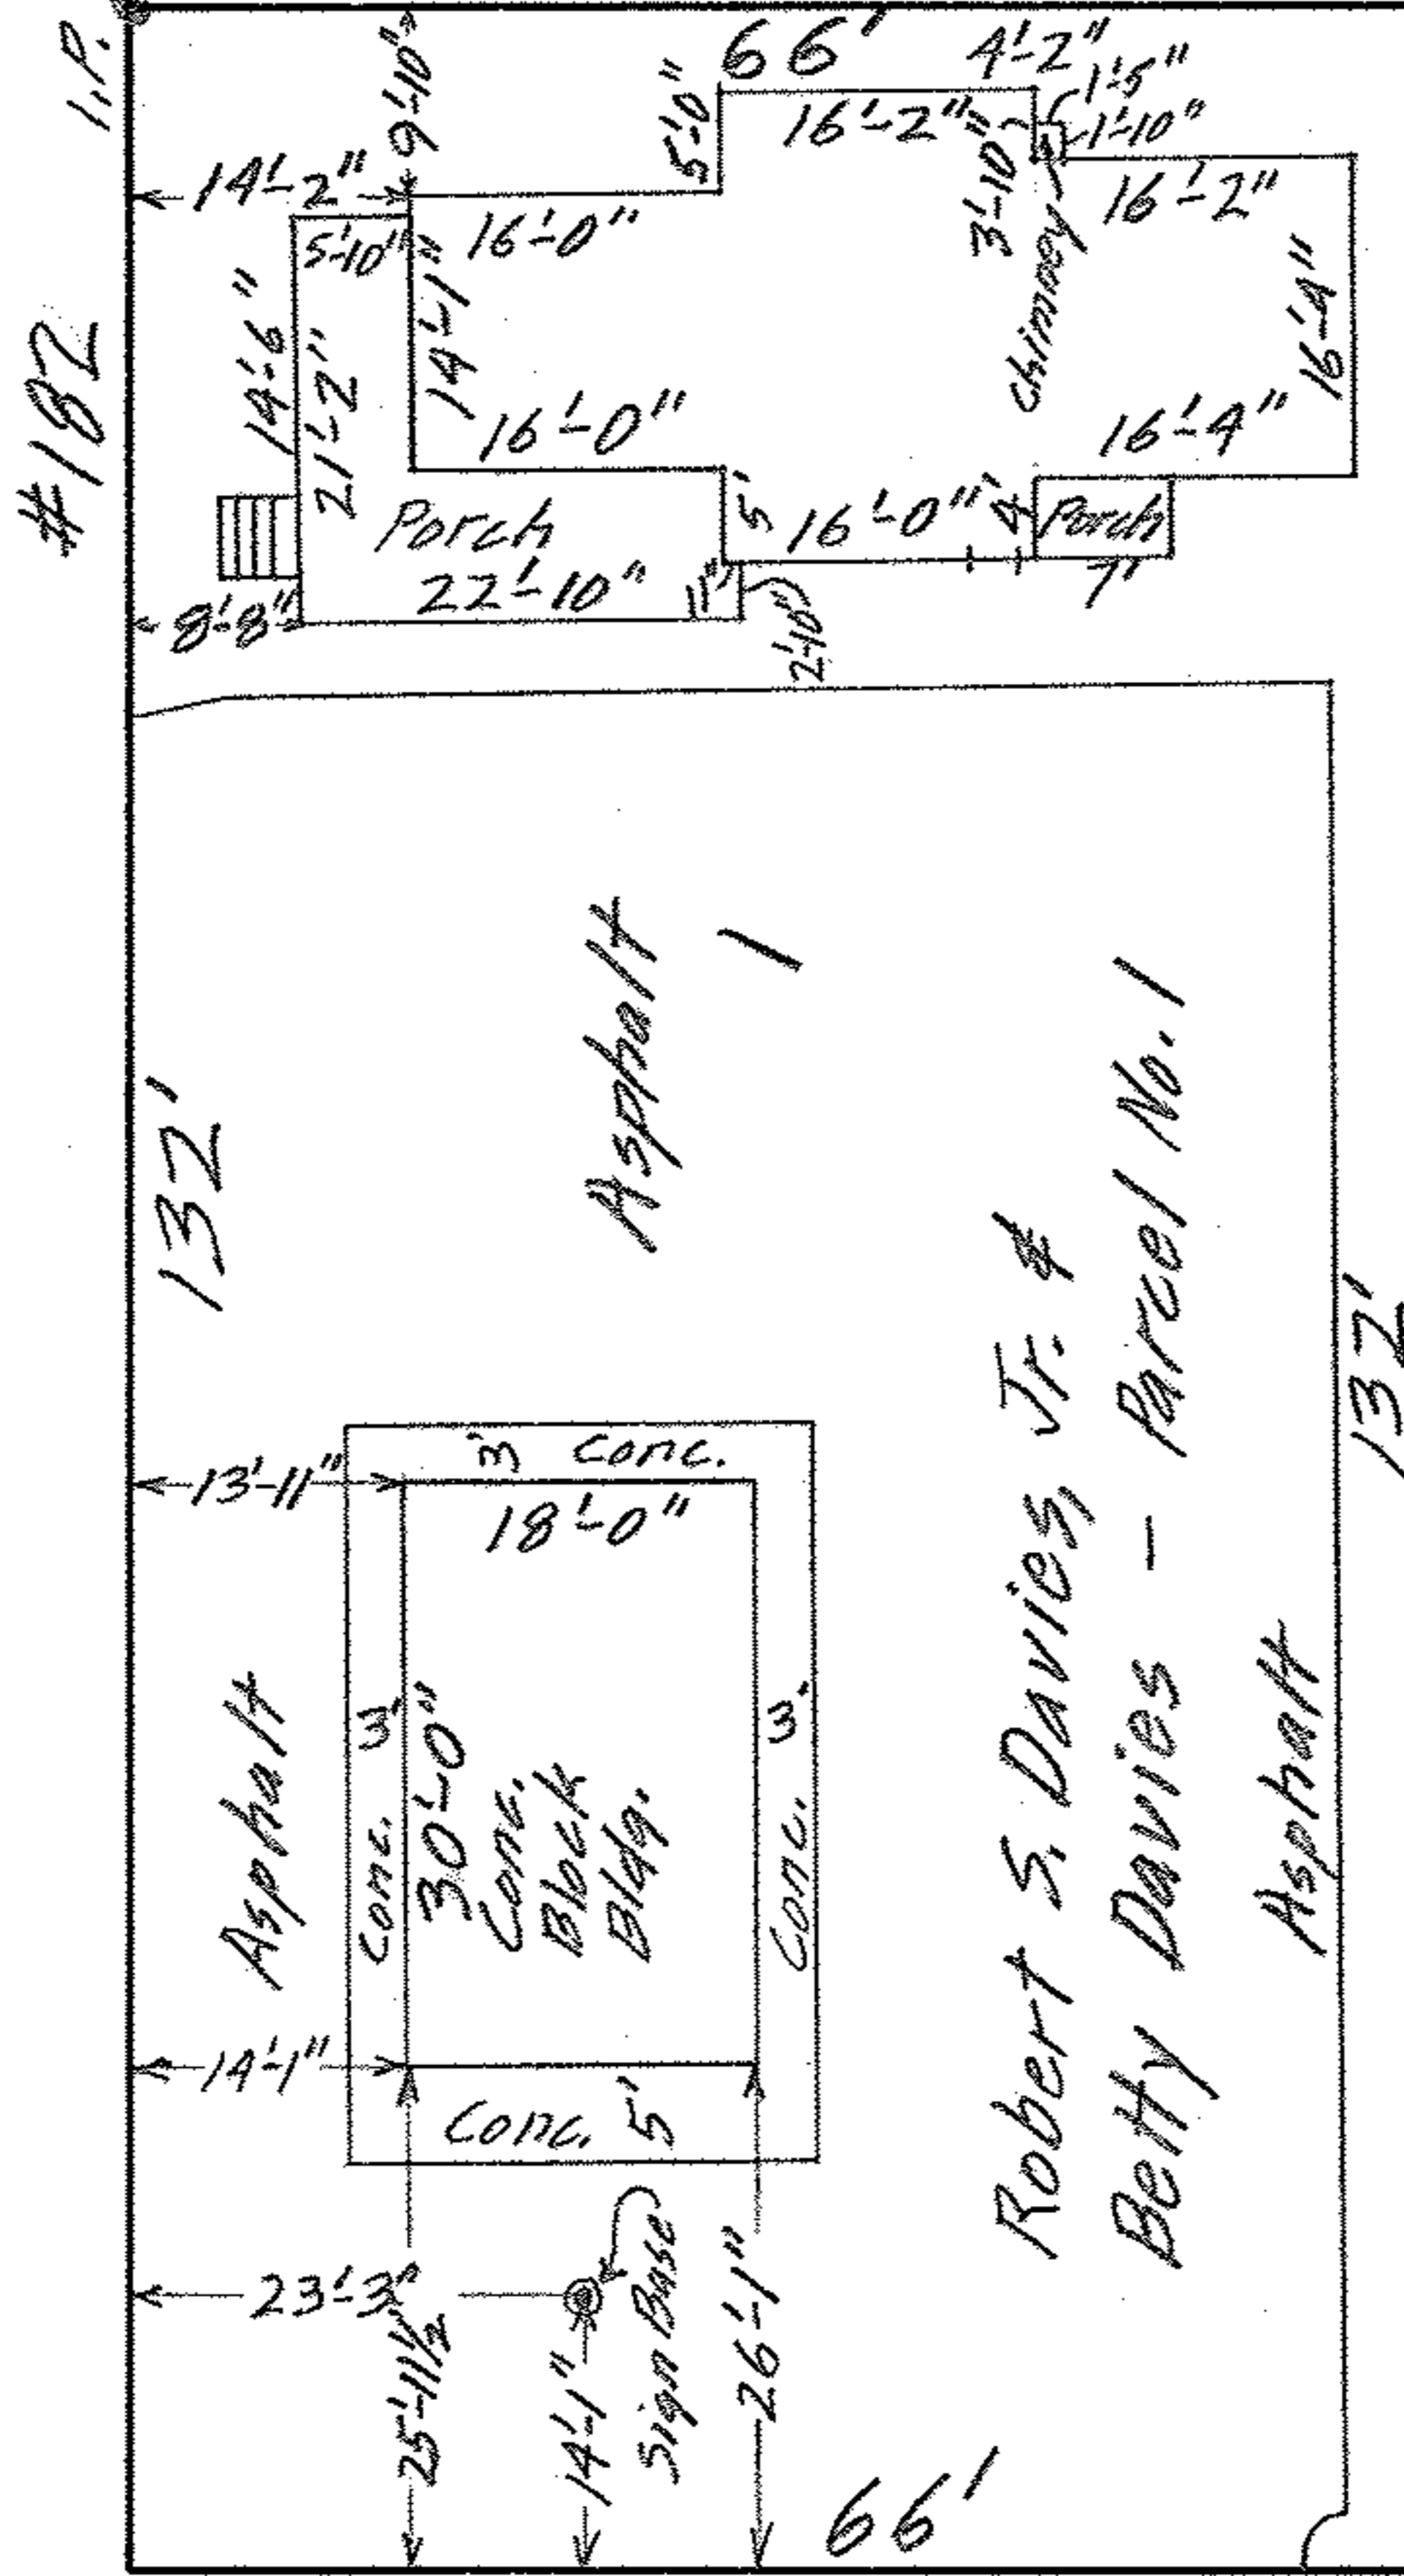

Robert S. Davies, Jr. &  
Betty Davies - Parcel No. 1

2

MAP OF SUB-LOT NO. 1  
 GREGG'S SUB'N. VOL. 2 PG. 16 PATS  
 ORIG. LOT 3 - TRACT NO. 1 - BLACK RIVER TWP.  
 LORAIN CITY - LORAIN COUNTY - OHIO  
 SCALE: 1" = 20' AUG. 20-1965 12:50 P.M.  
 Gary E. Penfound REG. SURVEYOR

