


02-01-003-111-003
 02-01-003-B
 SCANT# 450664

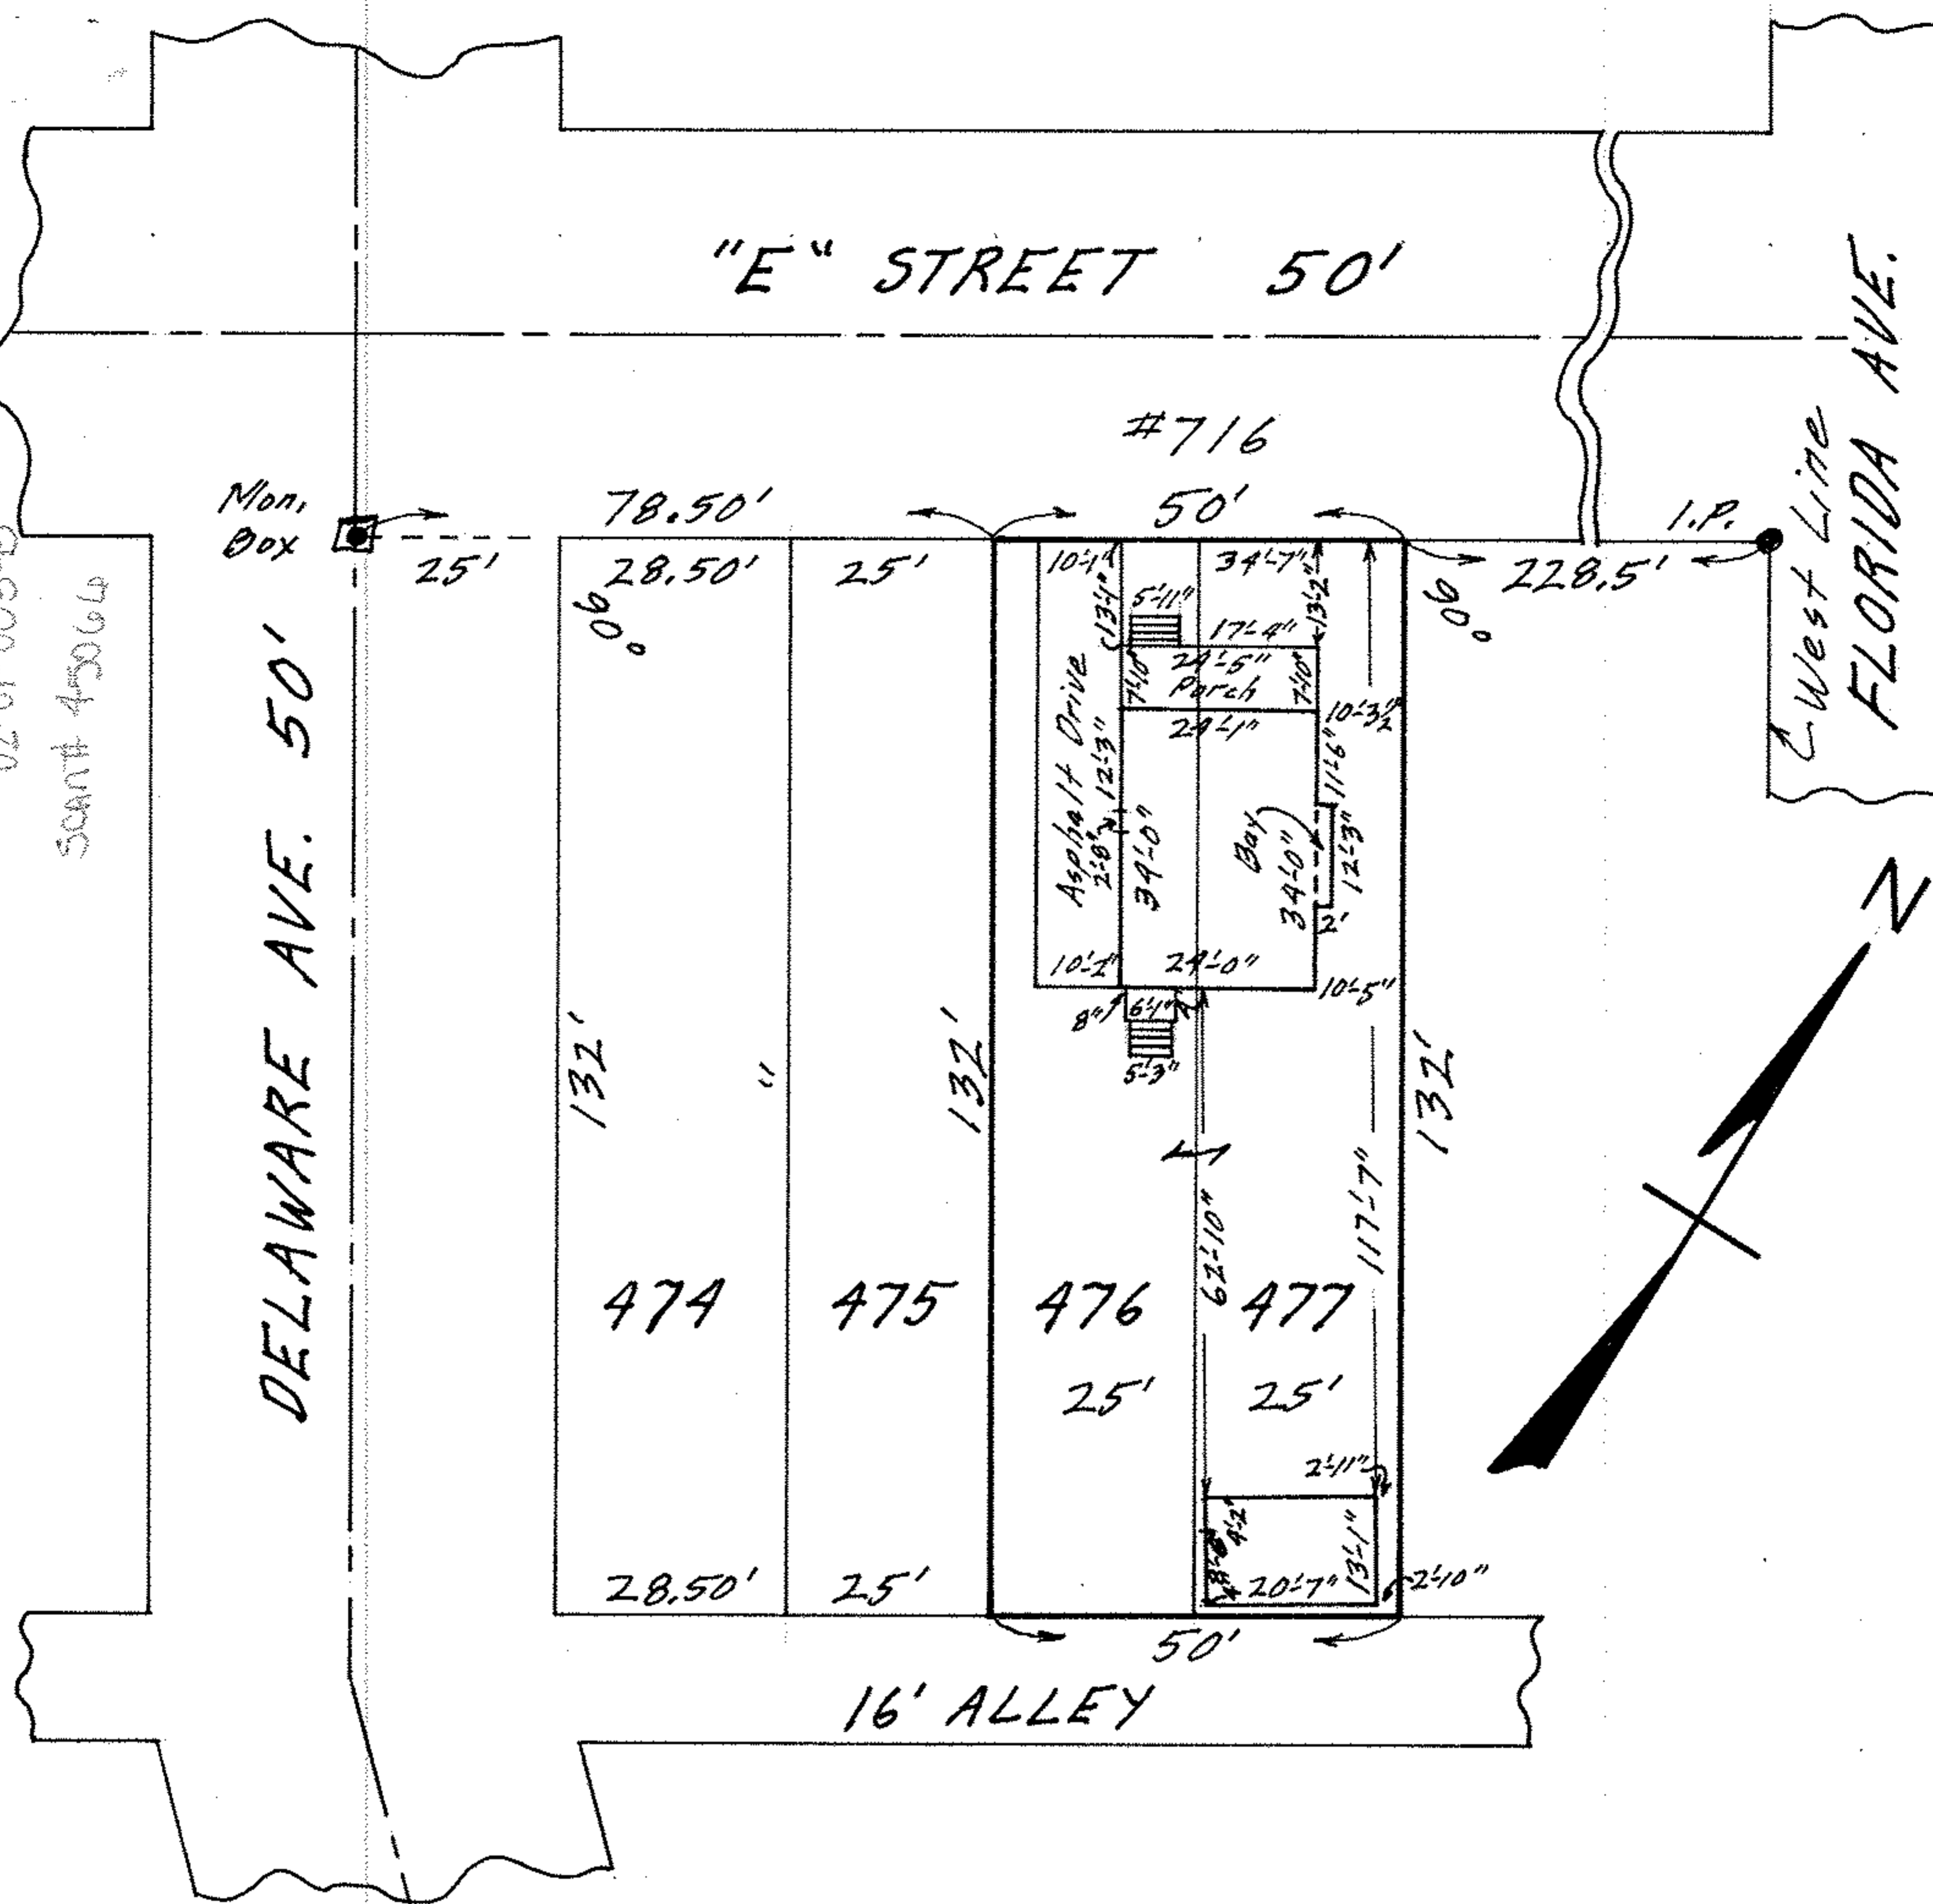

MAP OF SUB-LOTS NOS. 476 & 477
 G.A. STURTEVANT'S FAIRHOME ALL'T.
 VOL. 4 PG. 13 PLATS
 O.L. 3 - TRACT 1 - BLACK RIVER TWP.
 LORAIN CITY - LORAIN COUNTY - OHIO
 SCALE: 1" = 30' APR. 1 - 1968 11:00 A.M.
 Gary E. Penfound REG. SURVEYOR

John & Marjorie Virant