


02-01-003-145-001
Scan # 4-50-72
02-01-003-8

(WEST) 17th STREET 66'

(Formerly CLARK STREET)

GARDEN AVENUE 66'

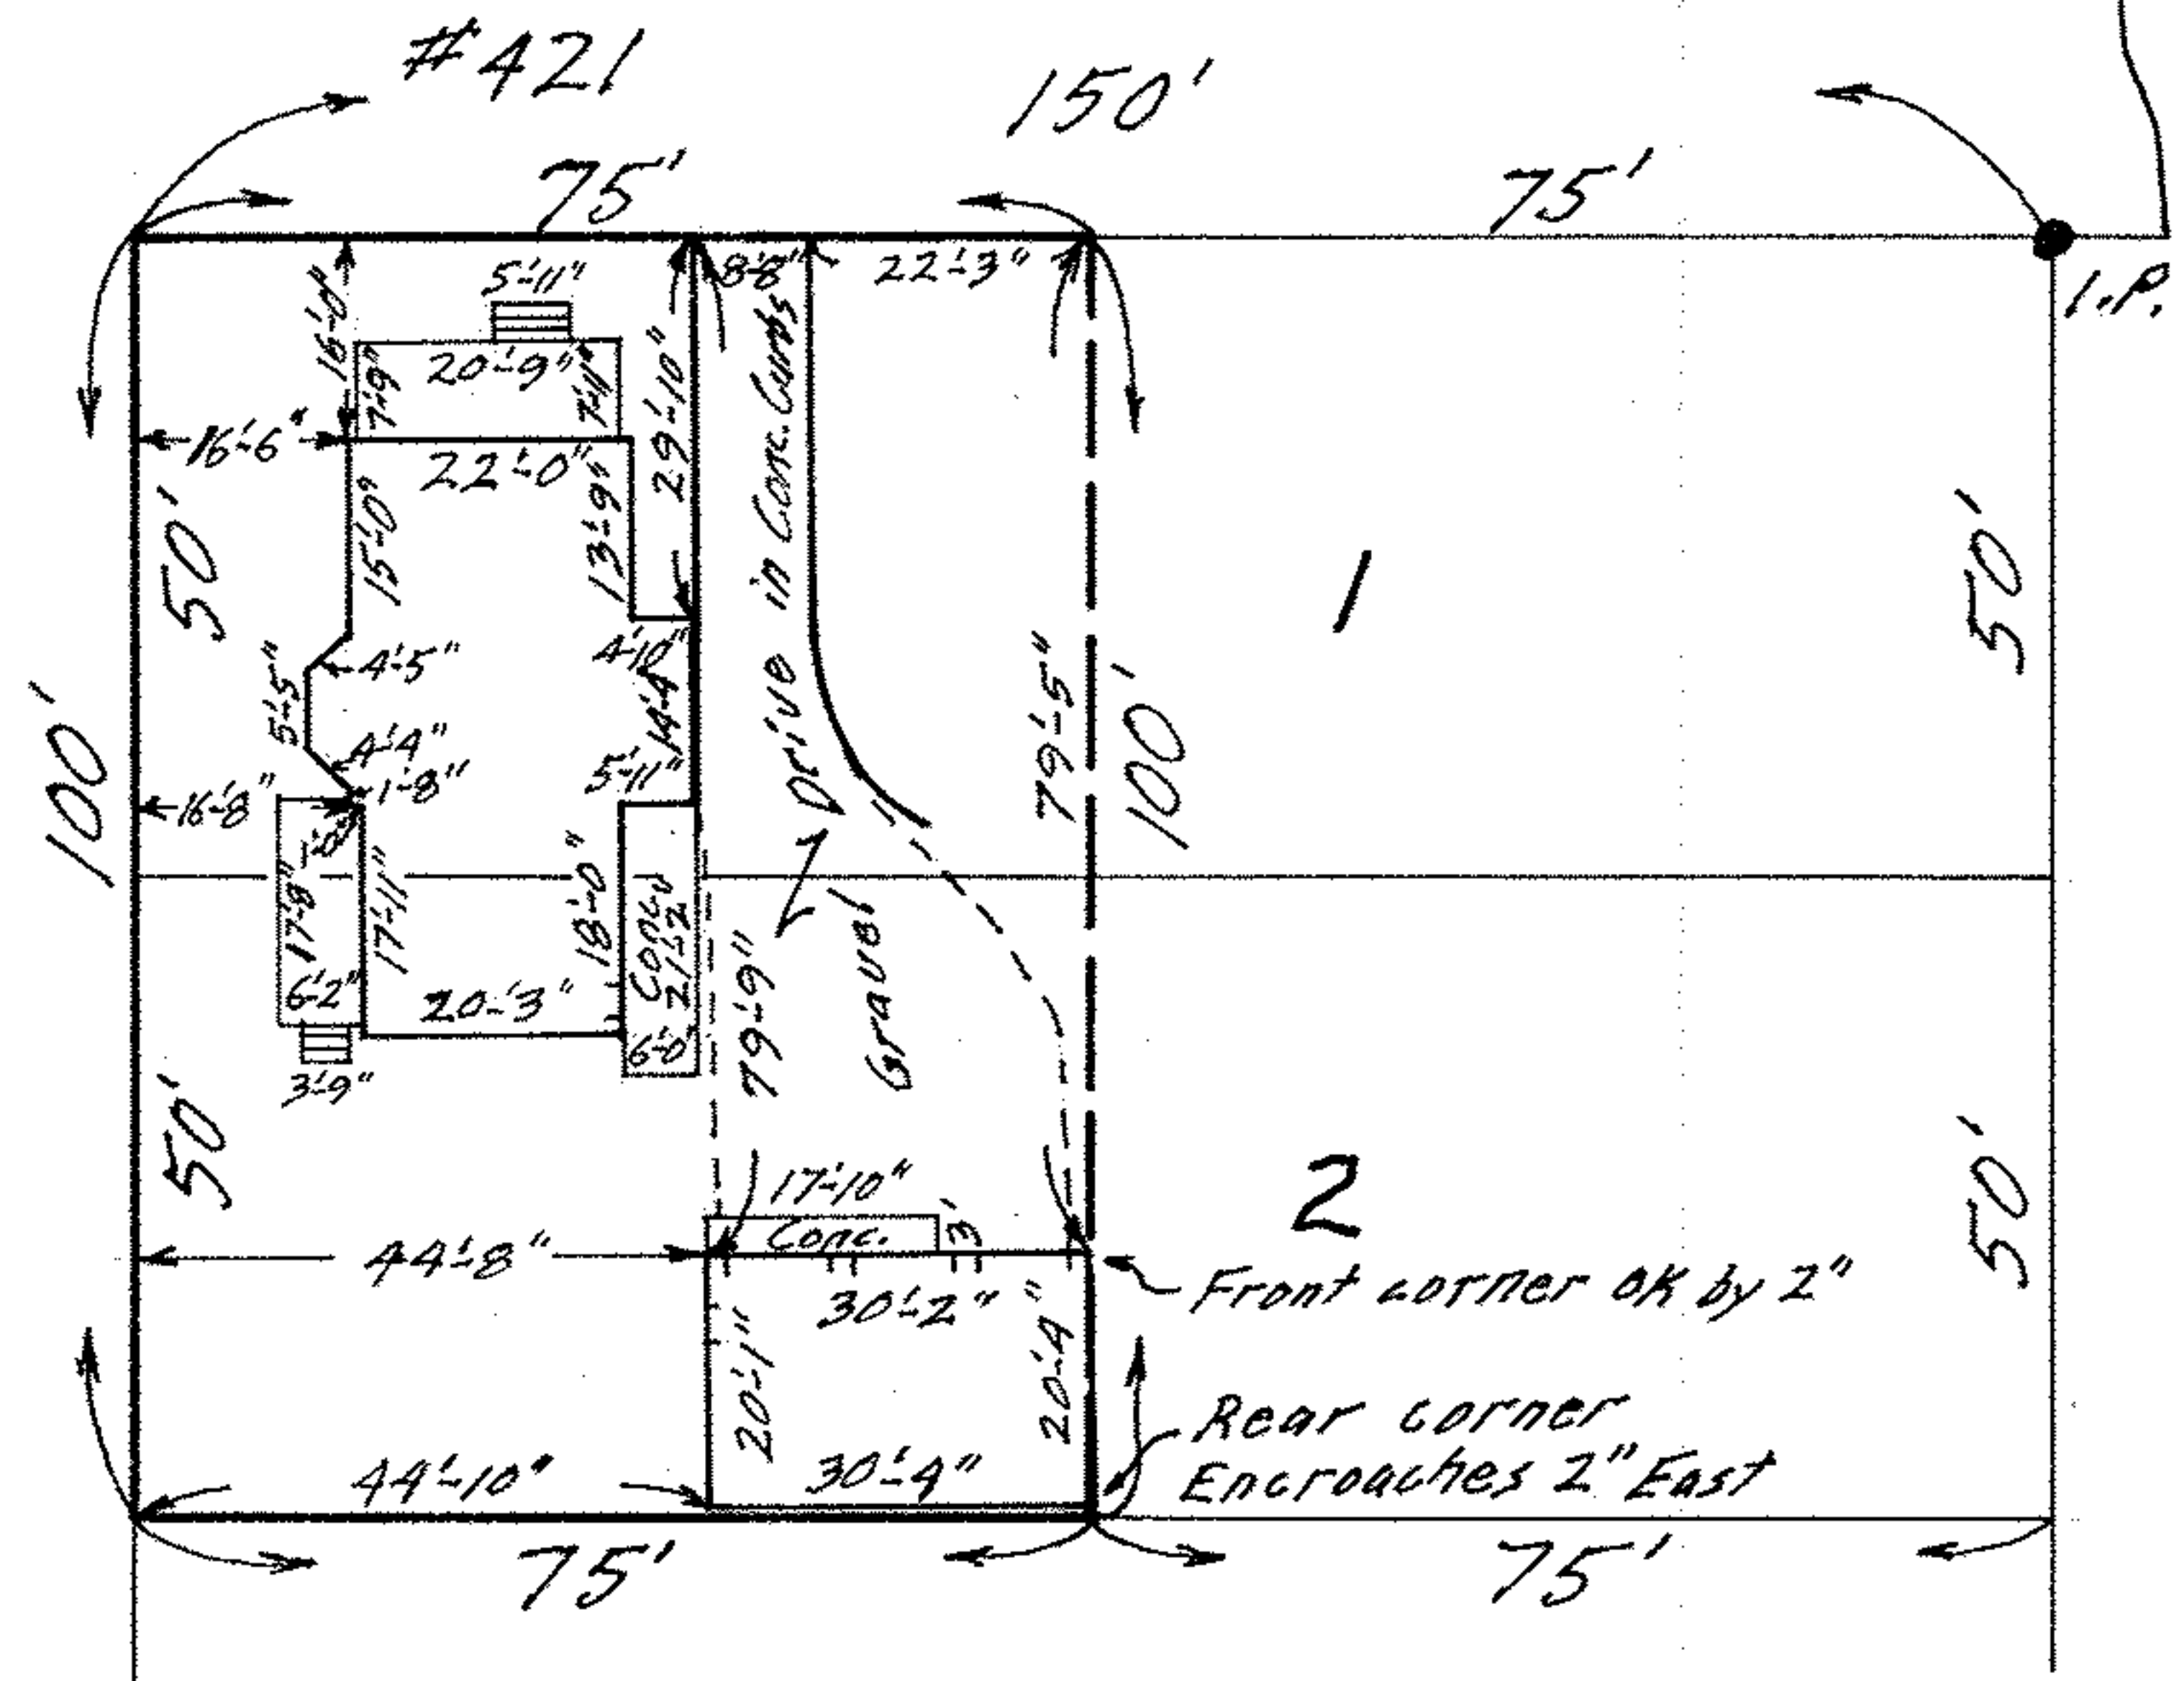

3 MAP OF THE WESTERLY 75 FEET
 OF SUB-LOTS NOS. 1 & 2 OF
 BLOCK 10 OF WM. A. BRAMAN'S
 SUB'N. VOL. 3 Pg. 21 PLATS
 ORIG. LOT 3 - TRACT NO. 1
 BLACK RIVER TWP. - LORAIN CITY
 LORAIN COUNTY OHIO

SCALE: 1" = 30' MAY 9-1970 3:00 P.M.

NOTE: Southeast corner of garage encroaches onto property to the east as shown.

Gary E. Penfound REG. SURVEYOR NO. 4457

CITY TITLE Co. Order No. E-1112-13 Gonzales to Boles