


010'600-251-500-10-20
02-01-003-E
SCAN # 45074

OAKDALE AVENUE

#1919

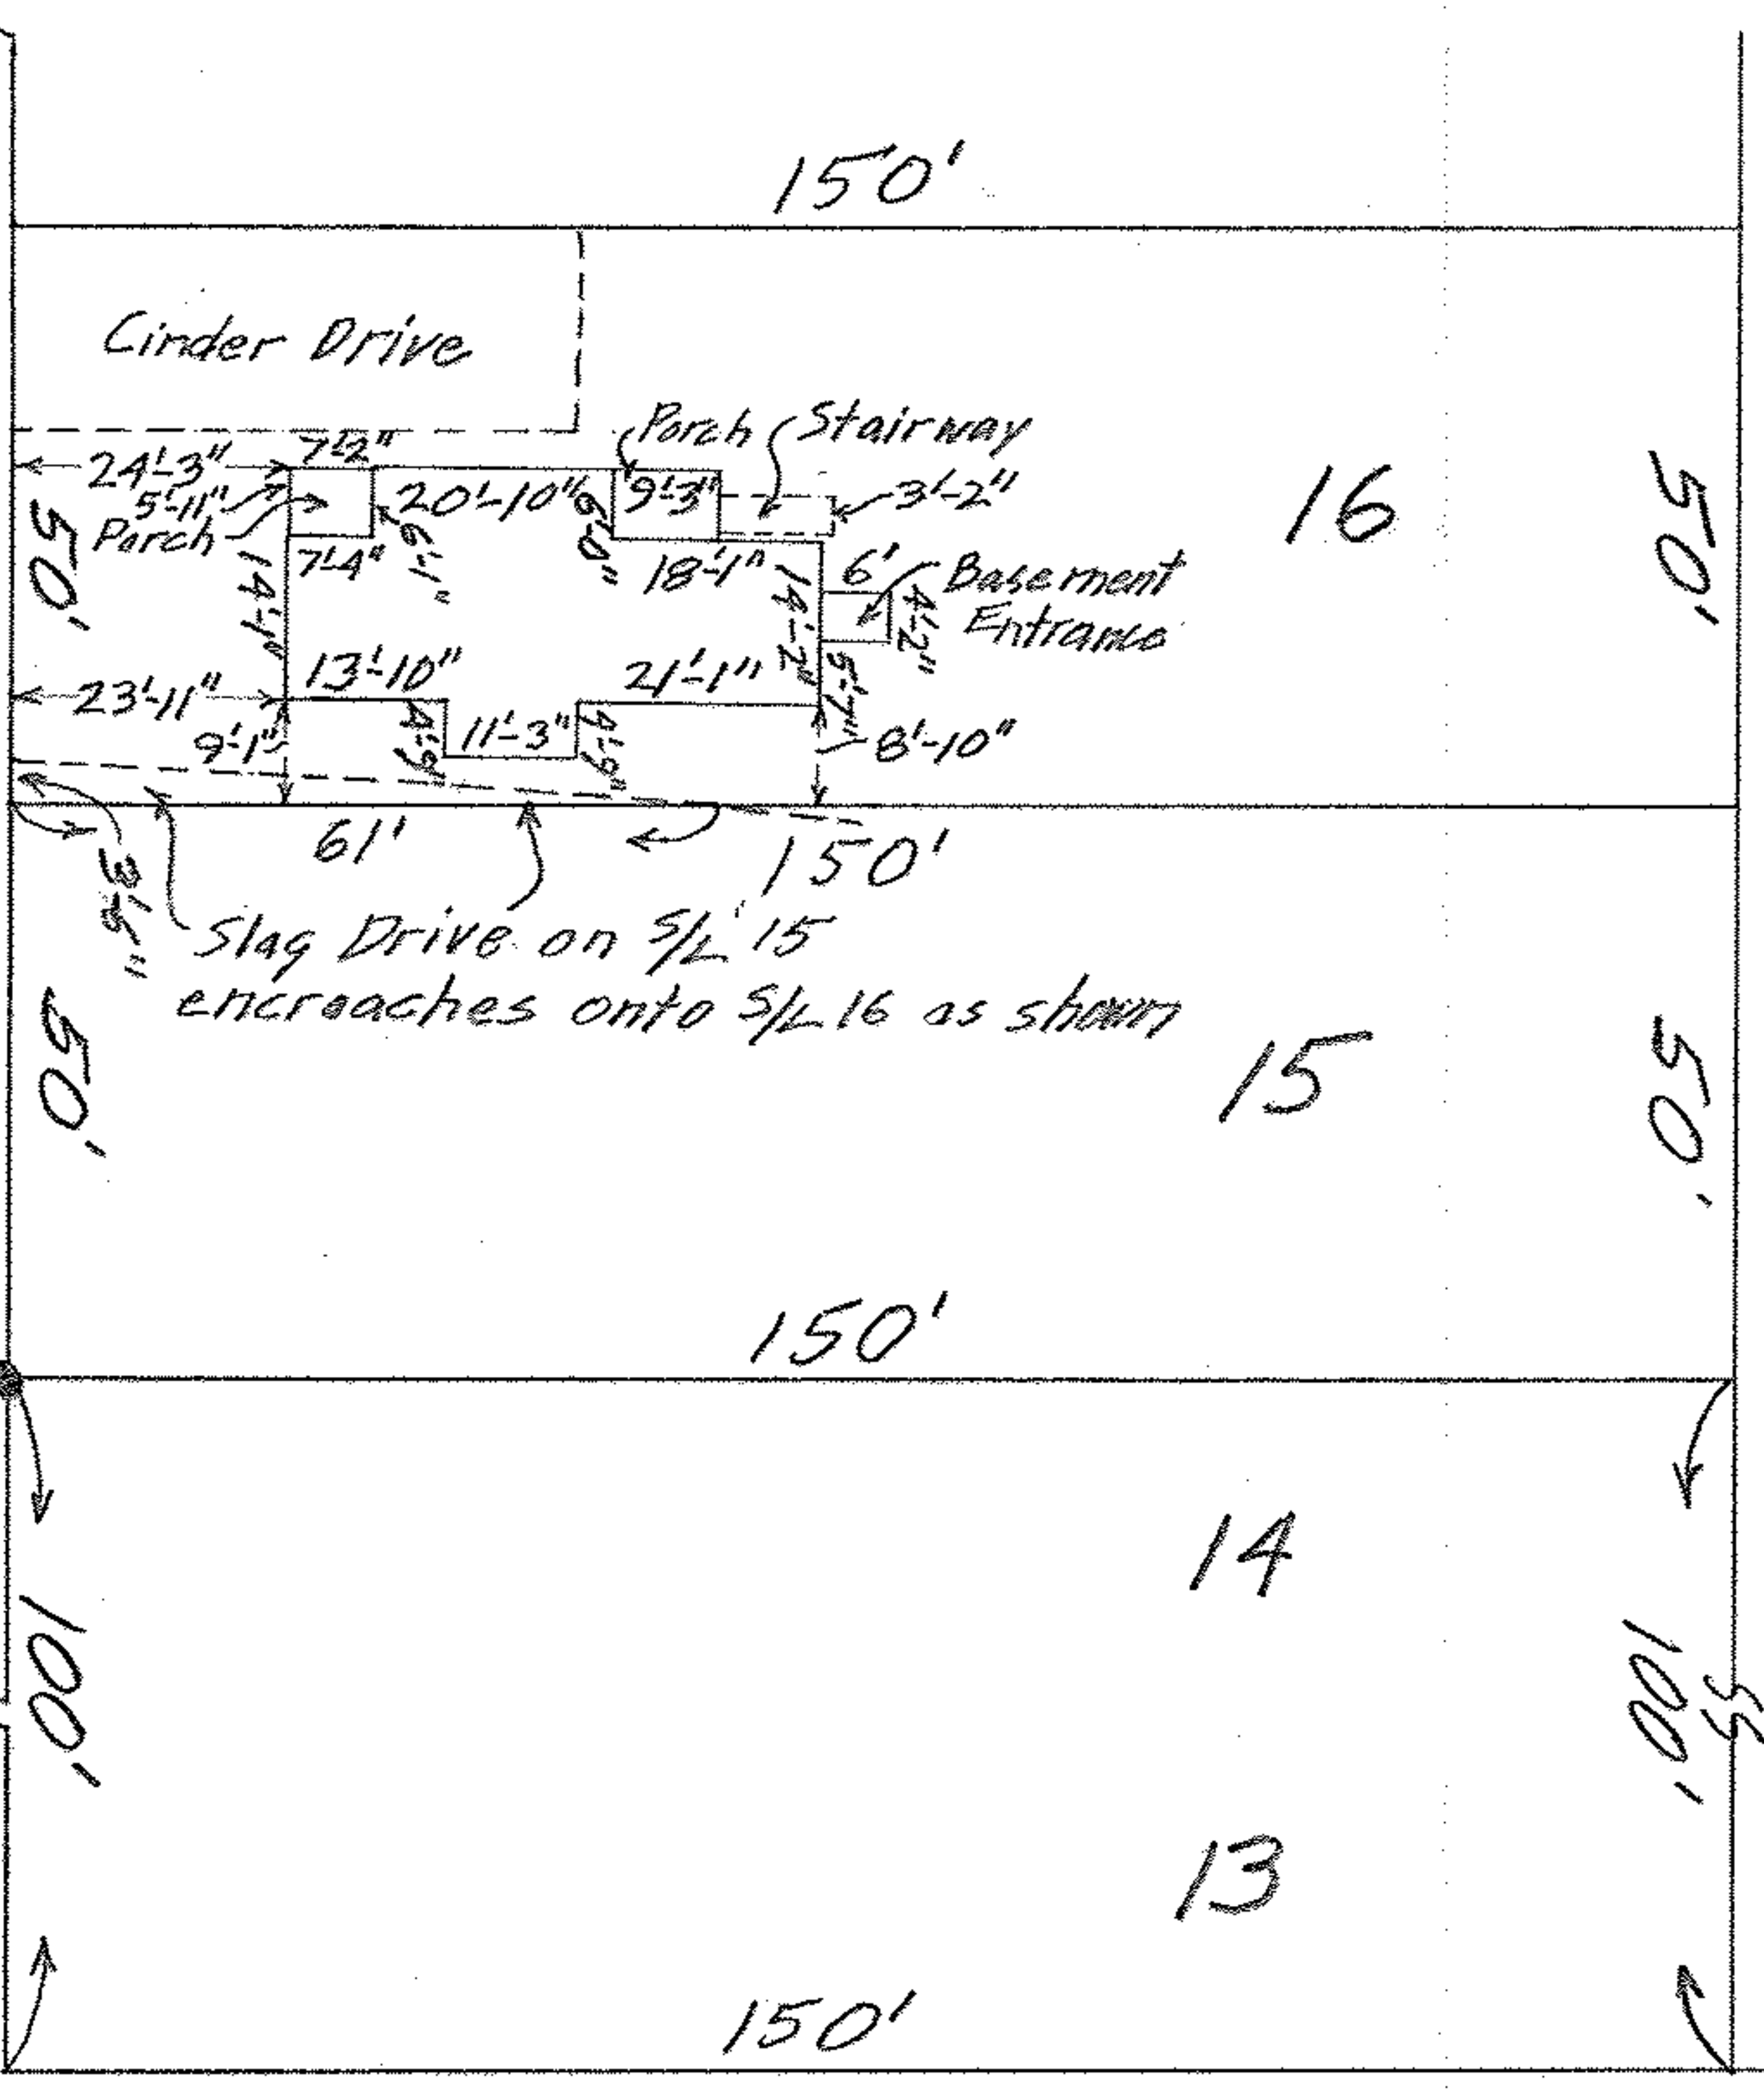

(Formerly KENT STREET)
WEST 20TH STREET 66'
N. 82°05'E.

MAP OF SUB-LOT NO. 16 - BLOCK NO. 14
BRAMAN, TRUSTEE'S THIRD ADD'N. - VOL. 3 PG. 33
O.L. 3 - TRACT 1 - BLACK RIVER TWP.
LORAIN CITY - LORAIN COUNTY - OHIO
SCALE: 1"=30' MAY 10, 1963 4:15 P.M.
Gary E. Penfound REG. SURVEYOR

R.L. & Ruth White

BH

02-01-003