


WEST 18TH STREET 66'
(Formerly FOREST STREET)

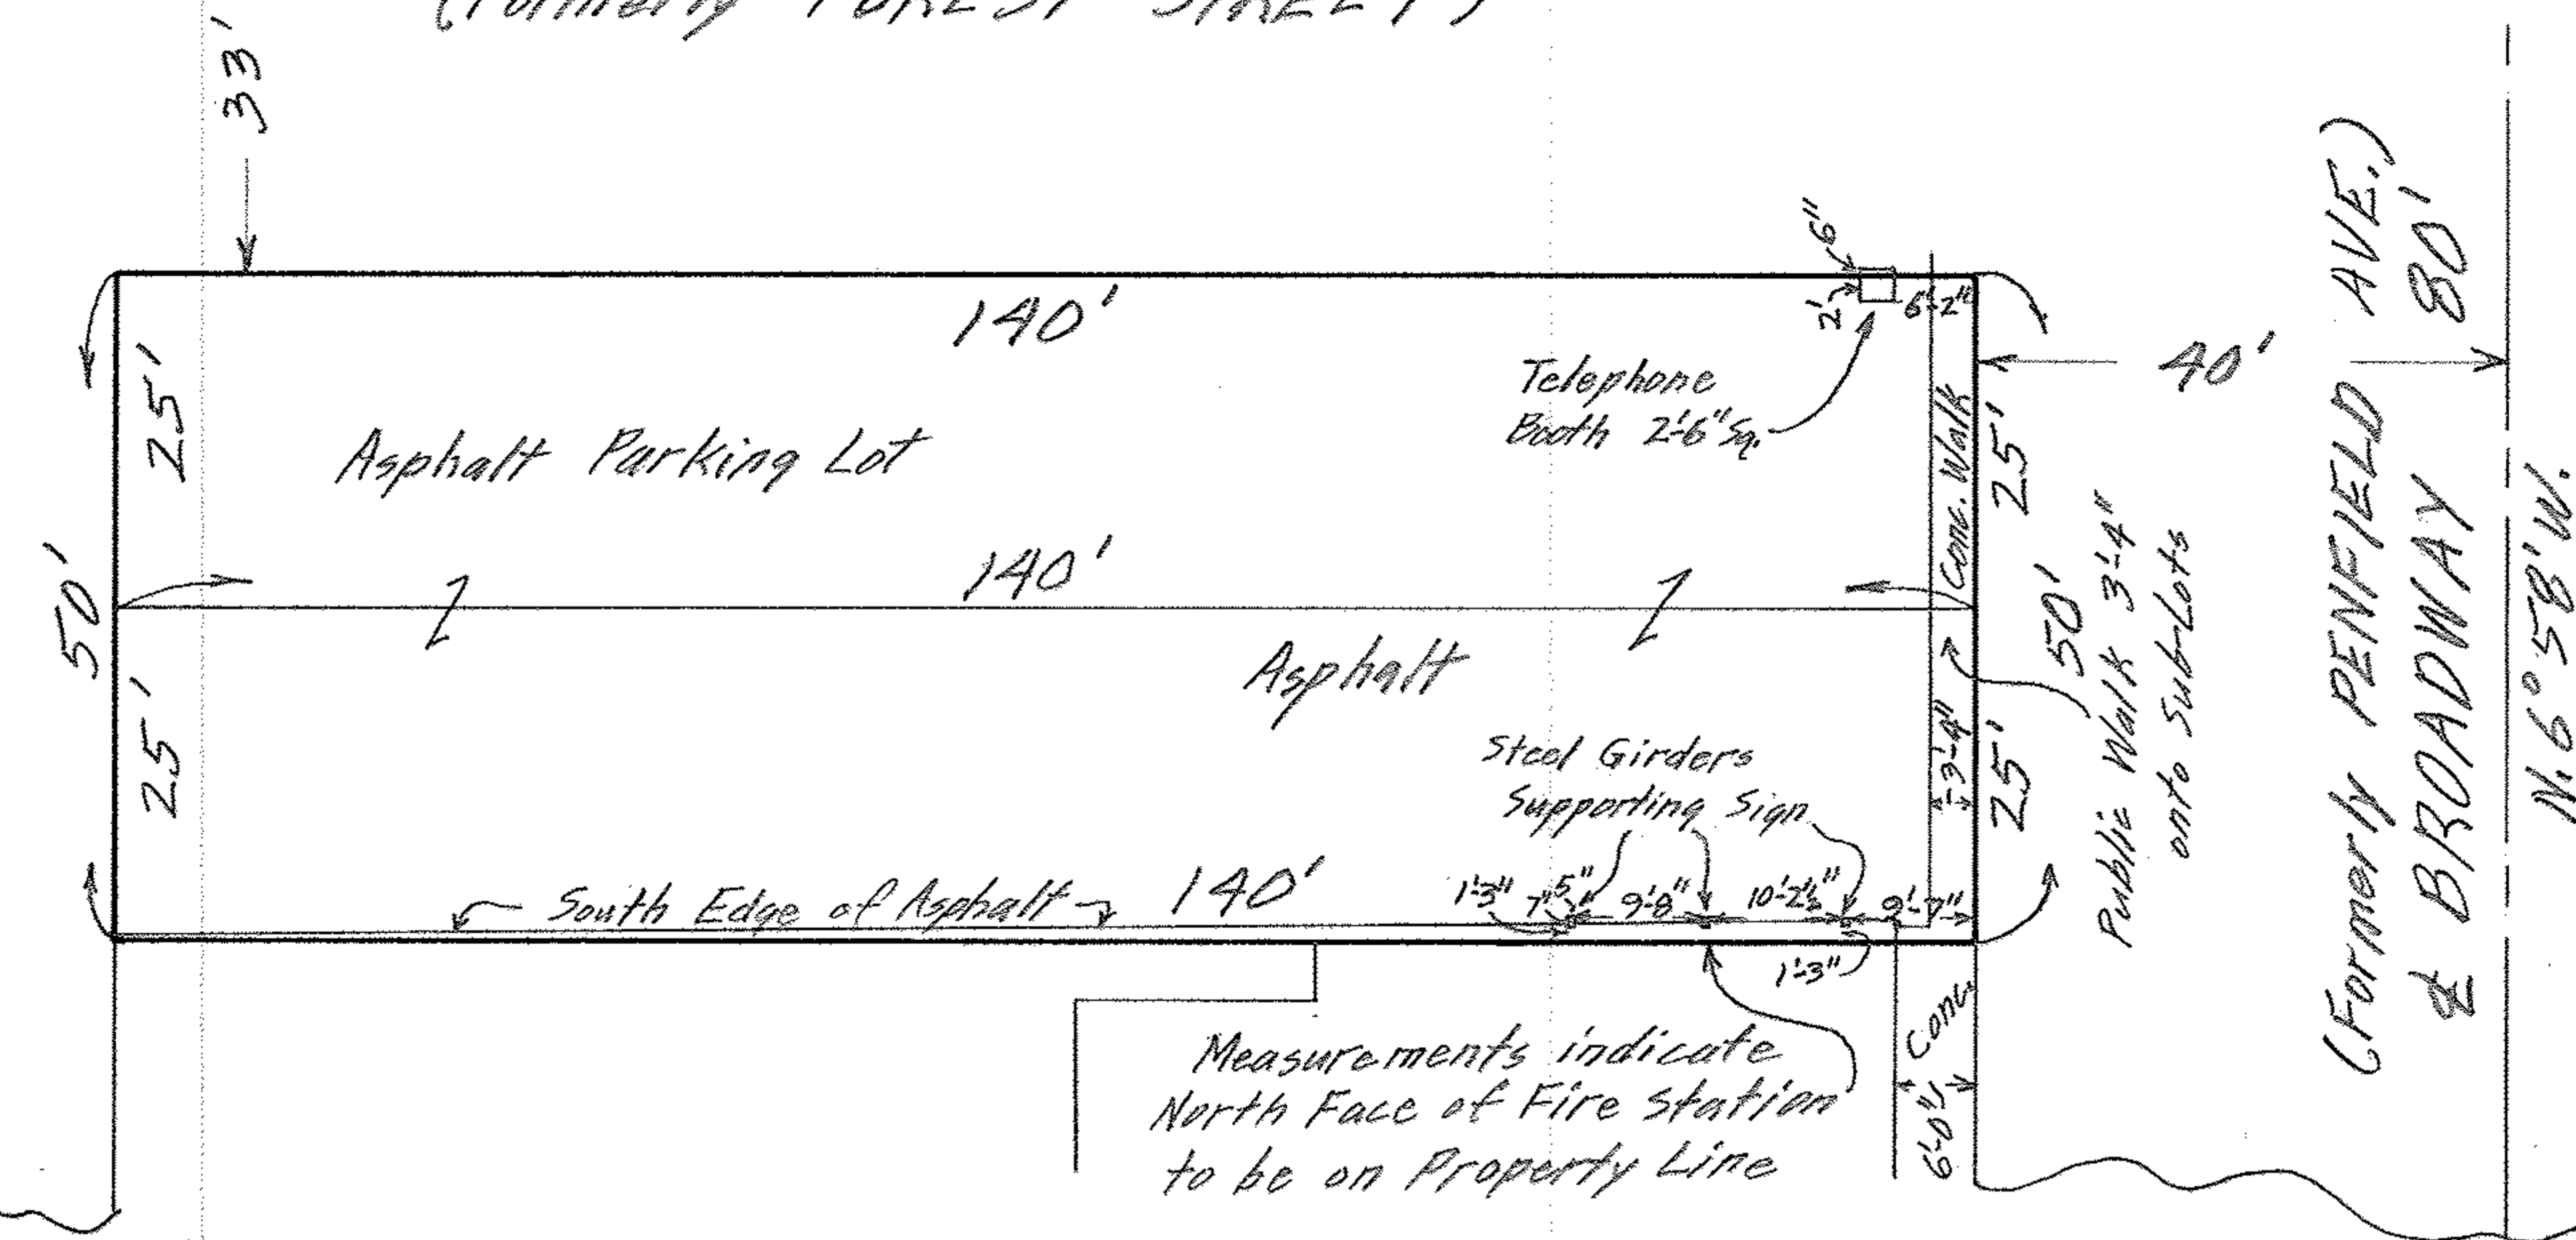

Measurements indicate
North Face of Fire Station
to be on Property Line

MAP OF SUB-LOTS NOS. 23 & 24, BLOCK 7
 W. A. BRAMAN'S SUB'N. Vol. 3 Pg. 18 PLATS
 LOT 3 - TRACT 1 - BLACK RIVER TWP.
 LORAIN CITY - LORAIN COUNTY - OHIO
 SCALE: 1" = 30' AUG. 13 - 1965 12:30 P.M.
 Gary E. Penfound REG. SURVEYOR
 THE OHIO BAR TITLE INSURANCE CO.
 Milton Friedman, Agent Order No. 1228 Godes

