


CITY TITLE Co. Order No. E-924-5
Coxon to Perez

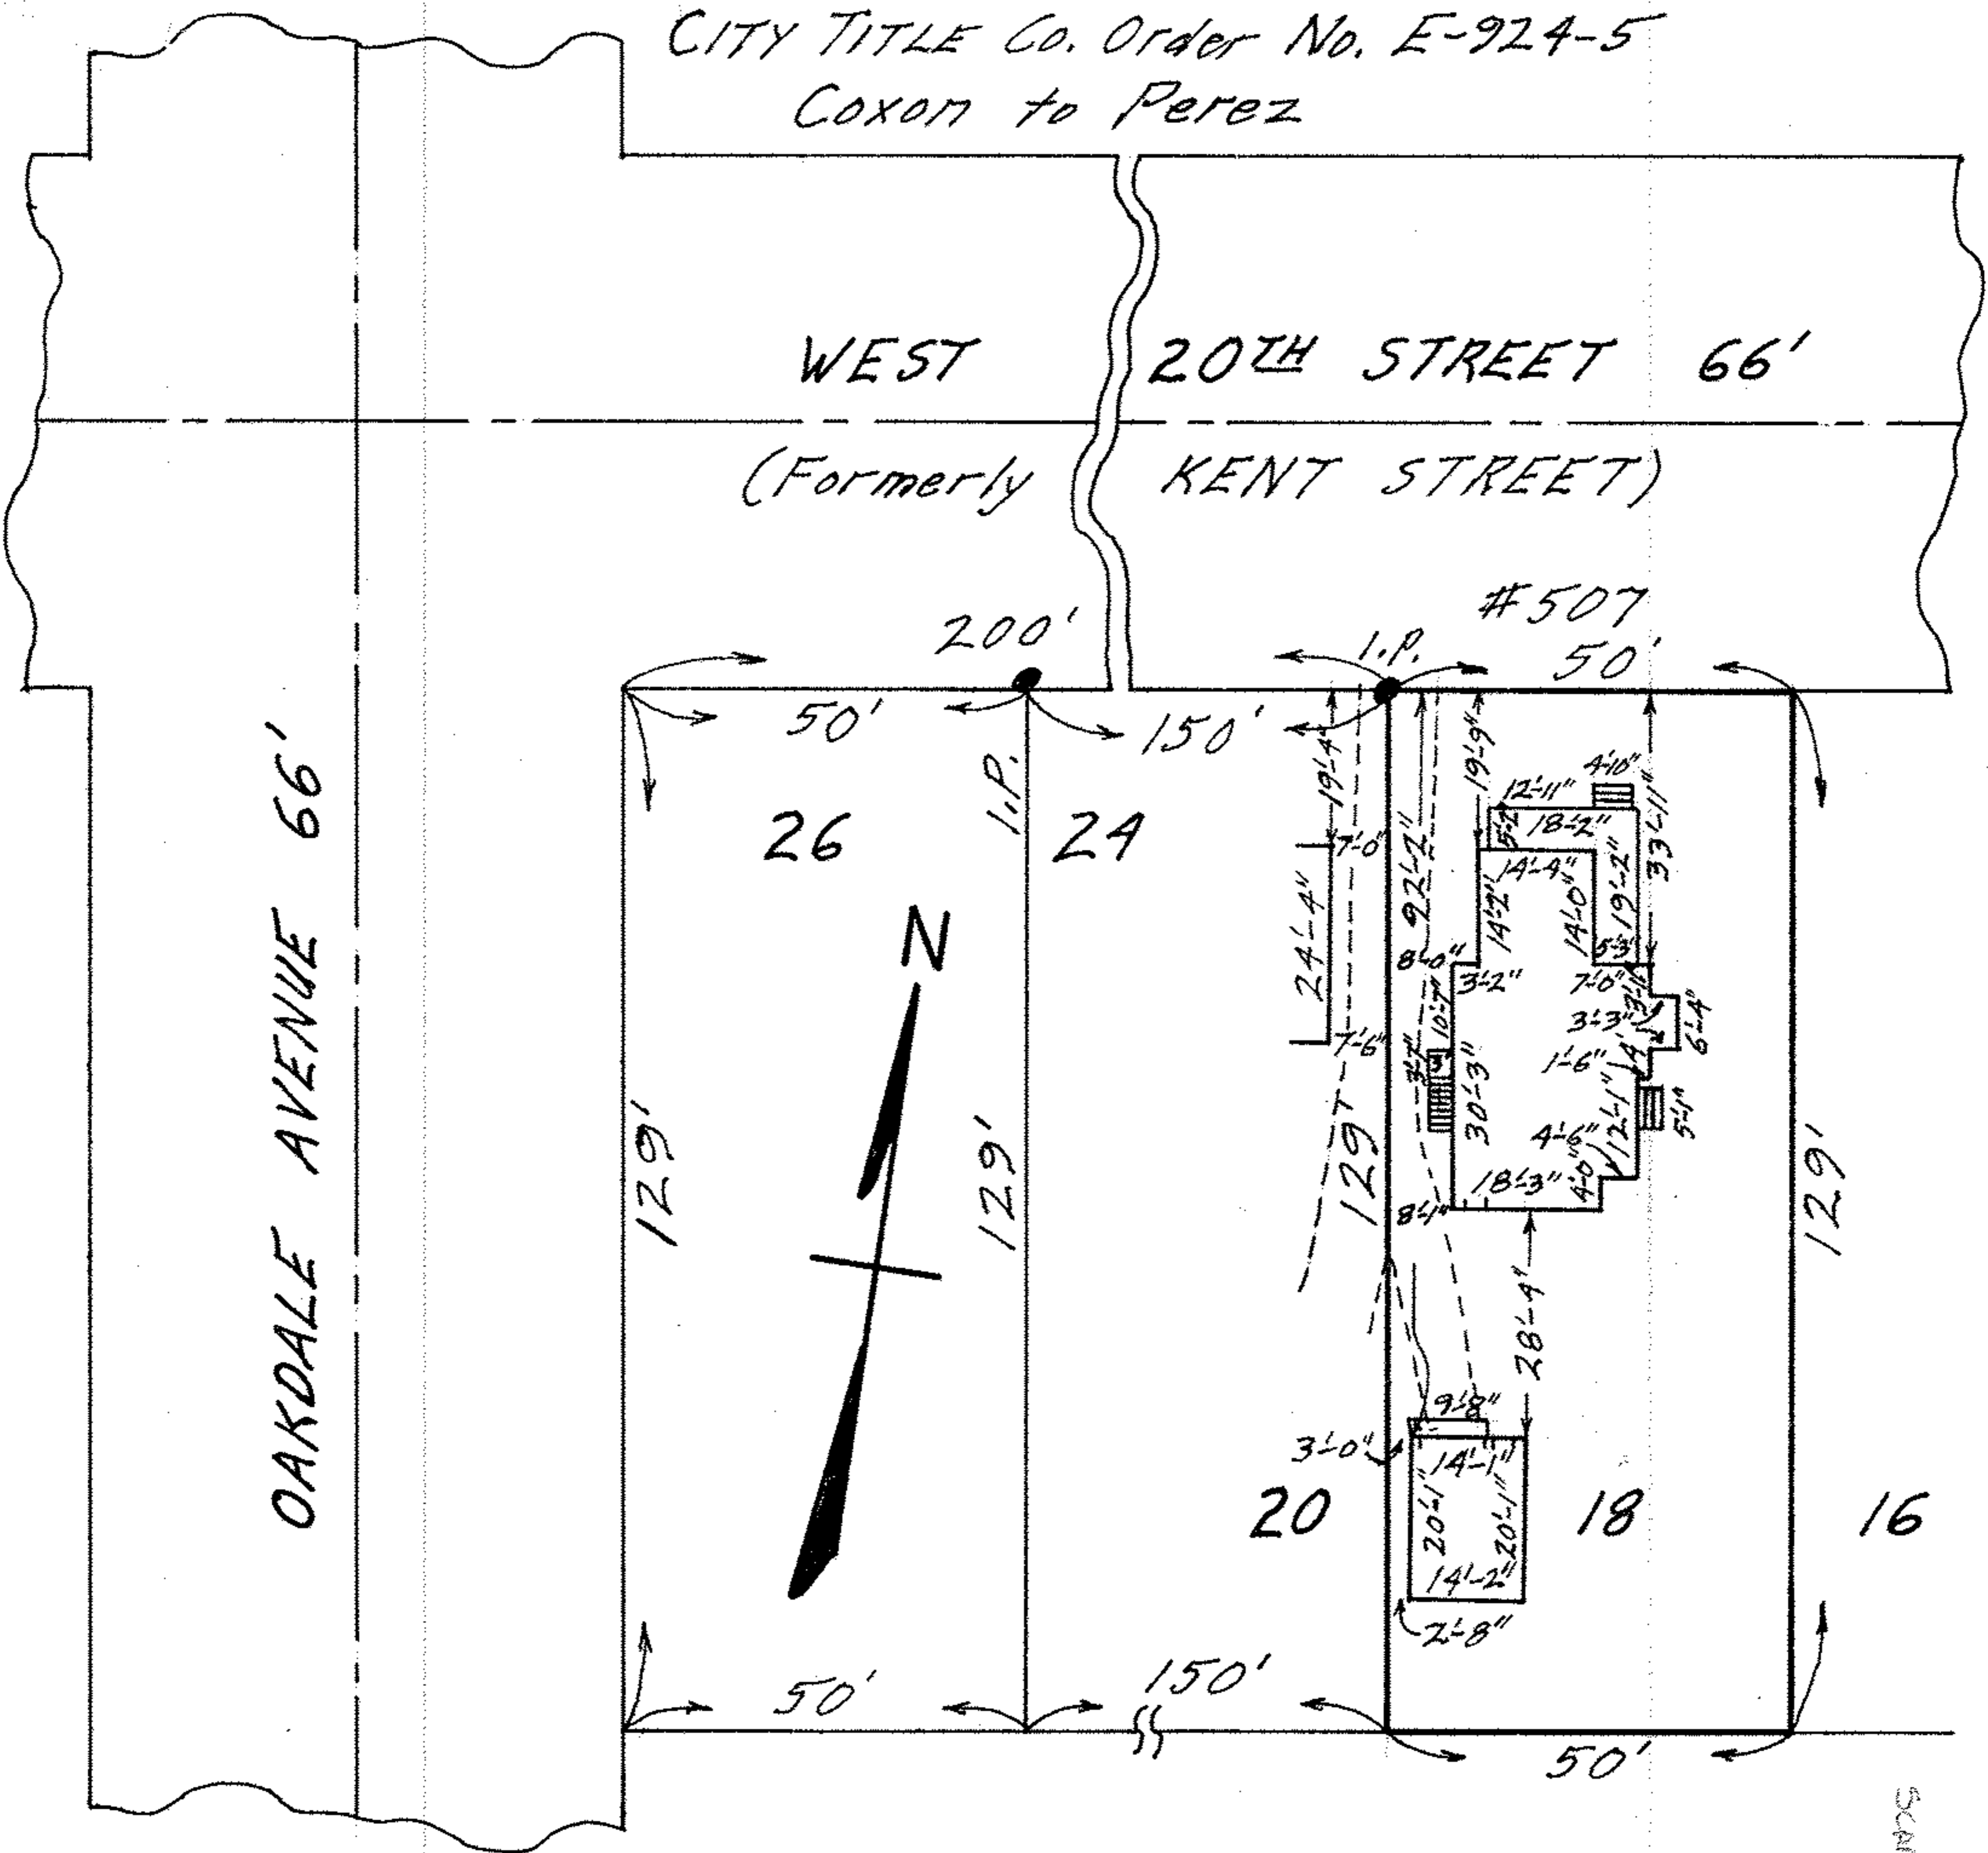

MAP OF SUB-LOT NO. 18 OF BLOCK NO. 9
G. HOGAN'S THIRD ADD'N. VOL. 3 Pg. 31
ORIG. LOT 3 - TRACT 1 - BLACK RIVER TWP.
LORAIN CITY - LORAIN COUNTY - OHIO
SCALE: 1" = 30' NOV. 2-1969 4:15 P.M.
NOTE: There is no encroachment on the above
property, but there is a common drive.
Gary E. Penfound REG. SURVEYOR NO. 4457

SCAN # 45076

02-01-003-101-004
02-01-003-E