


02-01-003-183-009  
02-01-003-9  
SCAN # 45084

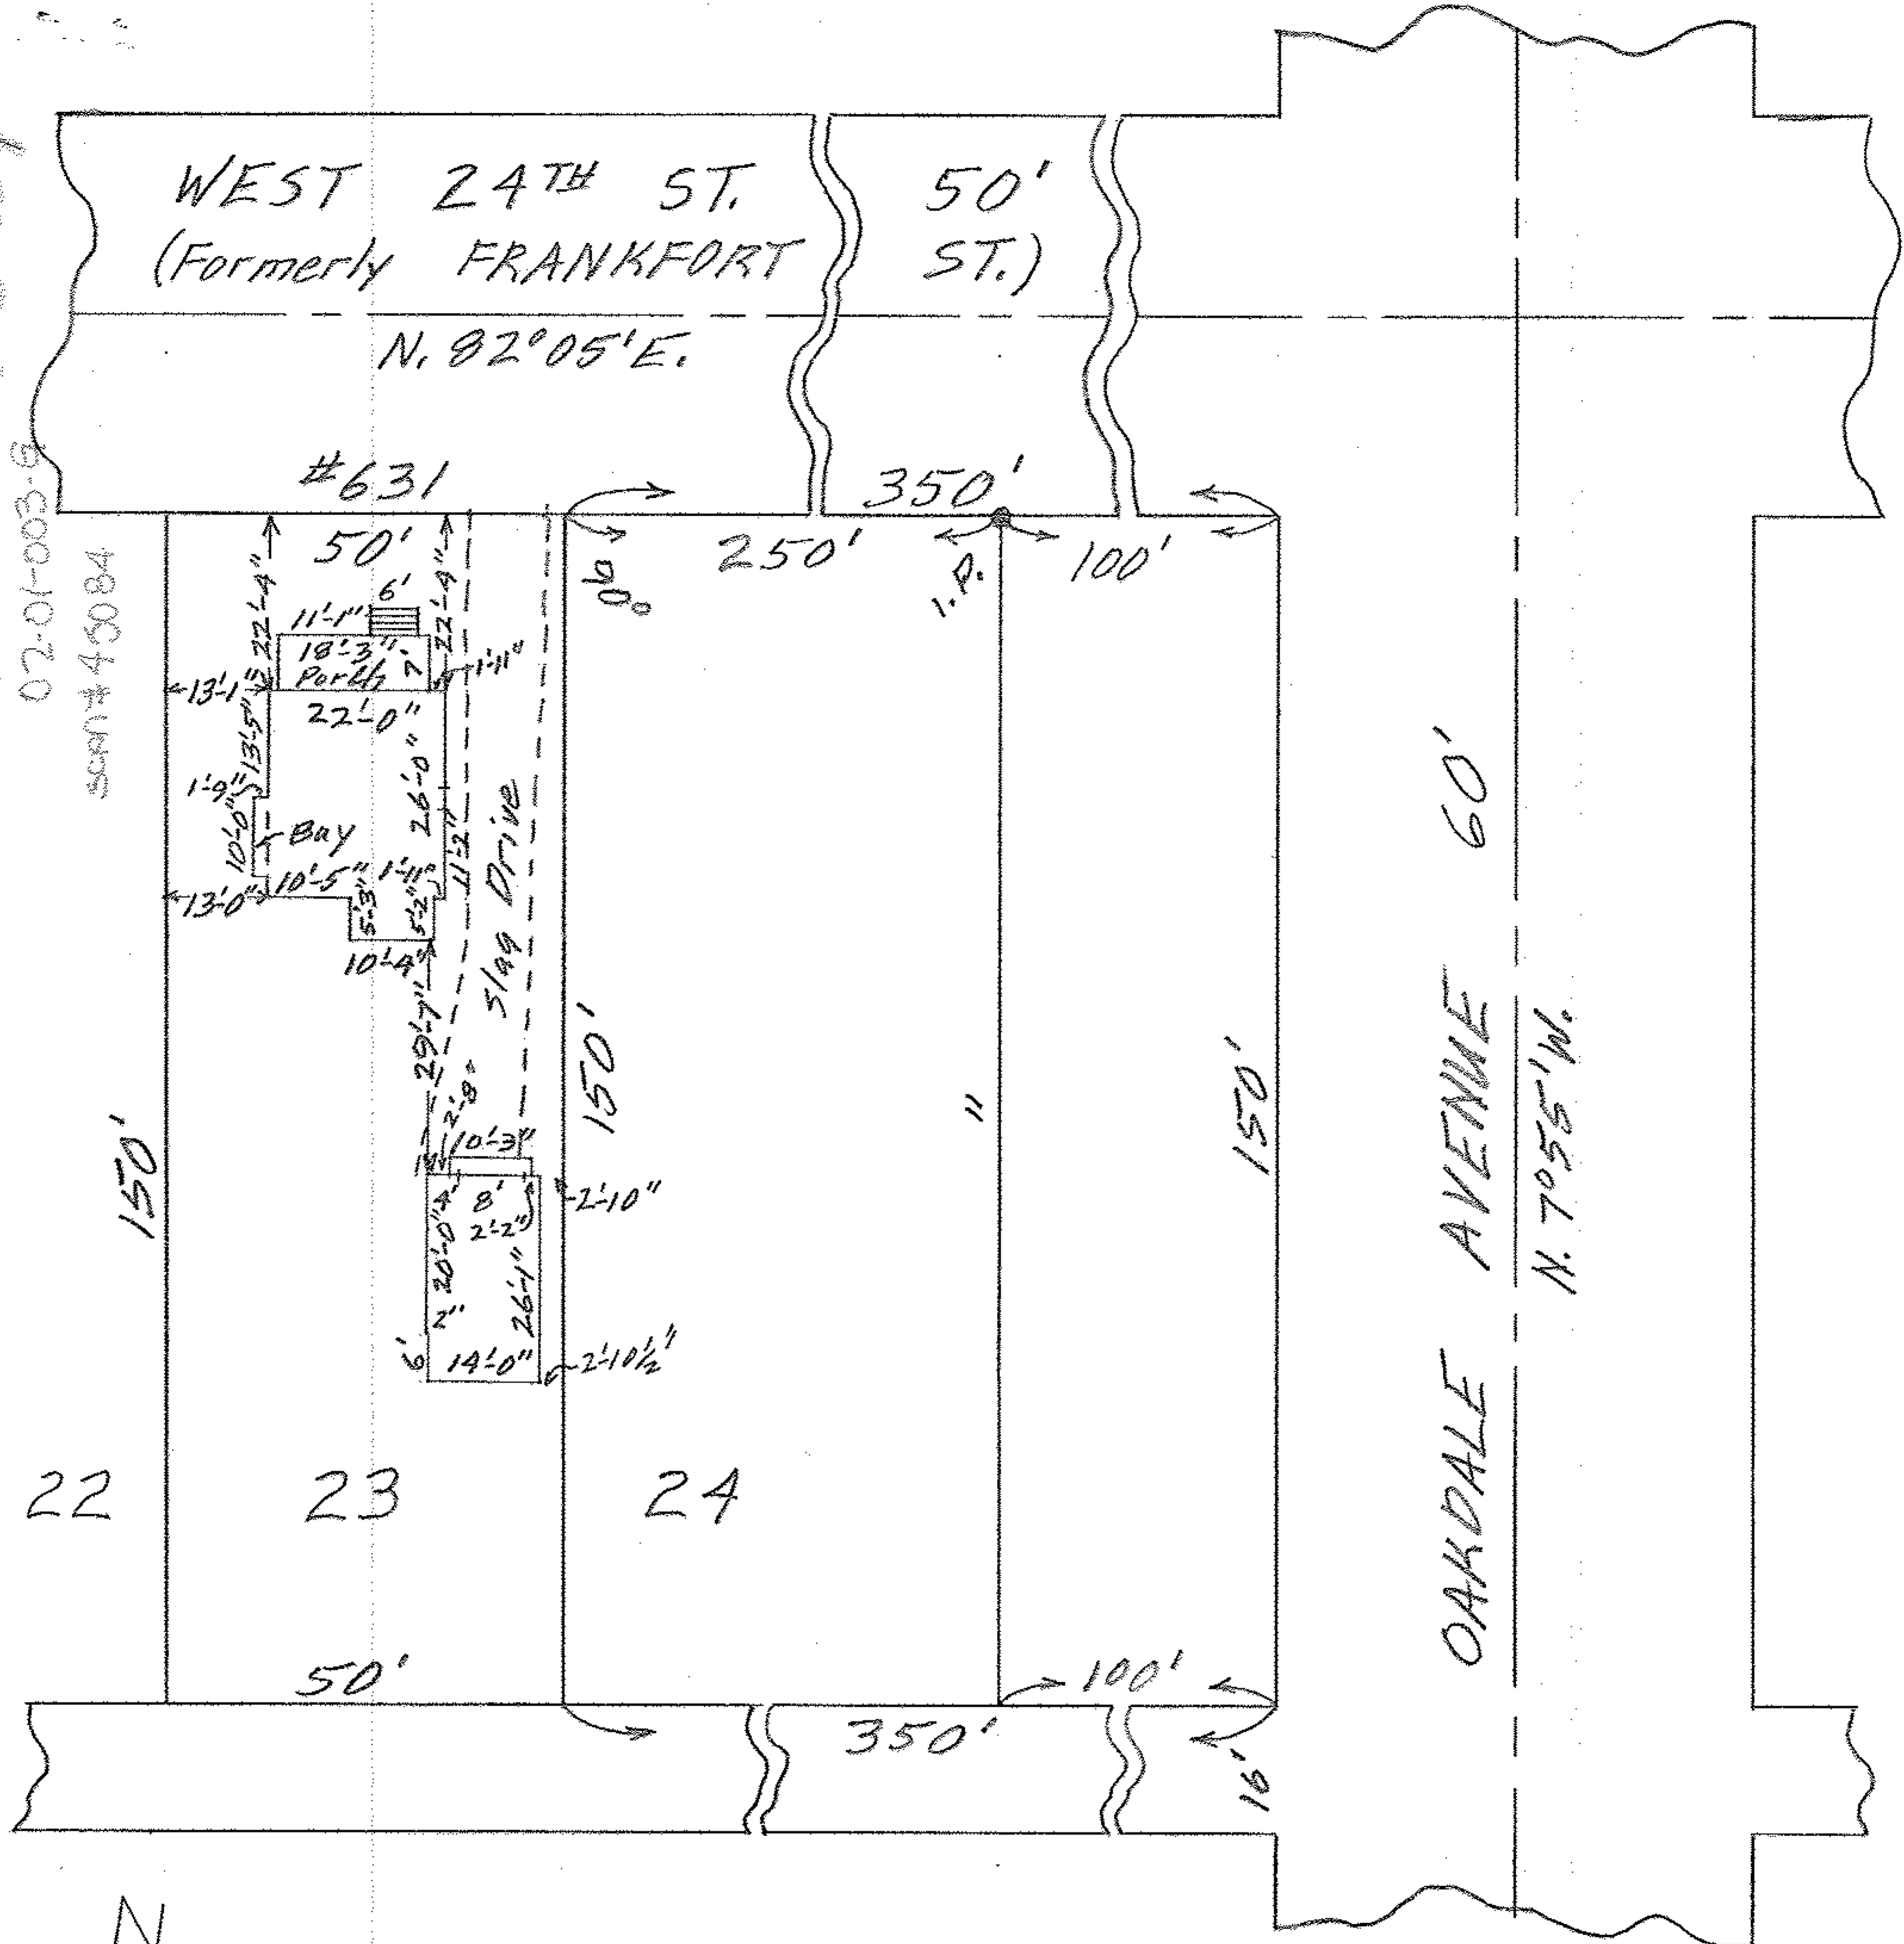

MAP OF SUB-LOT NO. 23

WM. A. BRAMAN, TRUSTEE'S SECOND SUBN. Vol. 3 Pg. 40

LOT 3 - TRACT 1 - BLACK RIVER TWP.

LORAIN CITY - LORAIN COUNTY - OHIO

SCALE: 1" = 30' OCT. 26 - 1964 5:30 P.M.

Gary E. Penfound REG. SURVEYOR

Henry Lovett, Jr. & Mary Ann Lovett