


02-01-003-189-002
 02-01-003-G
 SCAN# 45085

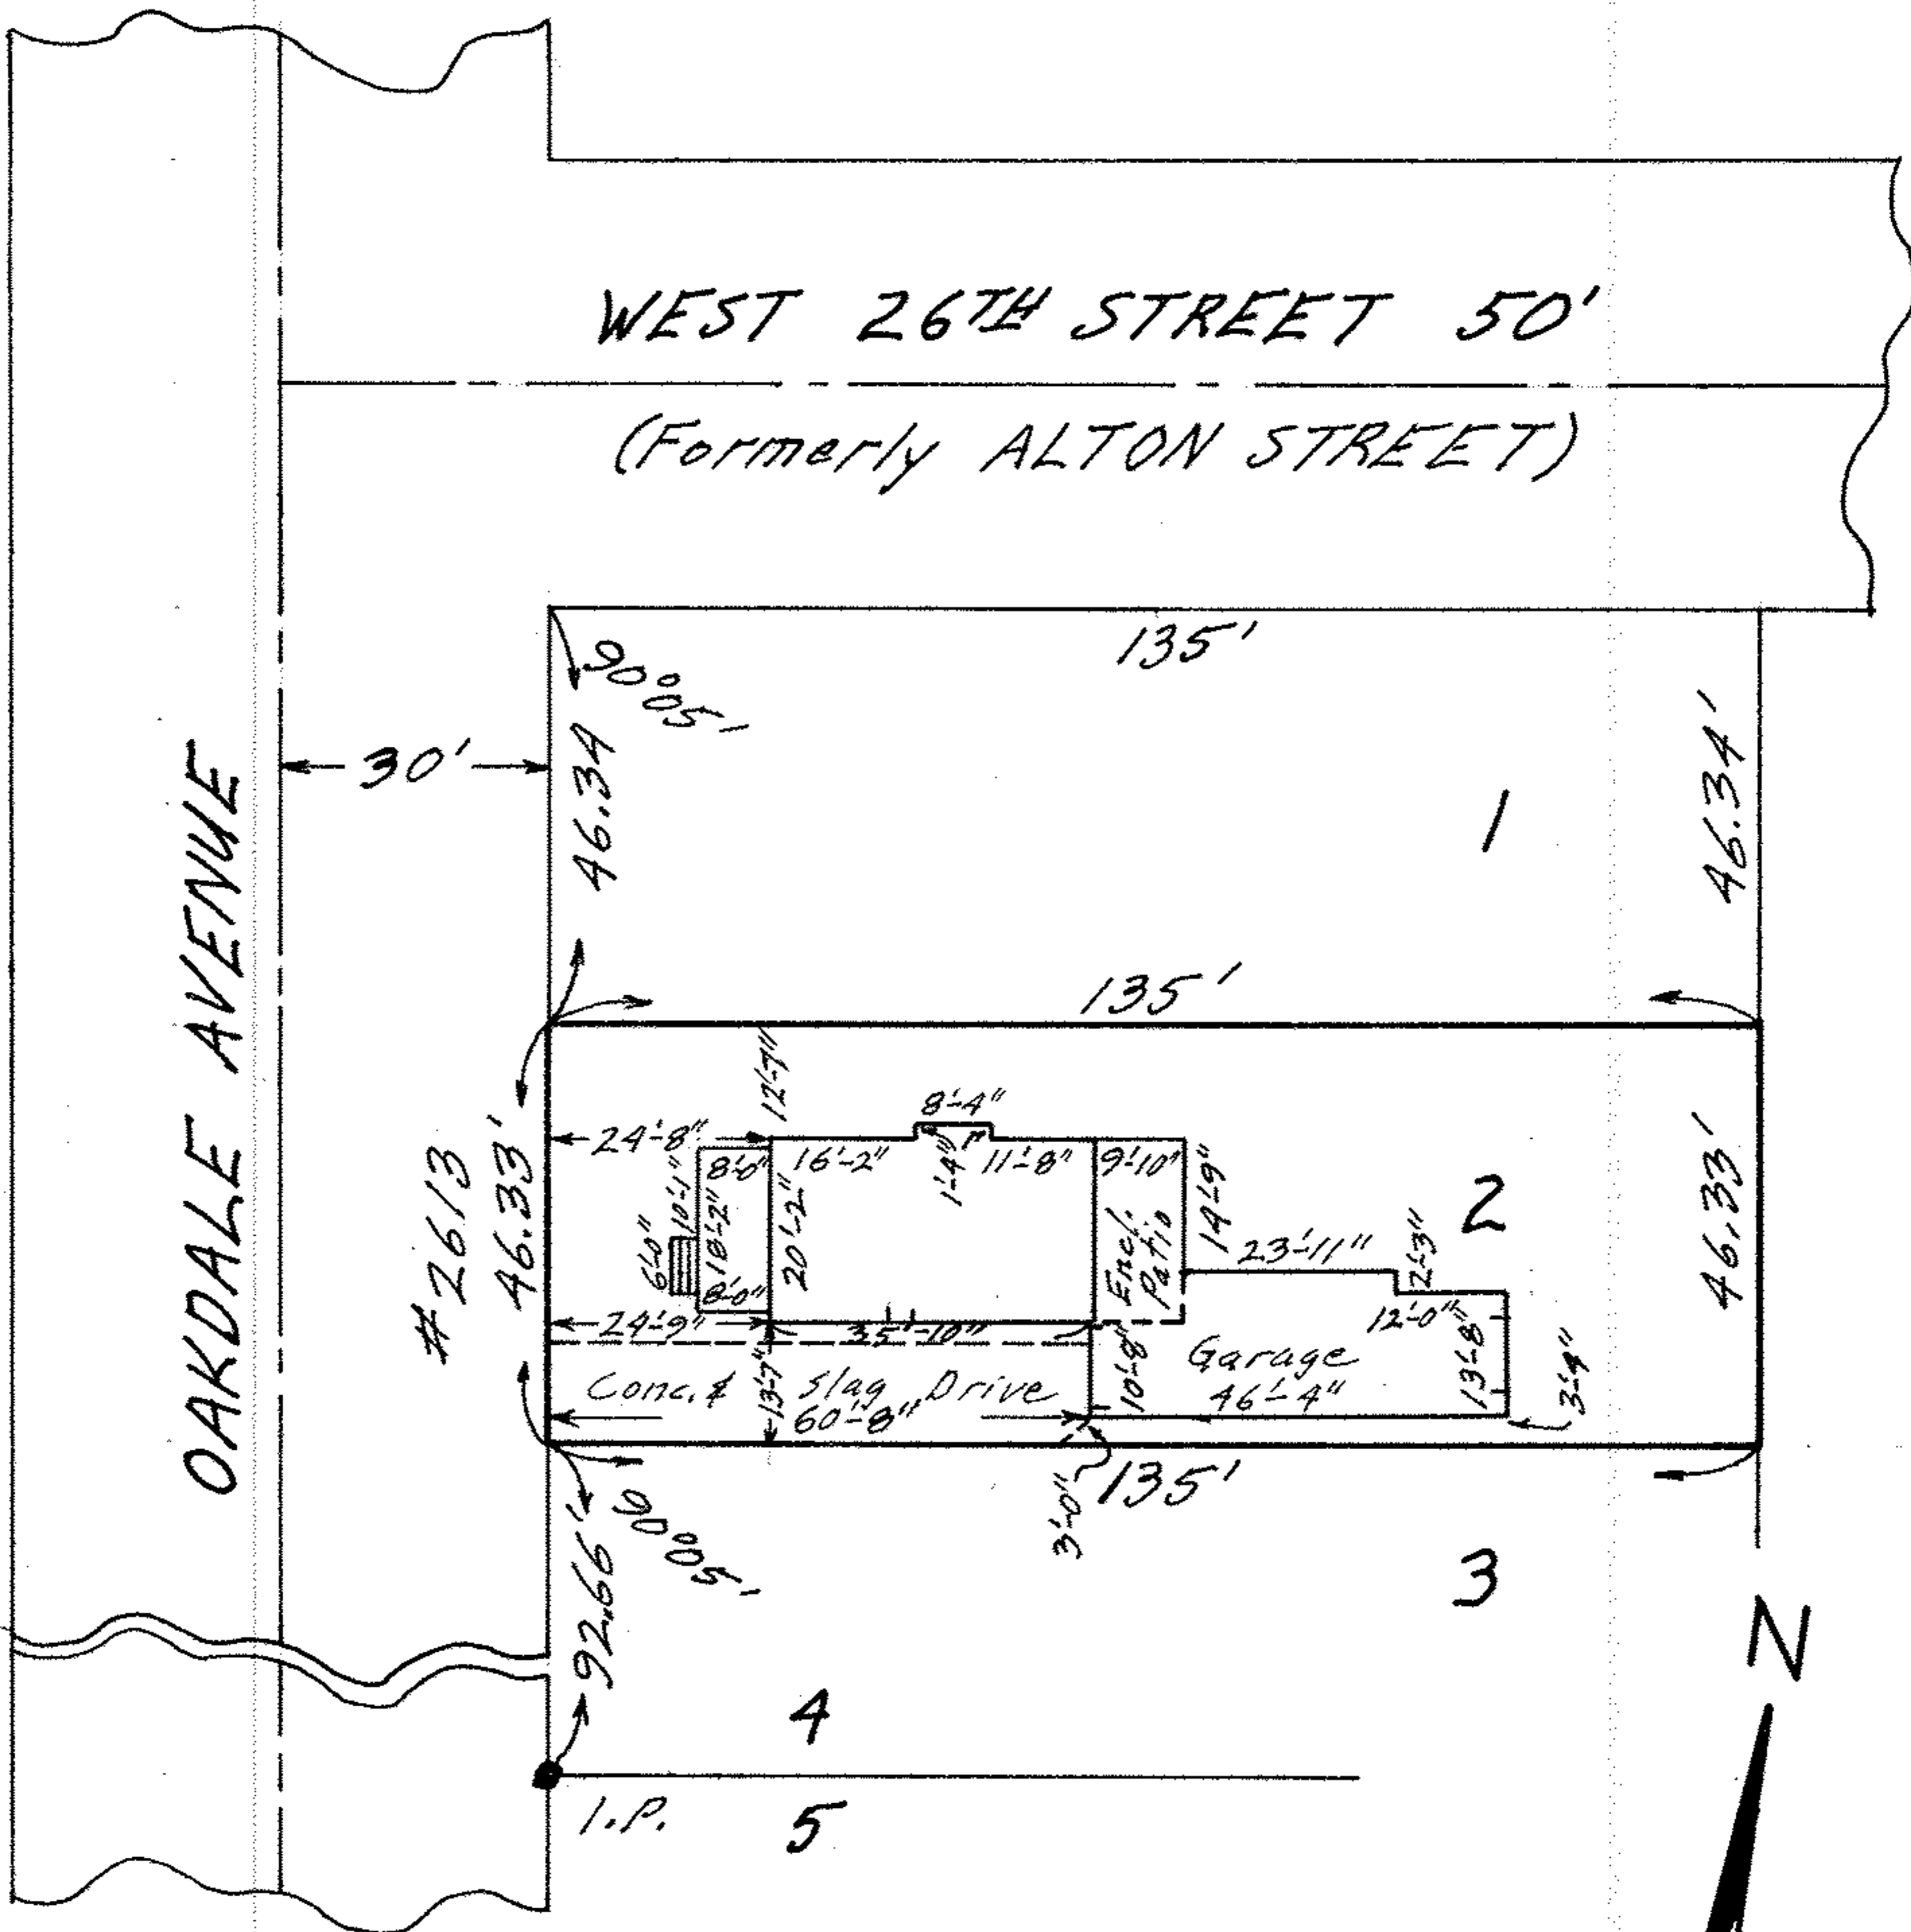

MAP OF SUB-LOT NO. 2

H.O. WOOD'S ADD'N. VOL. 4 PG. 42 PLATS
 ORIG. LOT 3 - TRACT 1 - BLACK RIVER TWP.
 LORAIN CITY - LORAIN COUNTY - OHIO
 SCALE: 1" = 30' AUG. 8 - 1969 2:45 P.M.

NOTE: There are no encroachments on the above property.
 Gary E. Penfound REG. SURVEYOR NO. 4457

CITY TITLE Co. Order No. E-763-A
 Francisco Corsino to Milton Velazquez