


02-01-003-190-023  
02-01-003-G  
SCAN # 45086



WEST 27TH STREET 50'  
(HOYT ST.)

Stone Fd. in Mon. Box

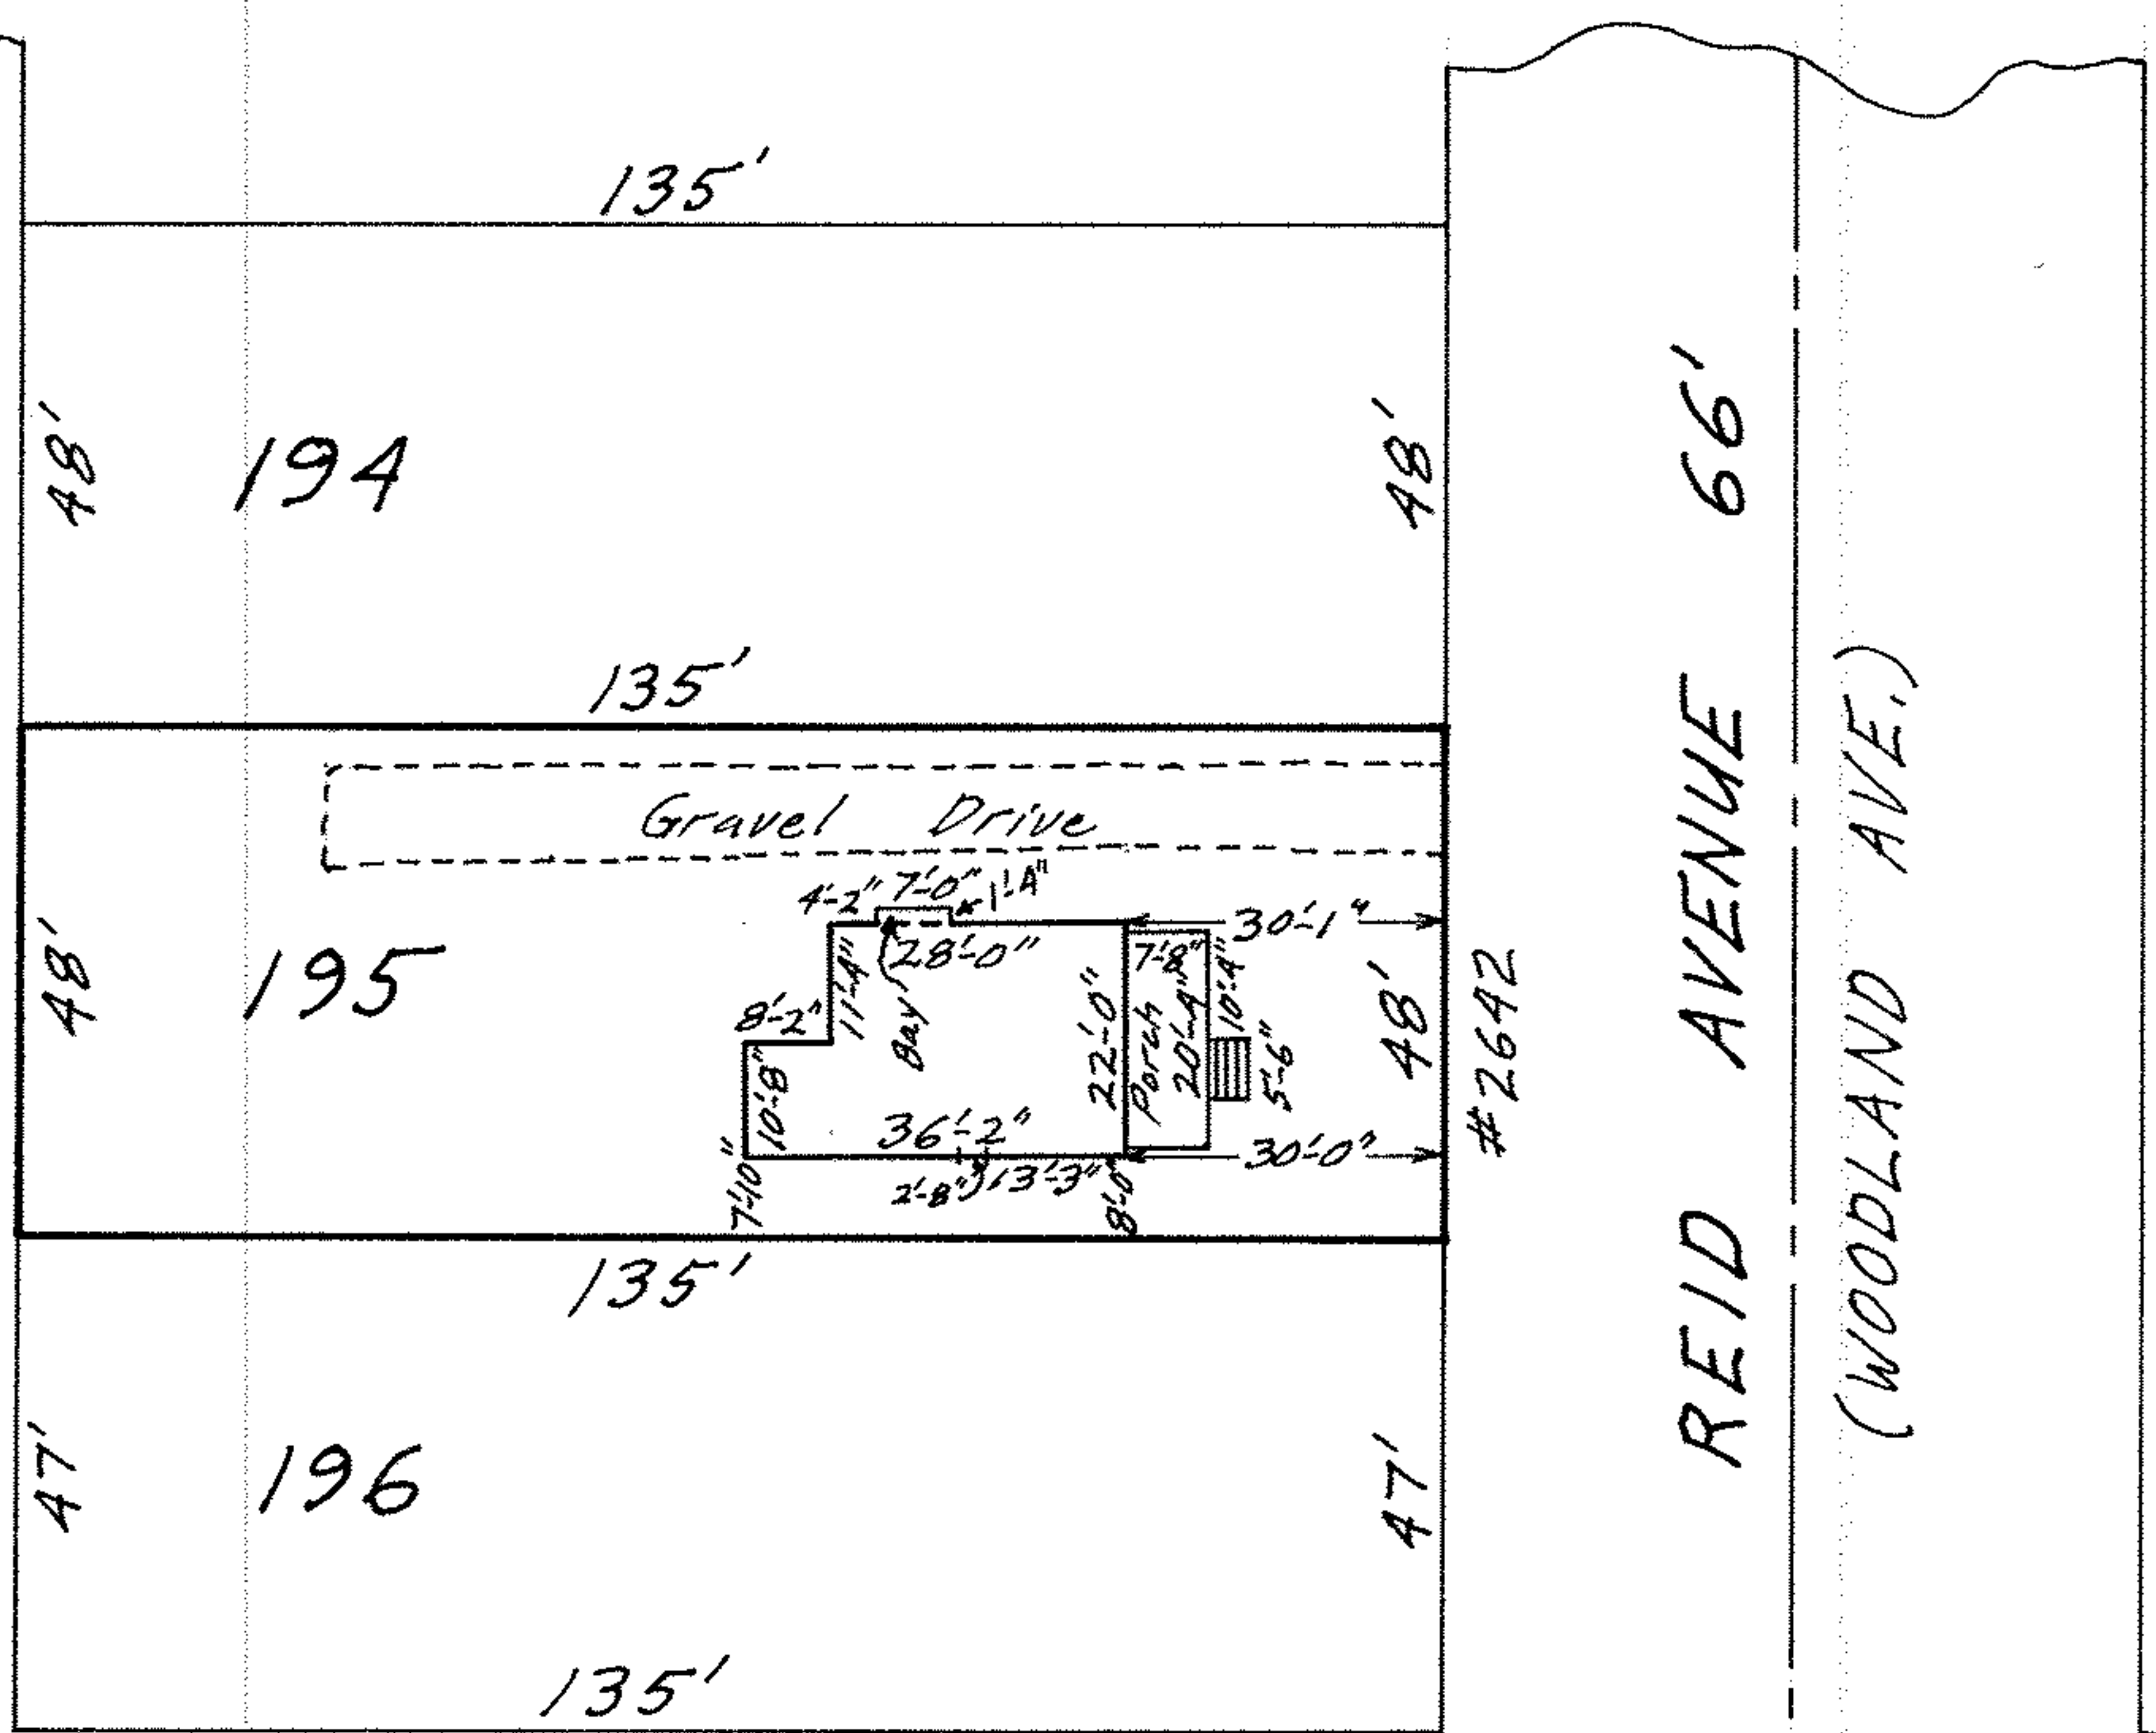

MAP OF SUB-LOT NO. 195  
THE BRASS COMPANY'S ADD'N. Vol. 4 Pg. 35  
ORIG. LOT 3 - TRACT 1 - BLACK RIVER TWP.  
LORAIN CITY - LORAIN COUNTY - OHIO  
SCALE: 1"=30' APRIL 11-1966 7:00 P.M.  
Gary E. Penfound REG. SURVEYOR

John J. Akosi, Jr. & Anna Akosi  
Parcel No. 2