
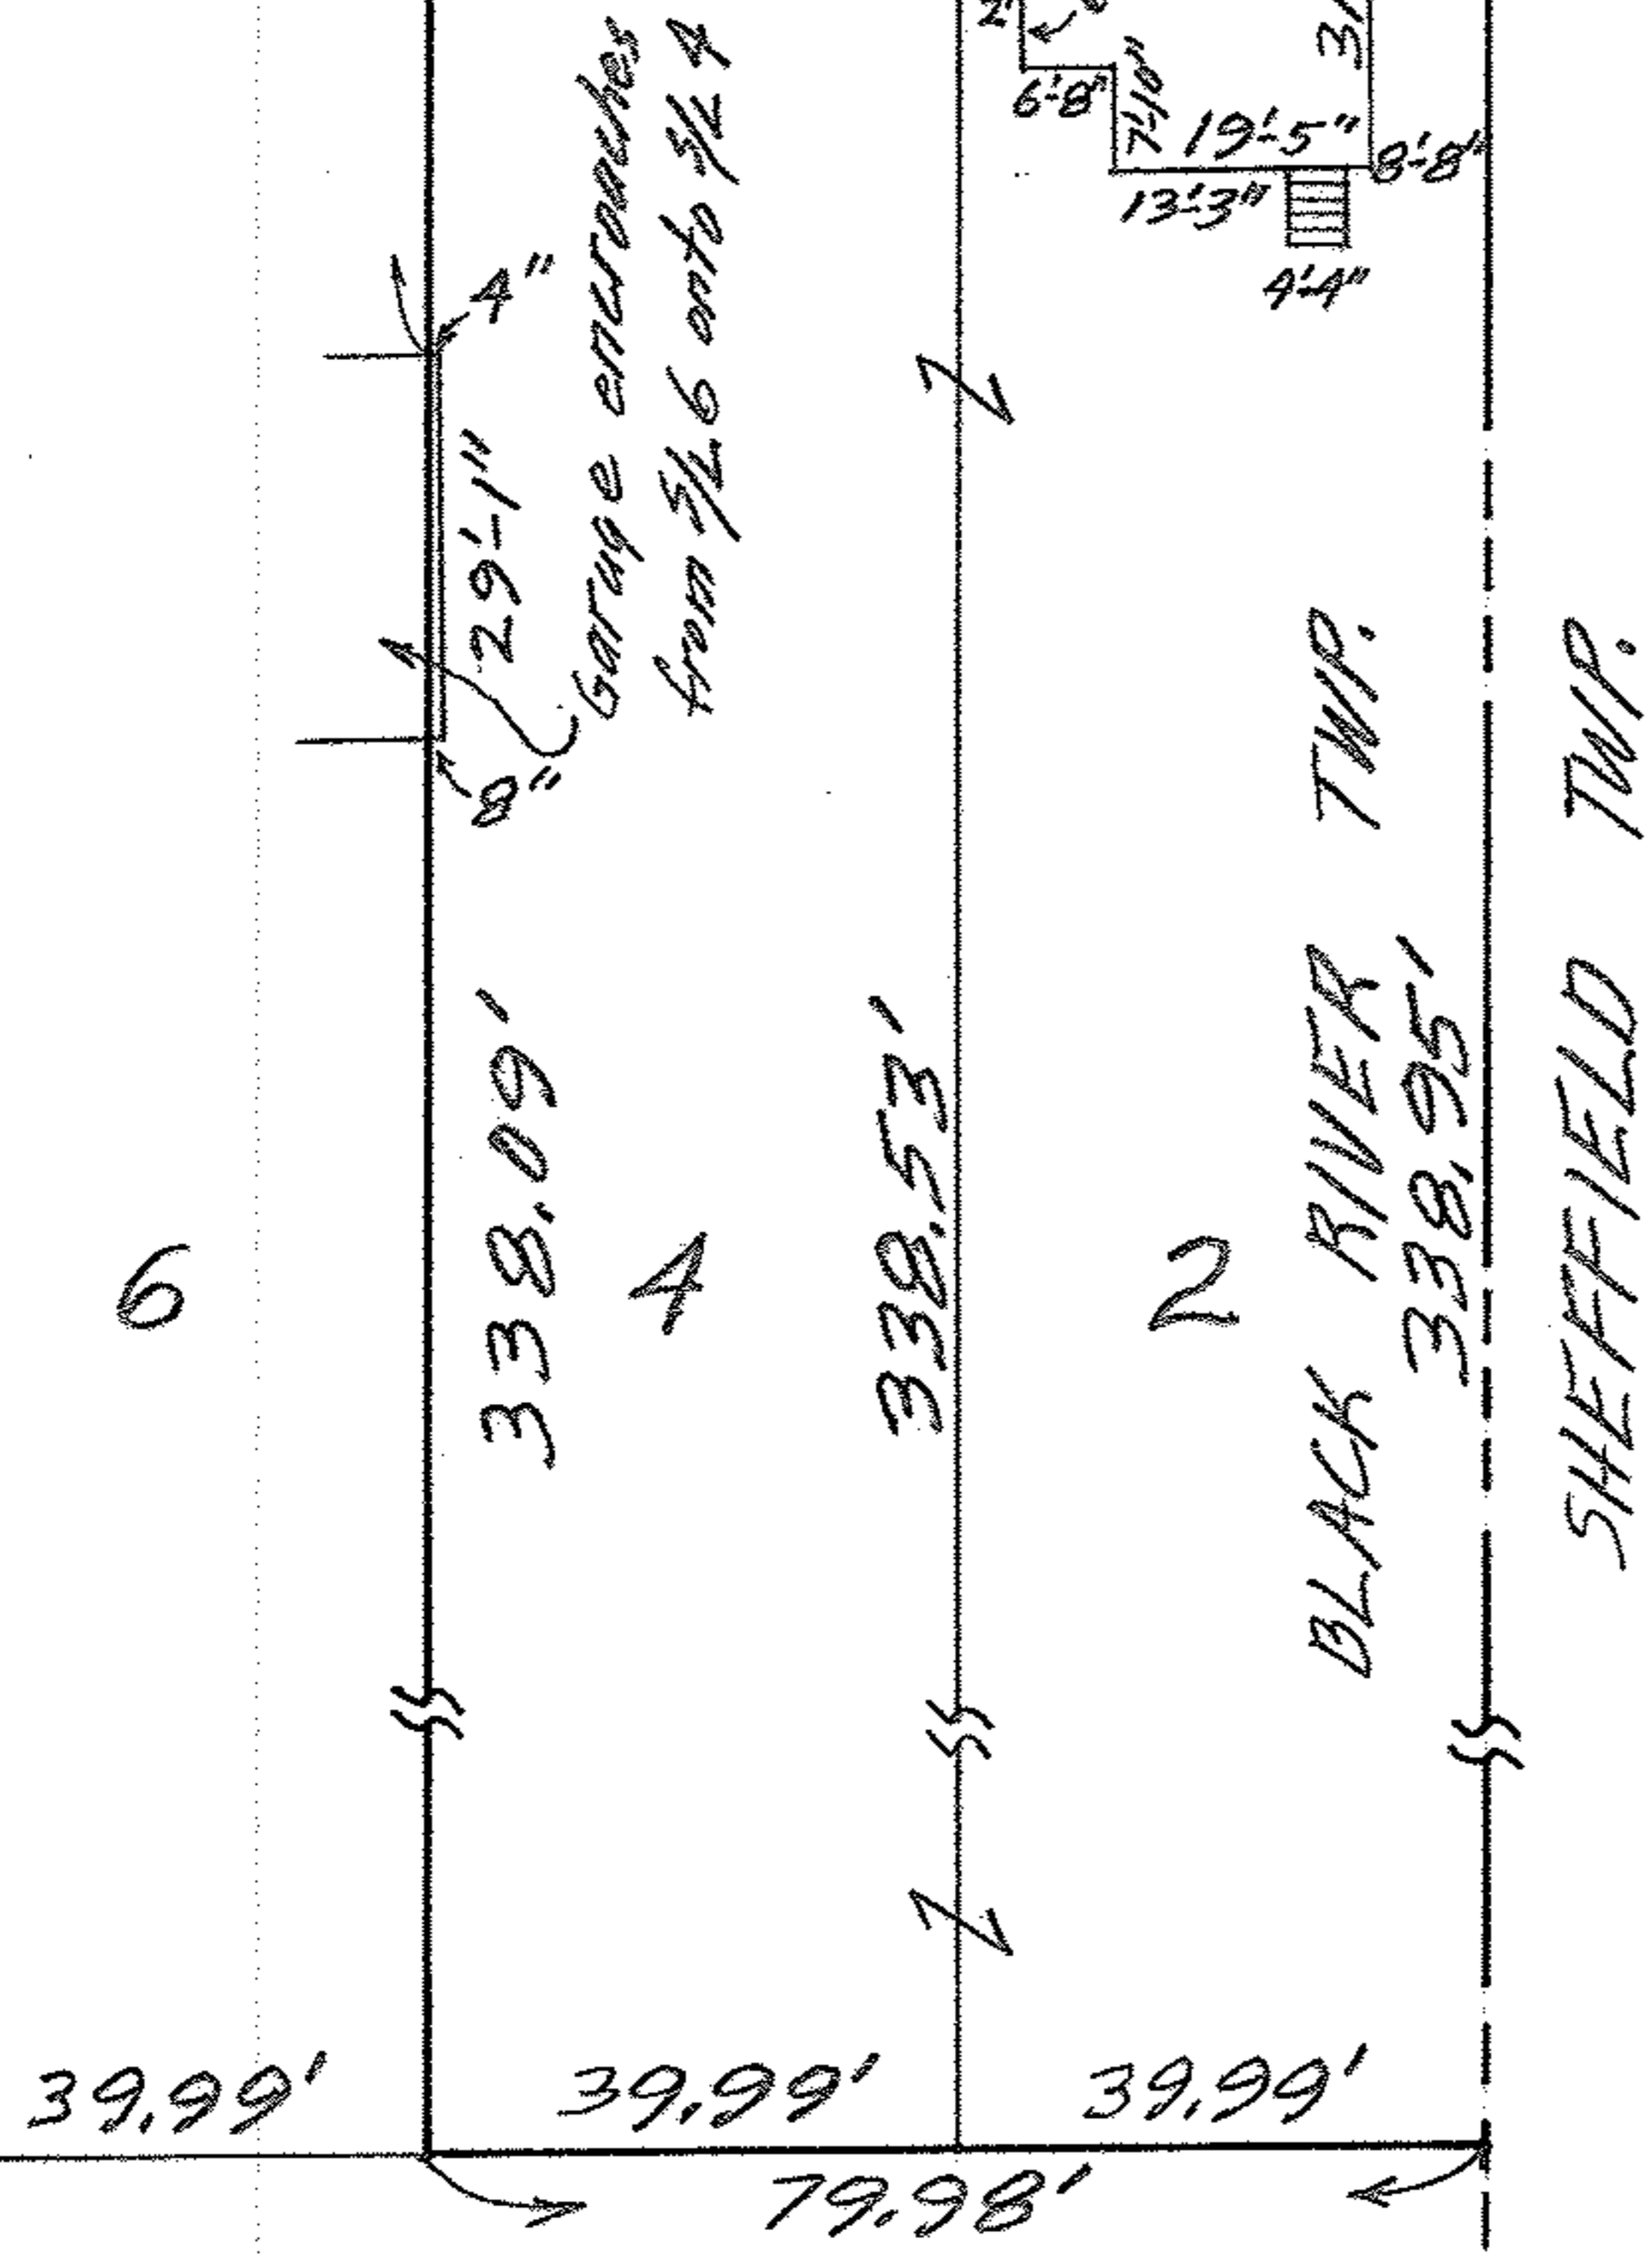
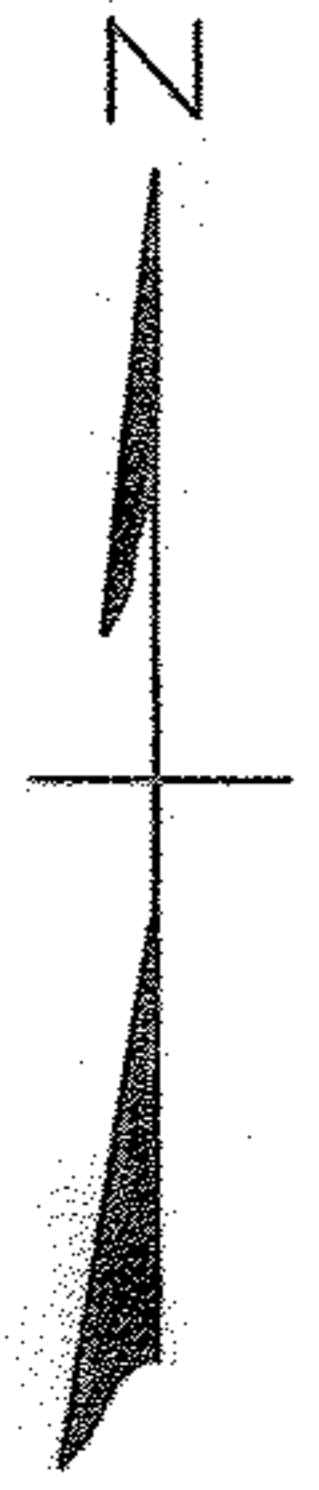


02-01-003-262-023,022

02-01-003-L  
SCAR #45090

JEFFERSON STREET 50'

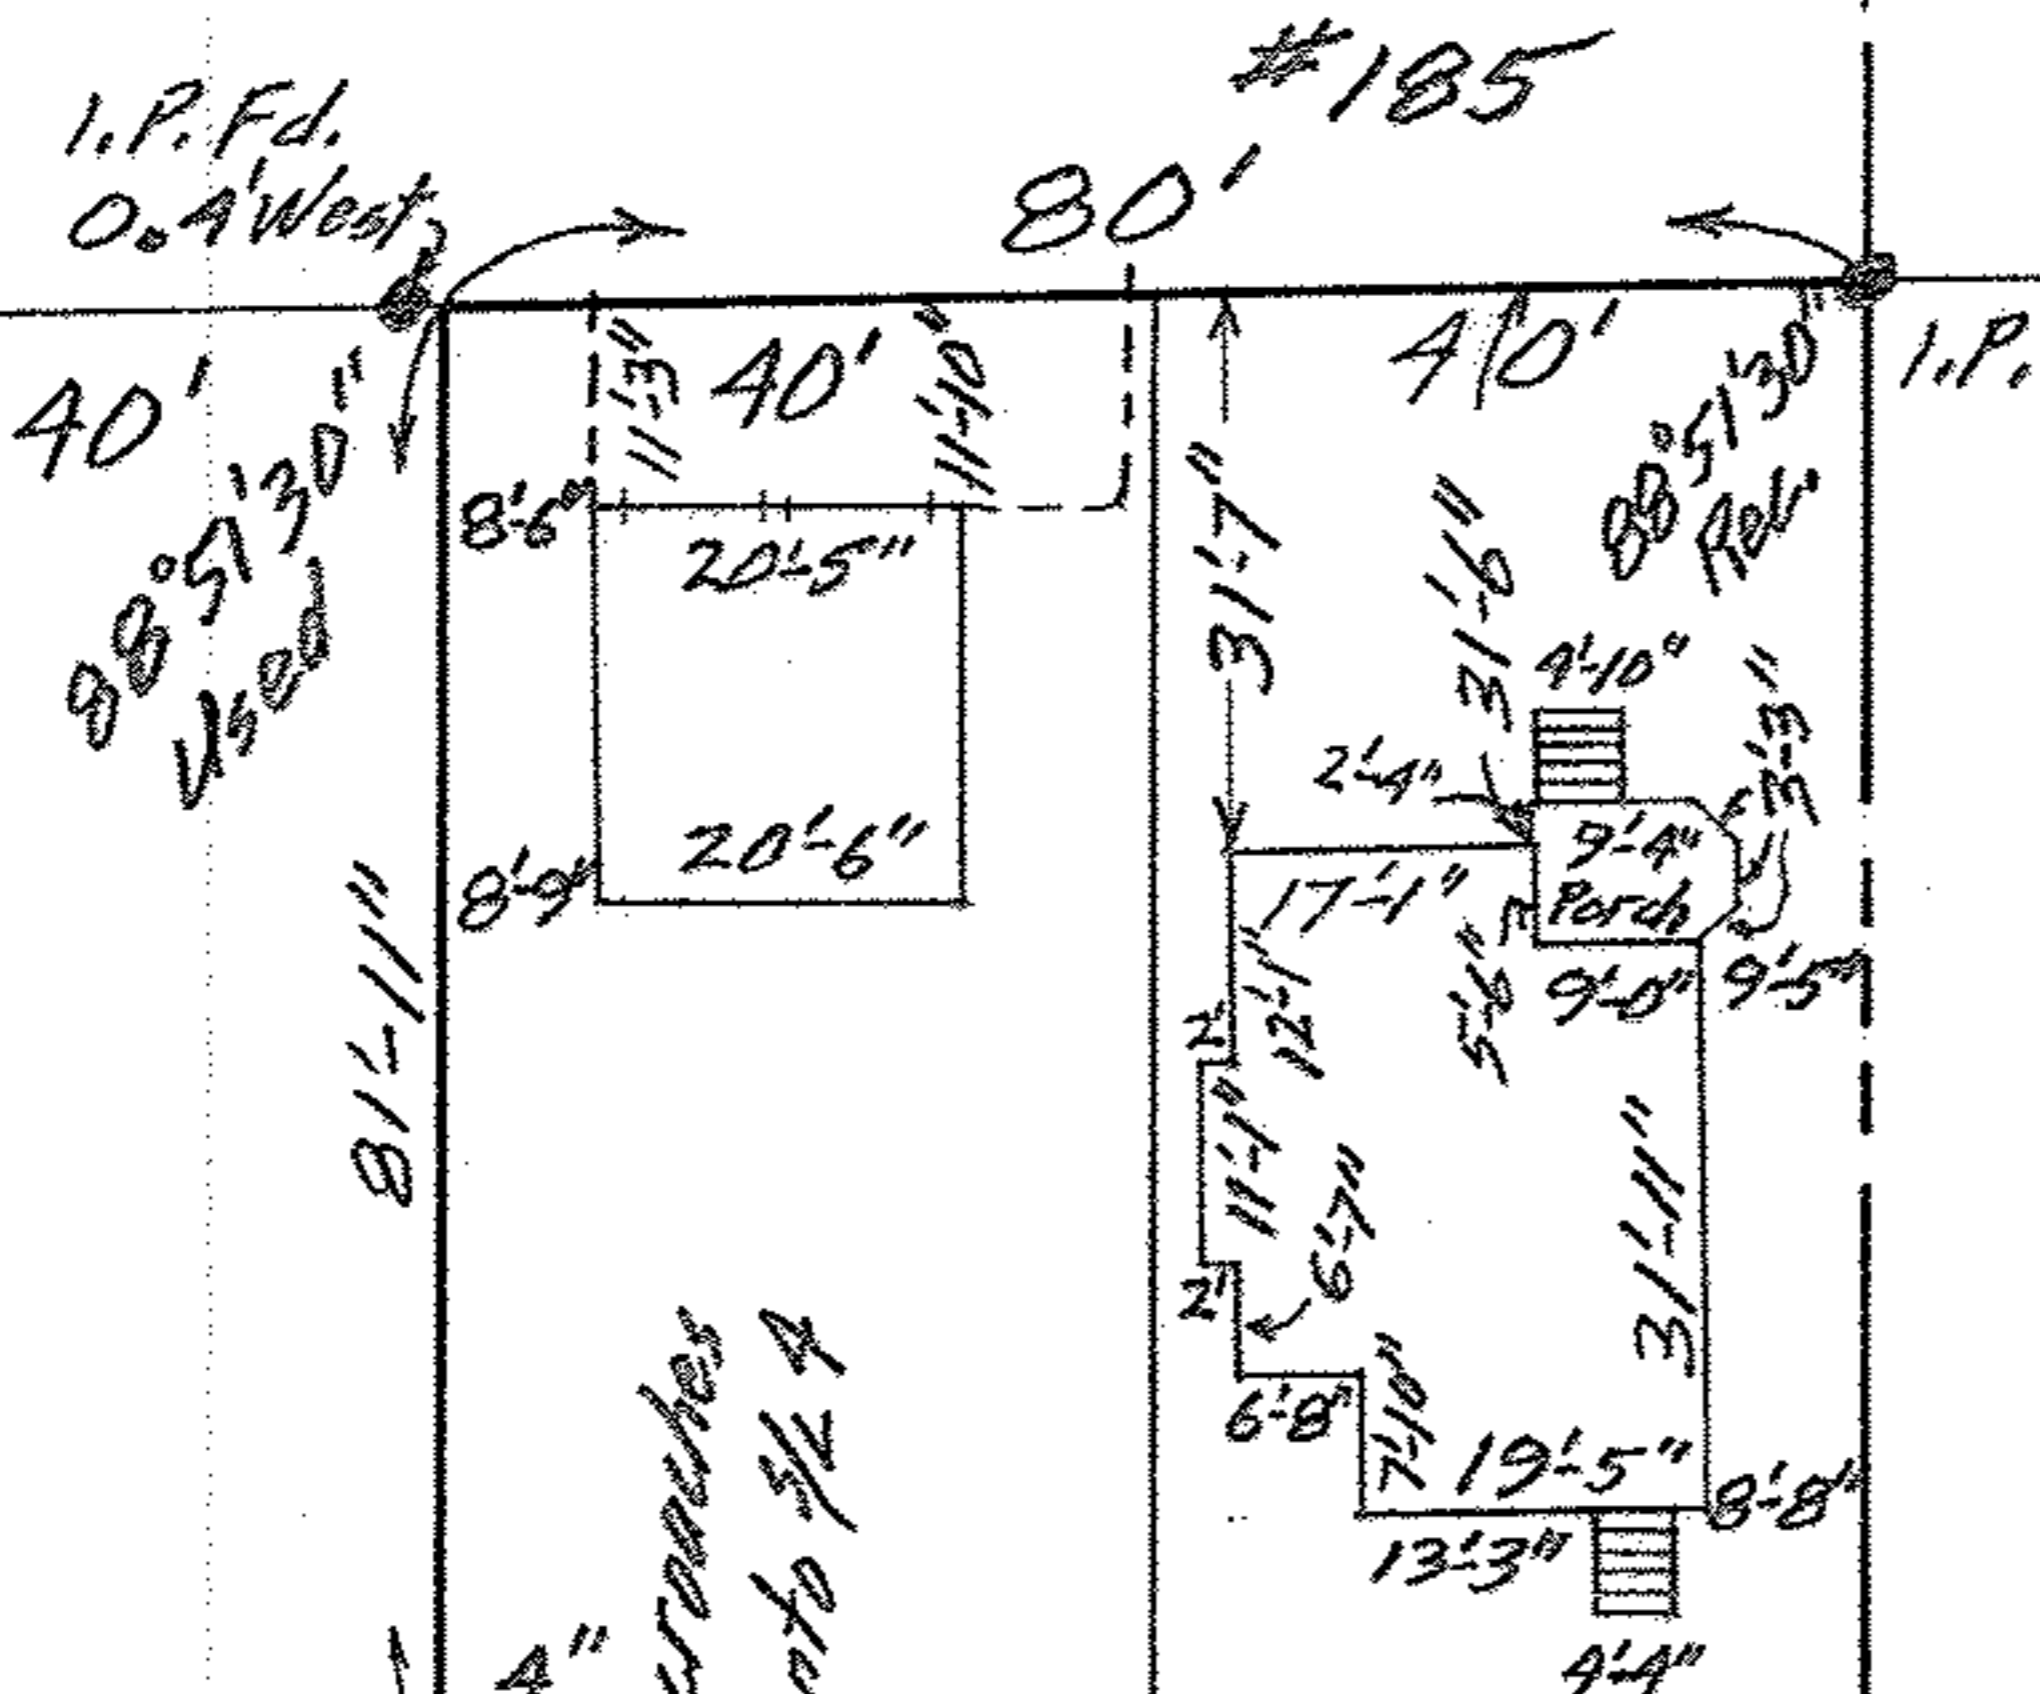

MAP OF SUB-LOTS NOS. 2 & A  
 PETER REUTERS SUB'N. Vol. 7 Pg. 38  
 ORIG. LOT 3 - TRACT 1 - BLACK RIVER TWP.  
 LORAIN CITY - LORAIN COUNTY - OHIO  
 SCALE: 1" = 30' OCT. 25-1965 4:00 P.M.  
 Gary E. Penfound  
 for C.E. Penfound REG. SURVEYORS

PENFIELD AVENUE  
 (aka SOUTH BROADWAY)

GL-1293 Nicholas Musulin

02-01-003