



# NEW DOCKLINE SURVEY FOR CUT # 1 P-1 to P-9

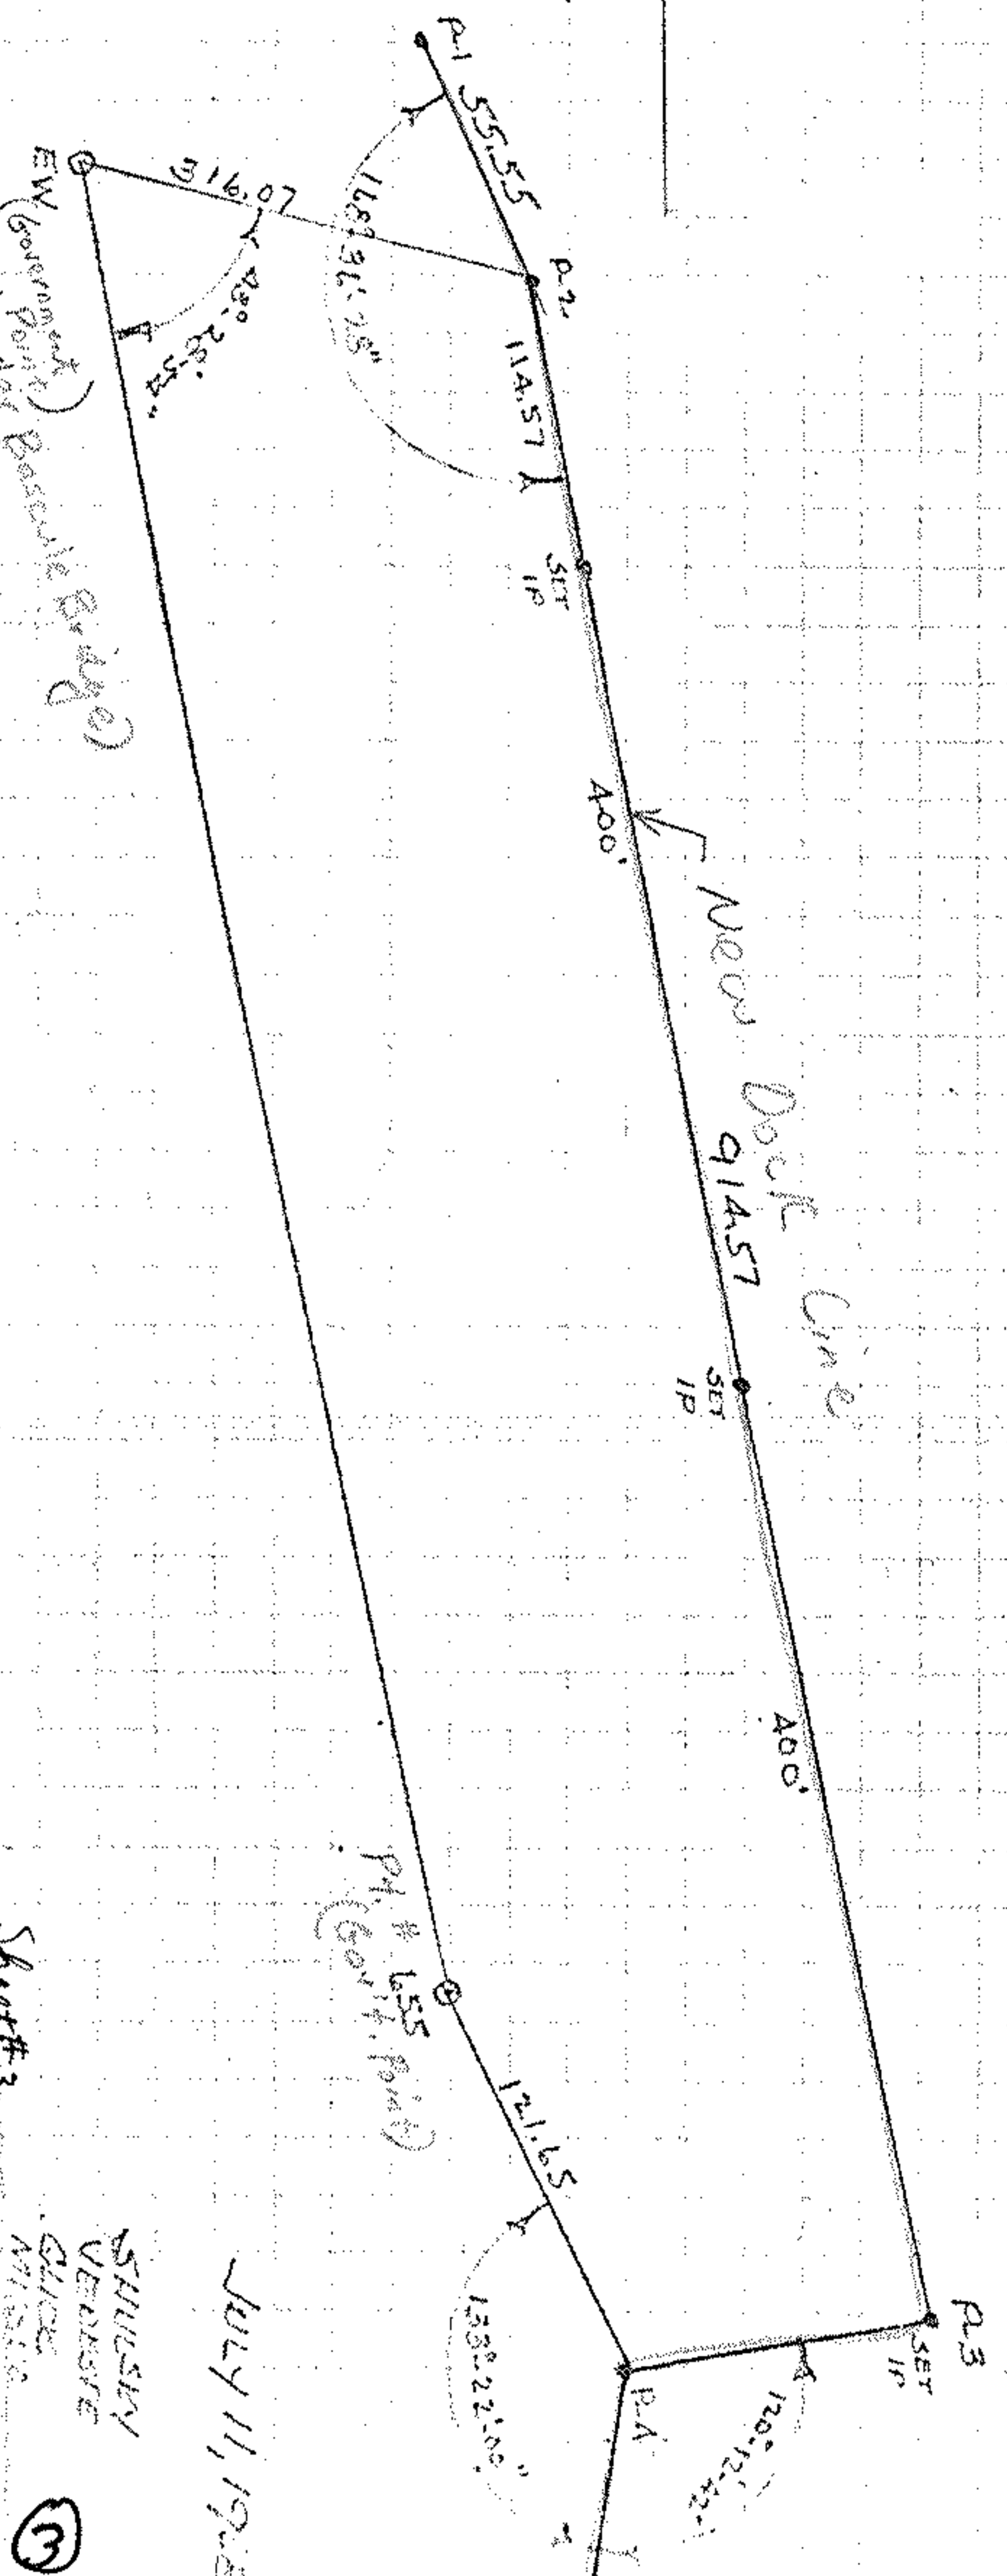

BECK RIVER  
Old Dock Line

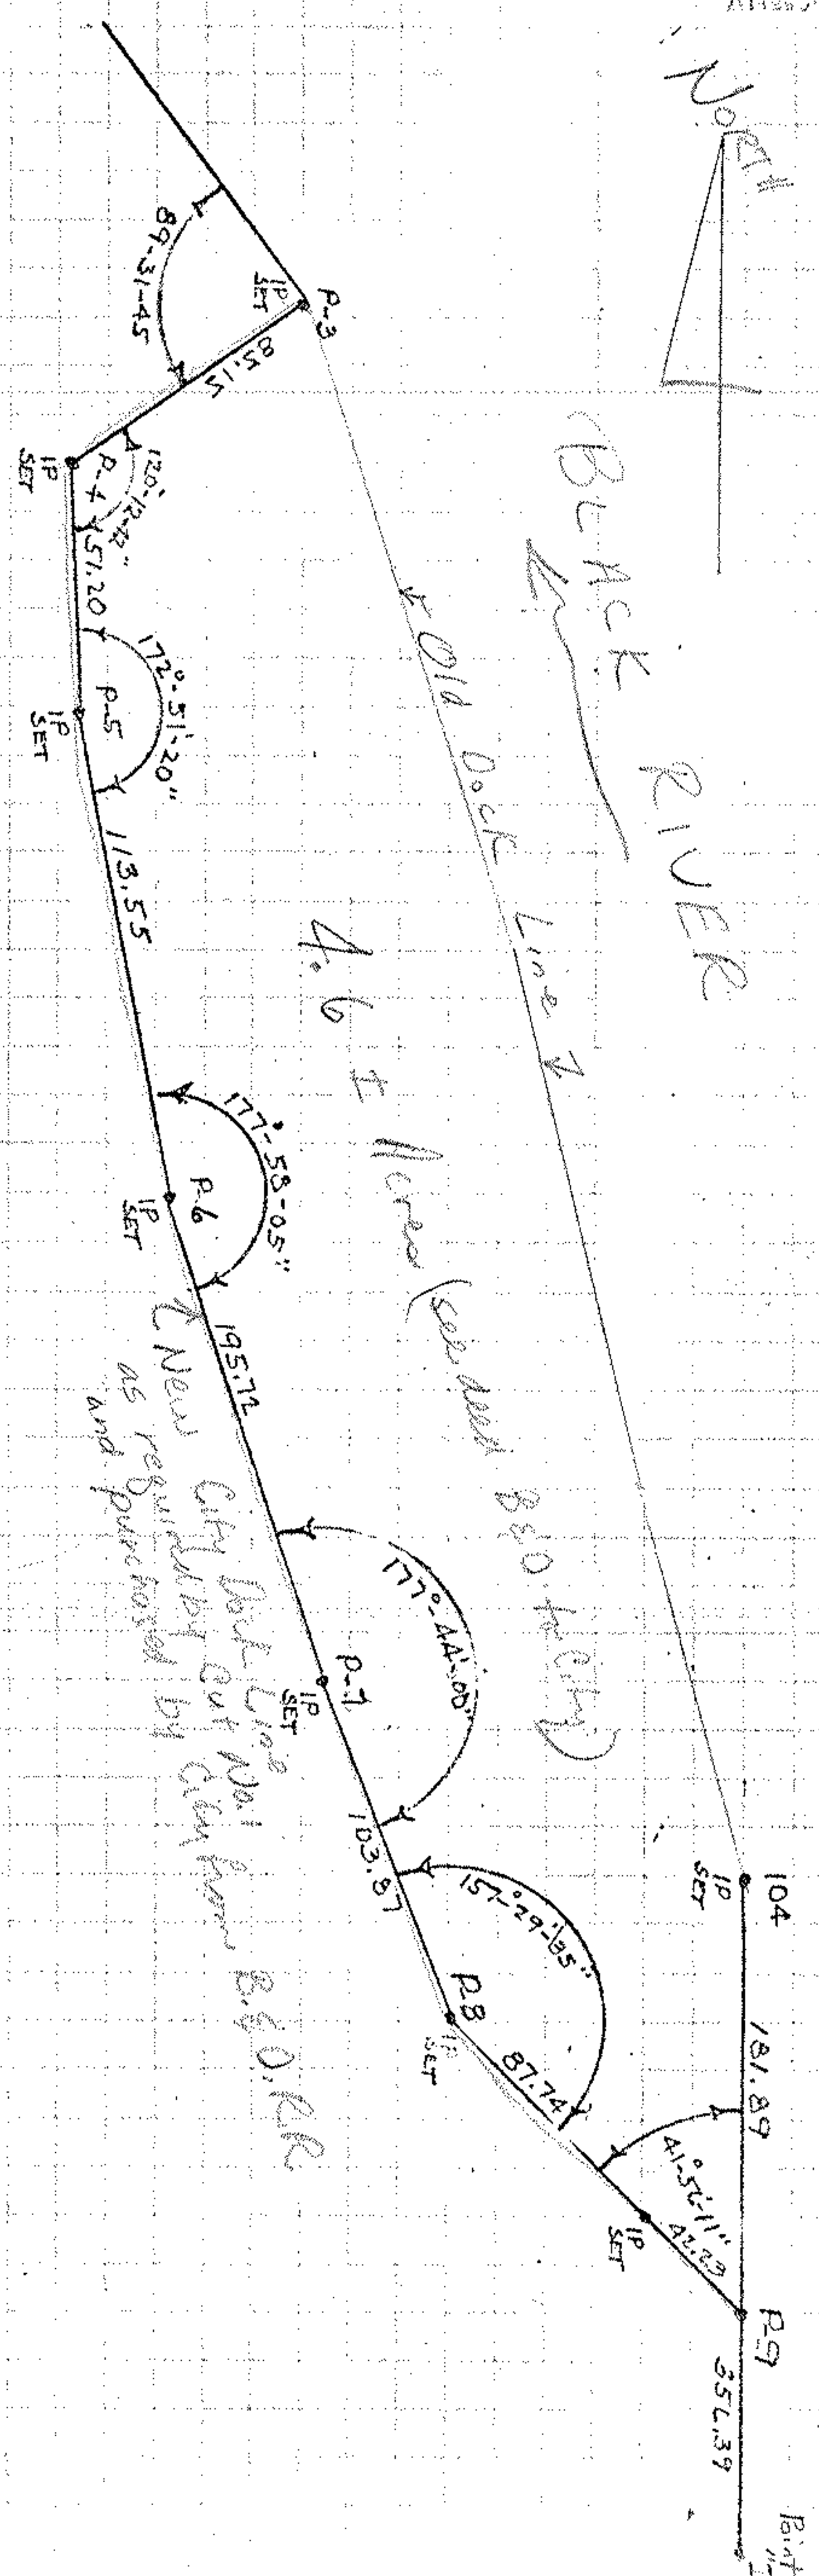

July 11, 1928

Sheet # 3

③