


02-02-004-101-058
 02-02-004-6
 SCADA 45131

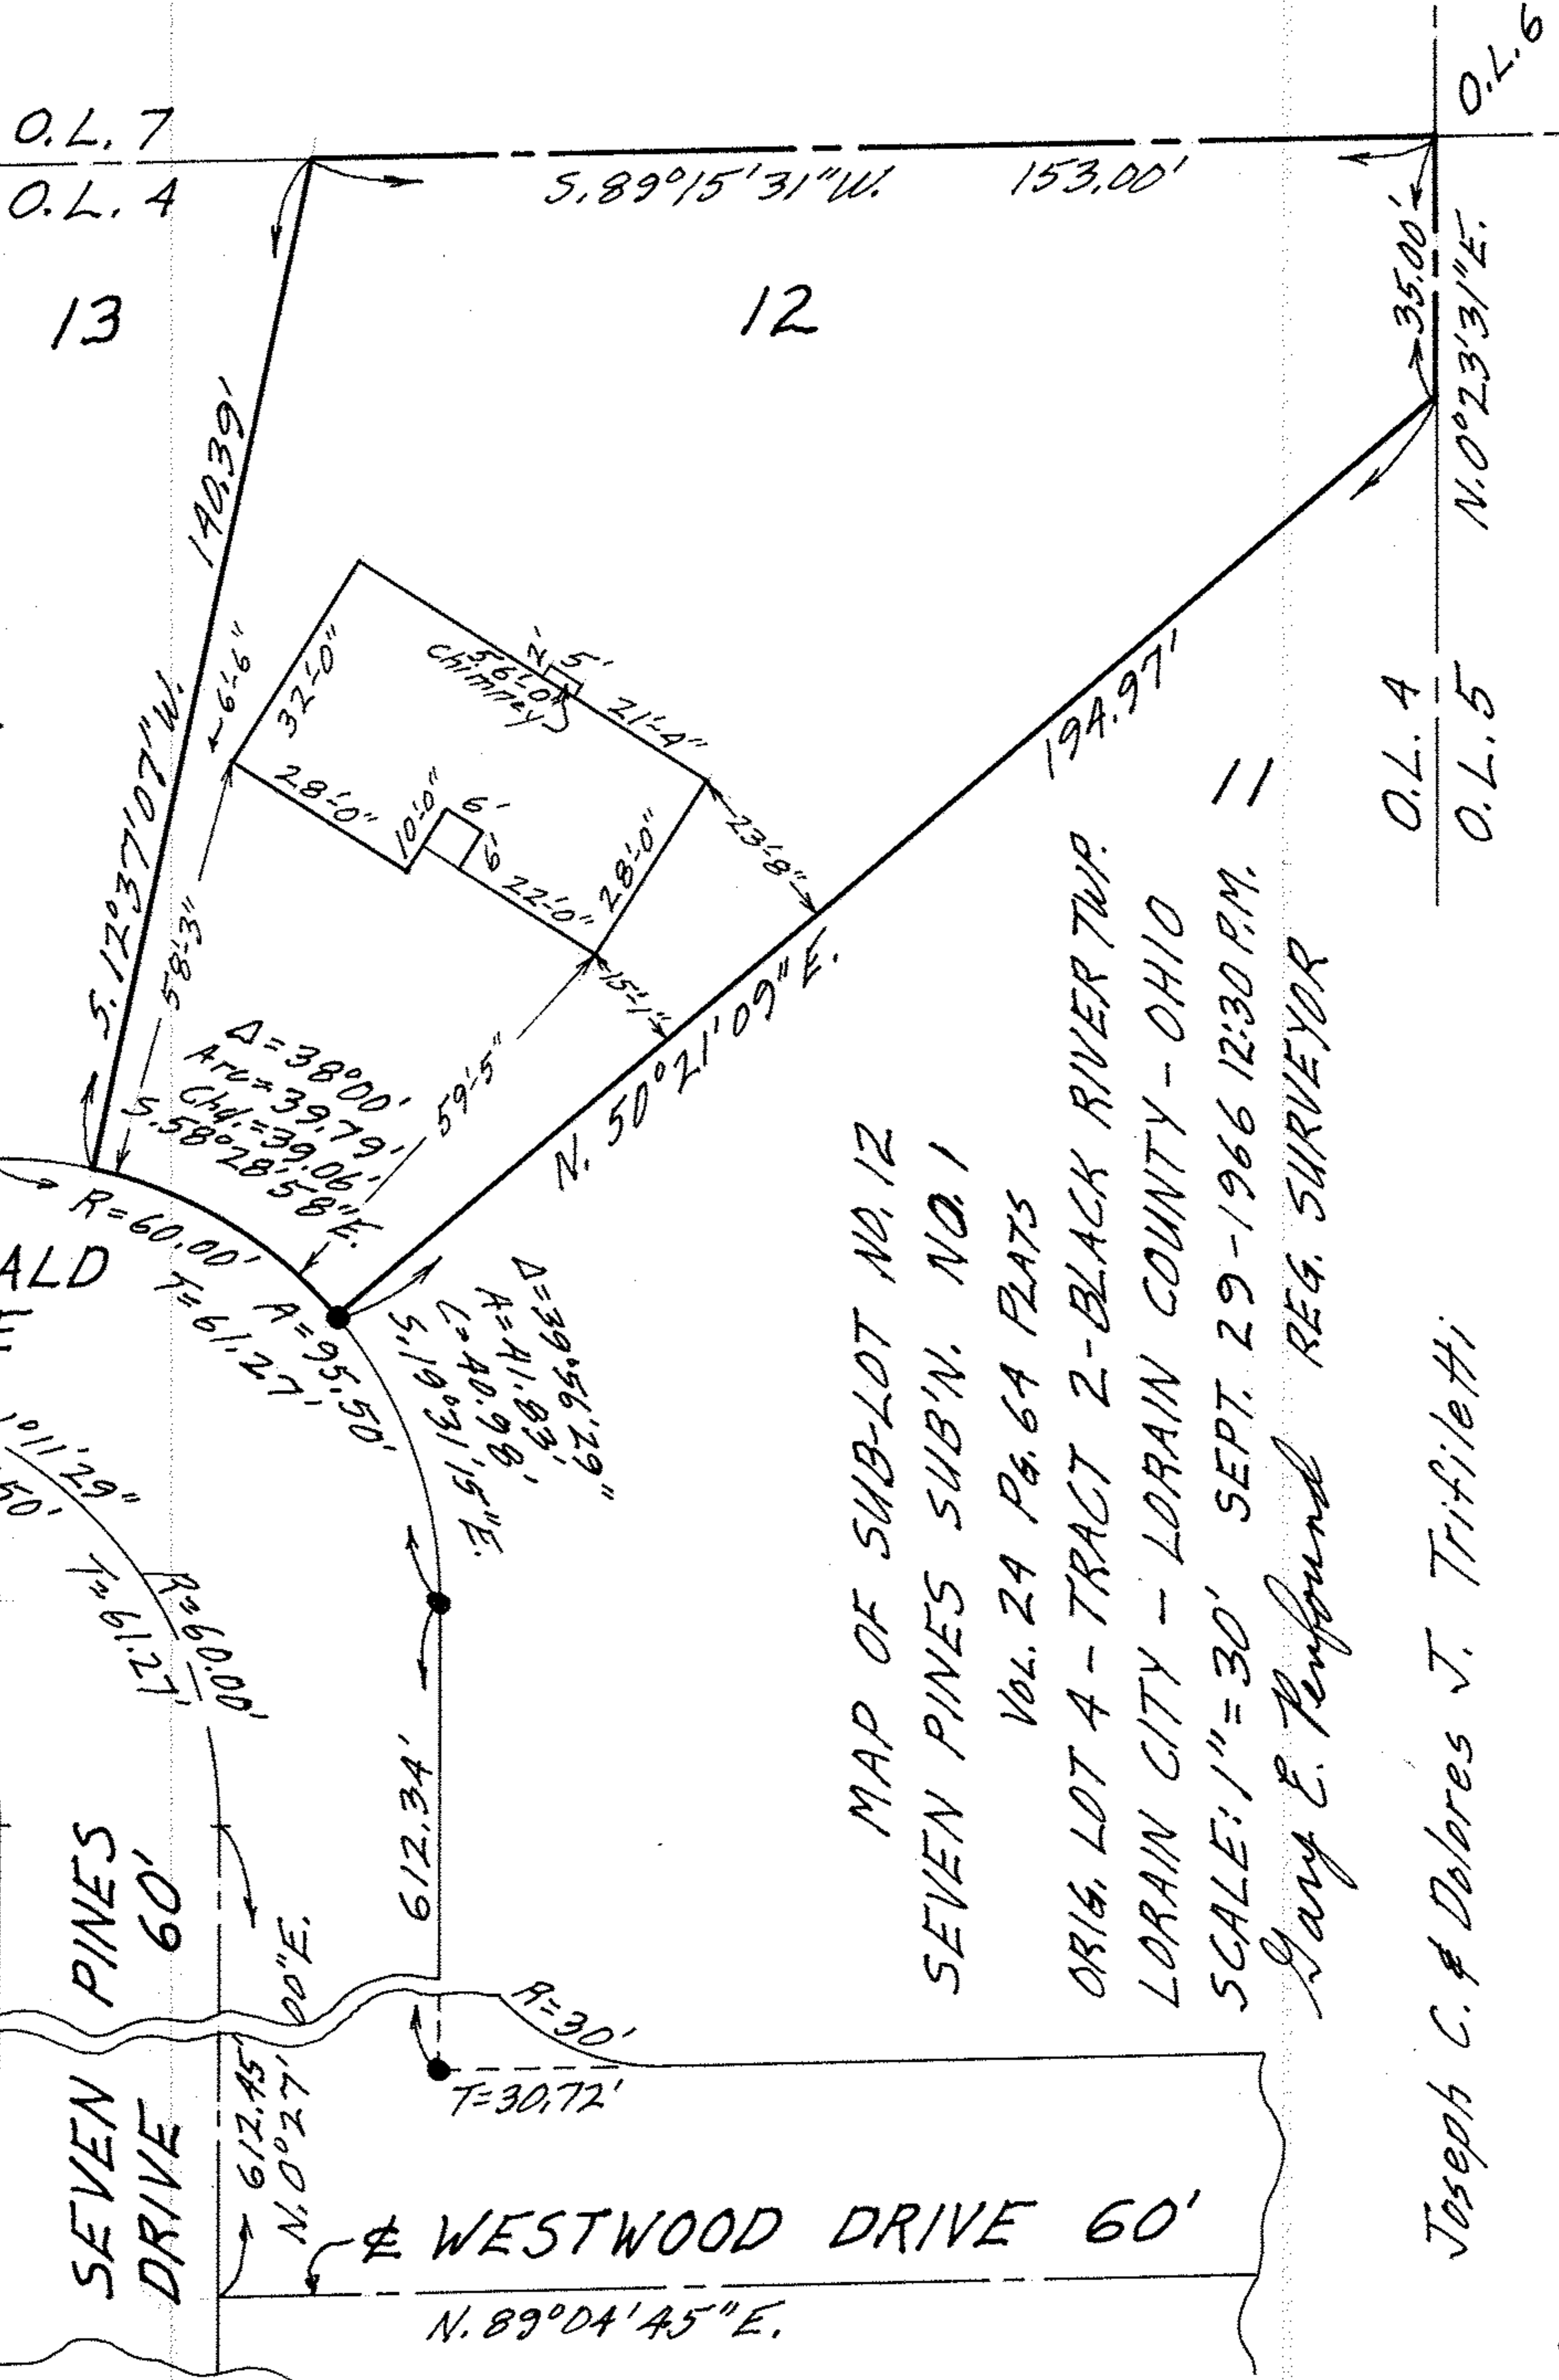

MAP OF SUB-LOT NO. 12
 SEVEN PINES SUB'N. NO. 1
 VOL. 24 PG. 64 PLATS
 ORIG. LOT 4 - TRACT 2 - BLACK RIVER TWP.
 LORAIN CITY - LORAIN COUNTY - OHIO
 SCALE: 1" = 30' SEPT. 29 - 1966 12:30 P.M.
 Gary E. Penfound REG. SURVEYOR

Joseph C. & Dolores J. Trifiletti

02-02-004

BH