

07-02-0057107-007

02-02-005 A


SCAN# 45135



EDGEWOOD DRIVE 60'
Due North

WESTWOOD DRIVE 60'

N. 89° 21' E.

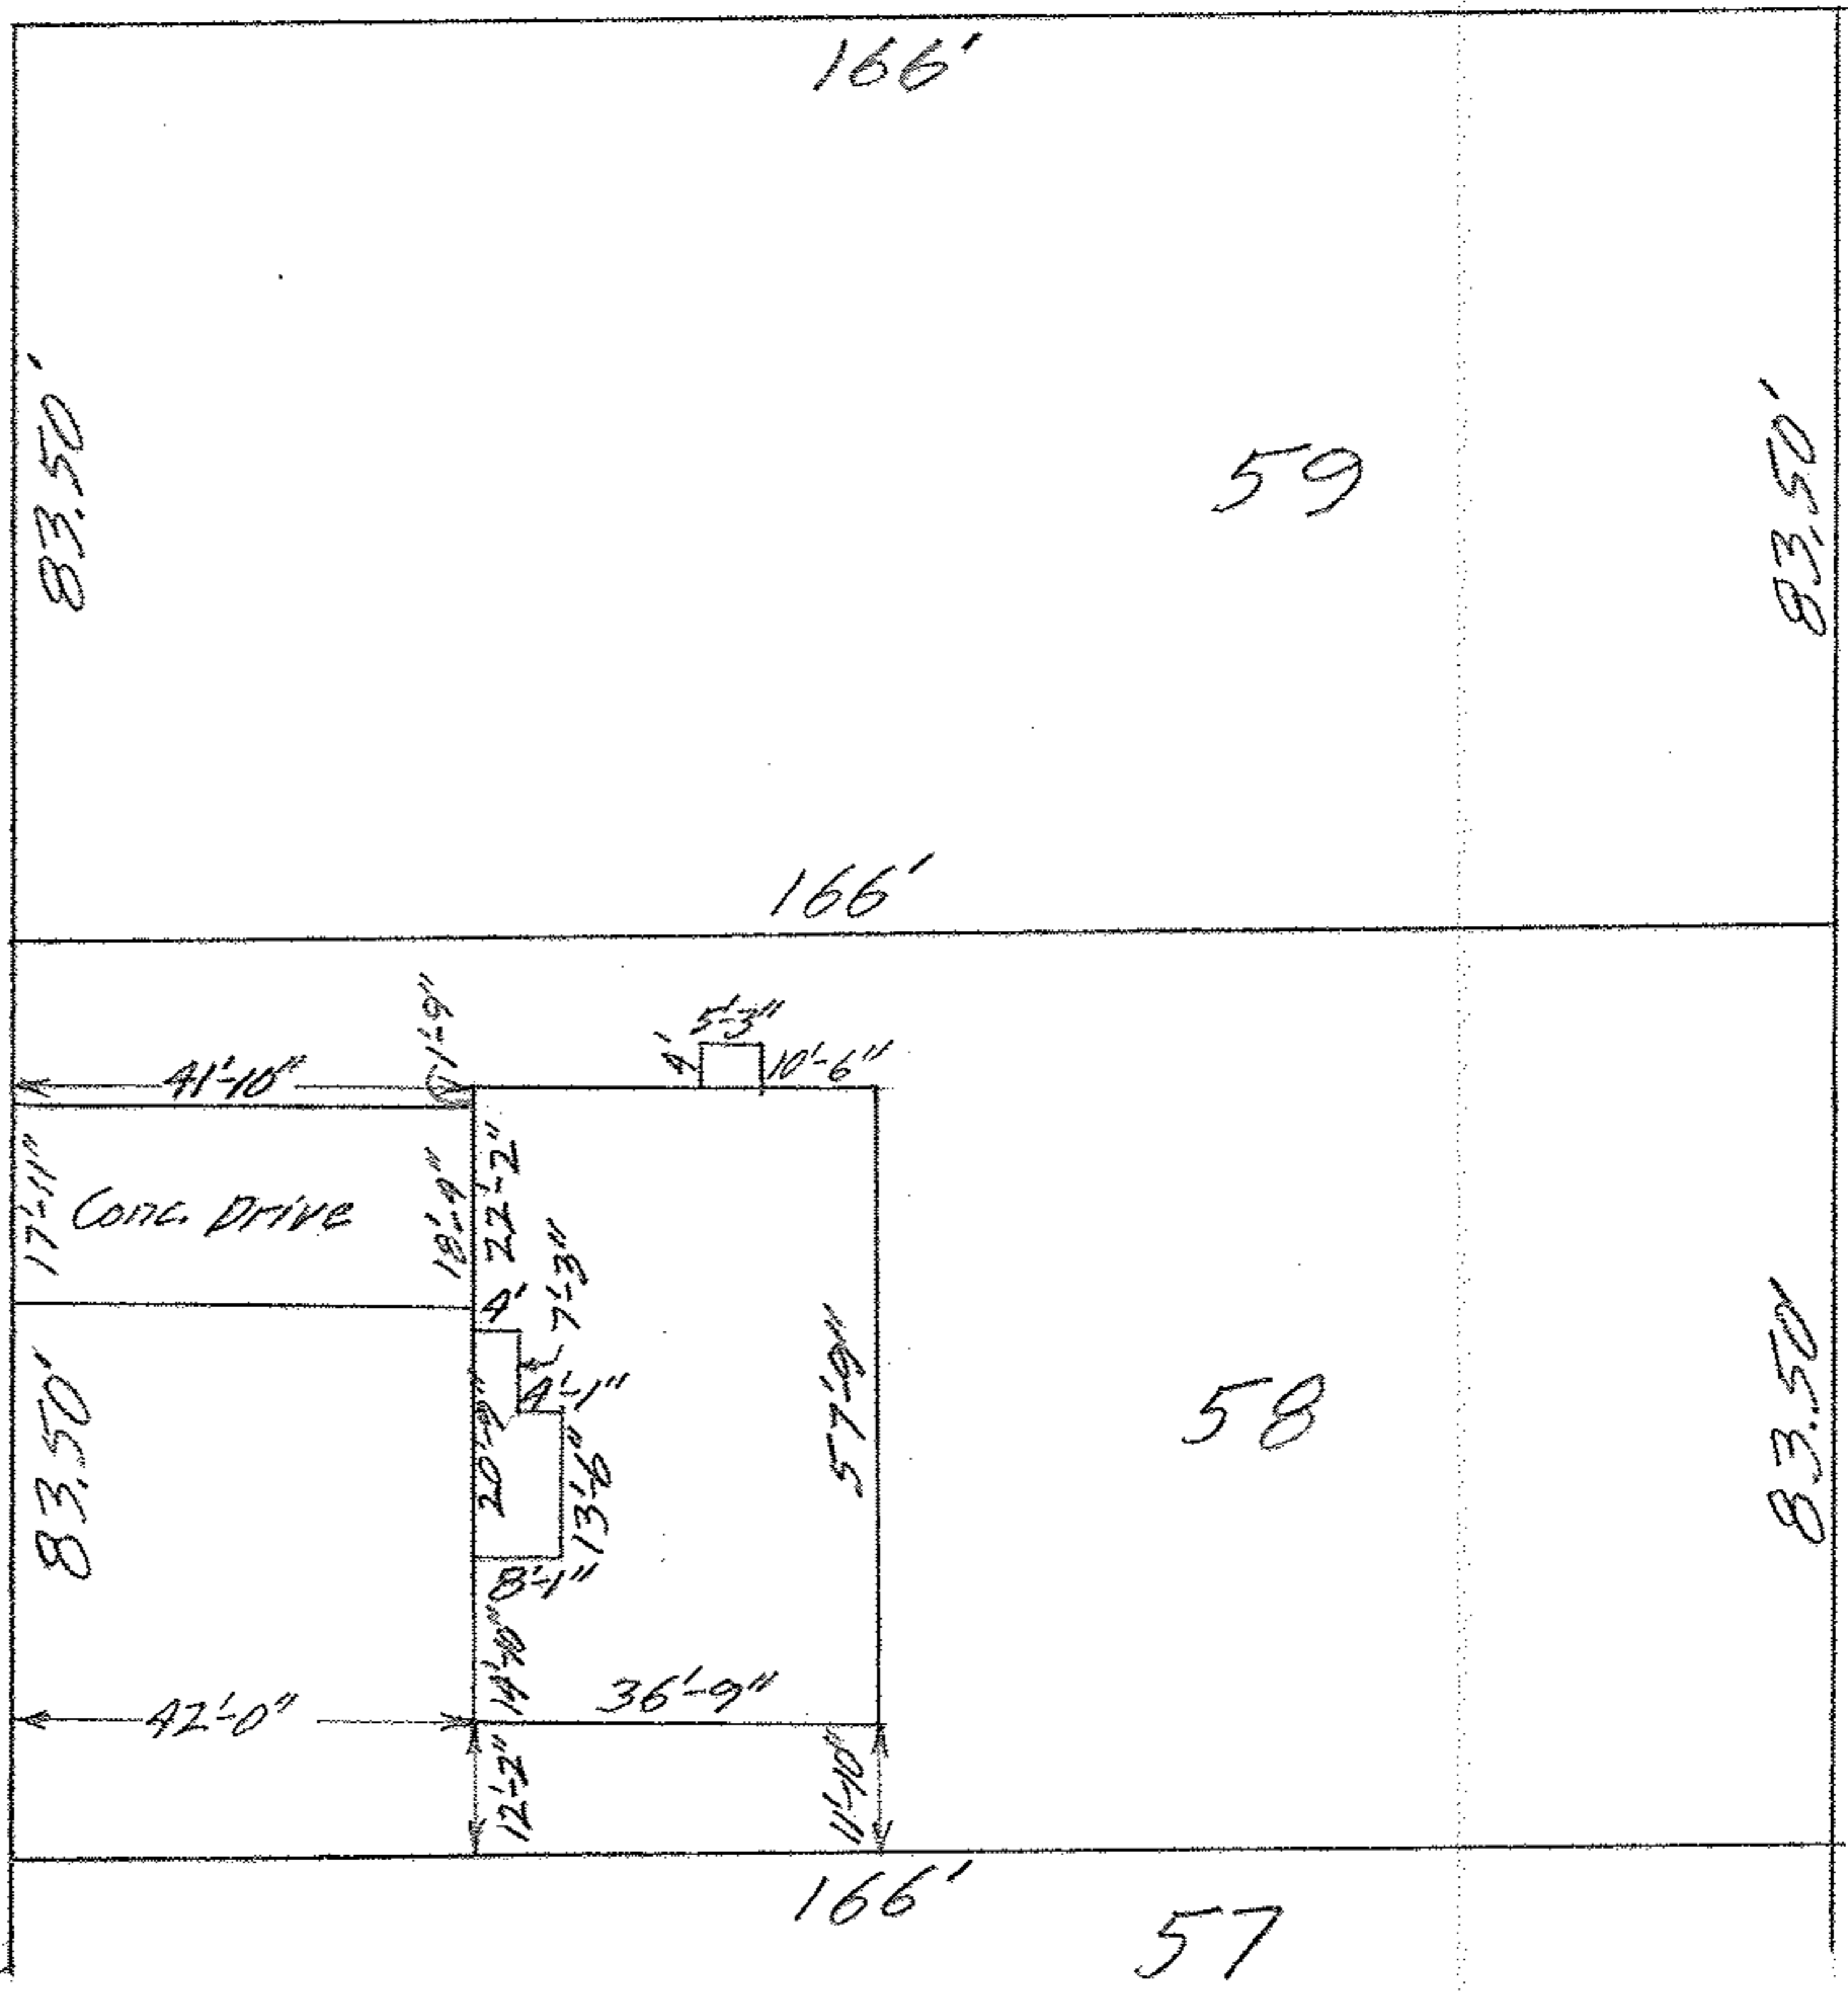

MAP OF SUB-LOT NO. 58
 PARKWAY SUB'N. NO. 3 VOL. 18 PG. 20 PLATS
 ORIG. LOT 5 TRACT 2 BLACK RIVER TWP.
 LORAIN COUNTY OHIO
 SCALE: 1" = 30' NOV. 22-1960 12:30 P.M.
 Gary E. Penfound REG. SURVEYOR

Bernard Konowal to Salvatore & Helen Cipolla

BH

02-02-005