
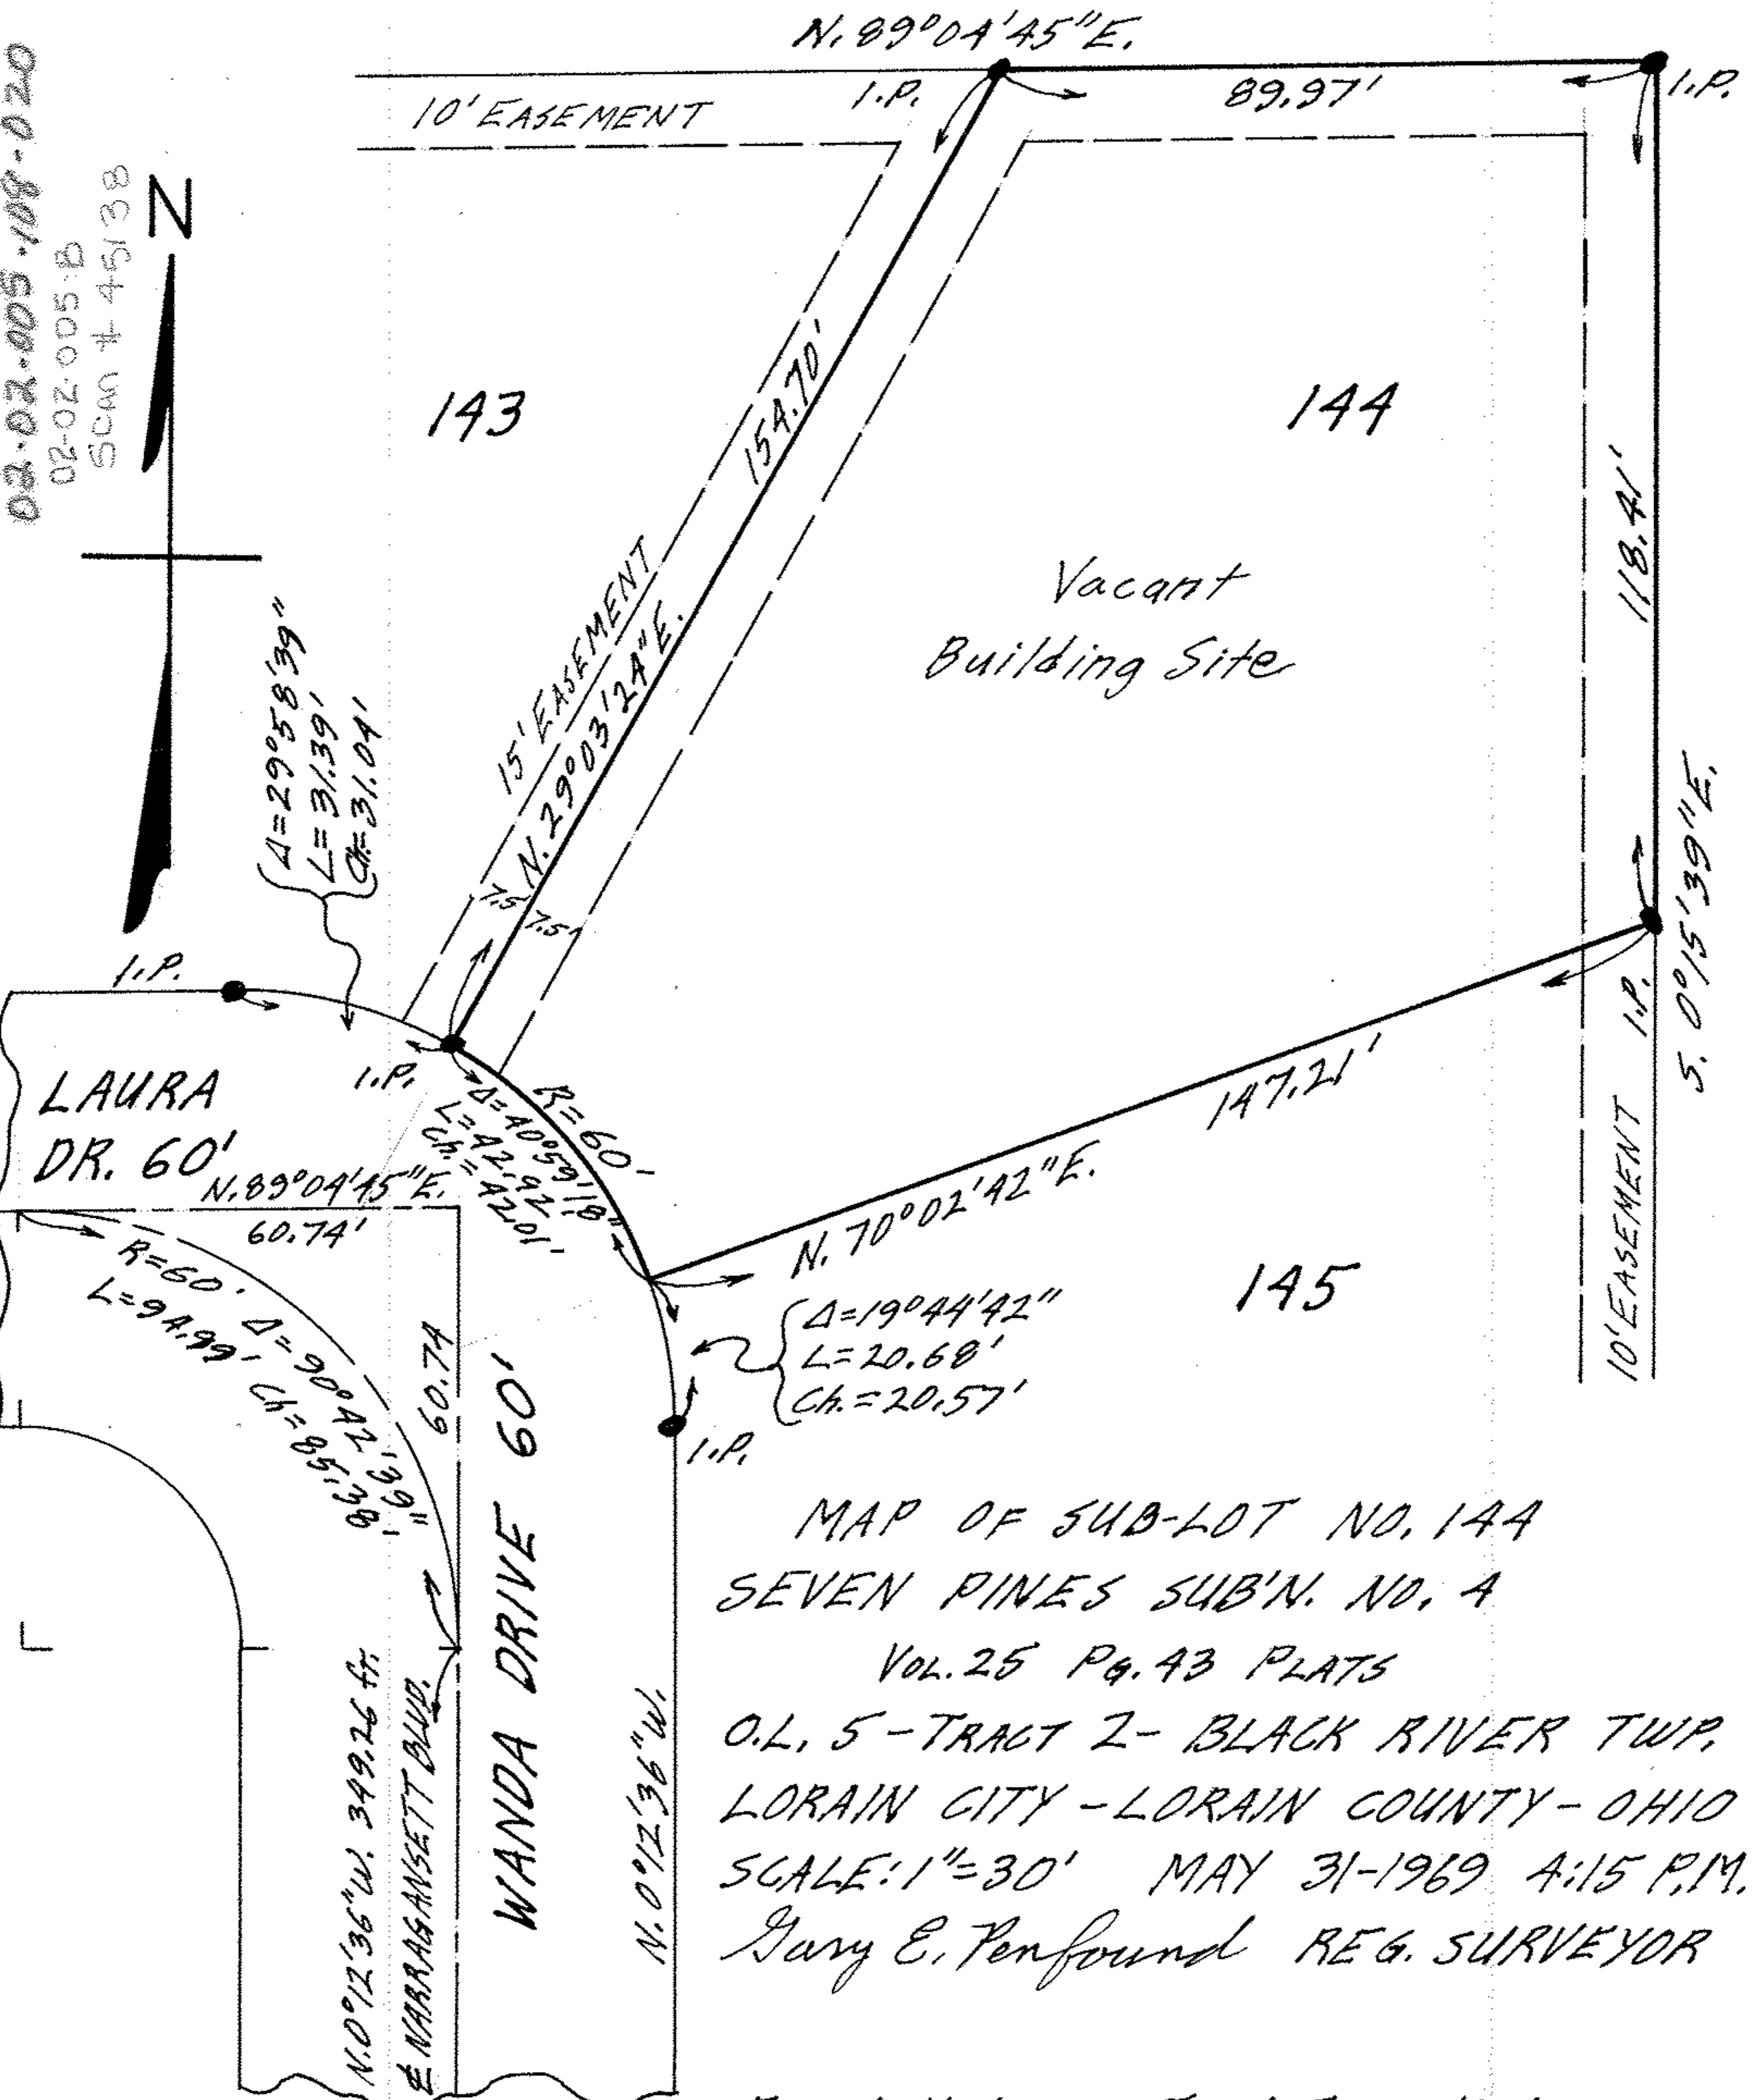


02-02-005-108-020
 02-02-005-B
 SCAN # 45138

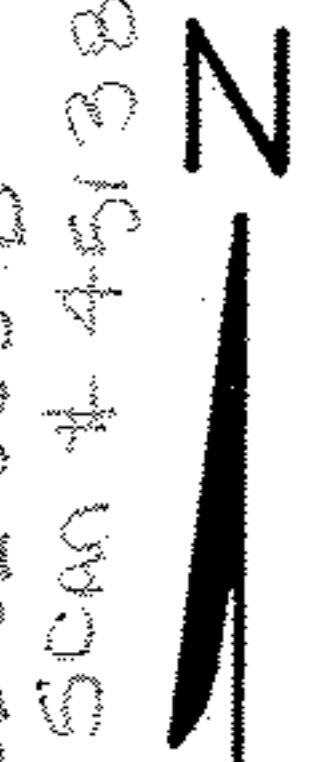

MAP OF SUB-LOT NO. 144
 SEVEN PINES SUB'N. NO. 4
 VOL. 25 PG. 43 PLATS
 O.L. 5-TRACT 2-BLACK RIVER TWP.
 LORAIN CITY-LORAIN COUNTY-OHIO
 SCALE: 1"=30' MAY 31-1969 4:15 P.M.
 Gary E. Penfound REG. SURVEYOR

Frank Kodman, Jr. & Erna Kodman