


02-02-014-11-017
 02-02-014-B
 SC# 46143

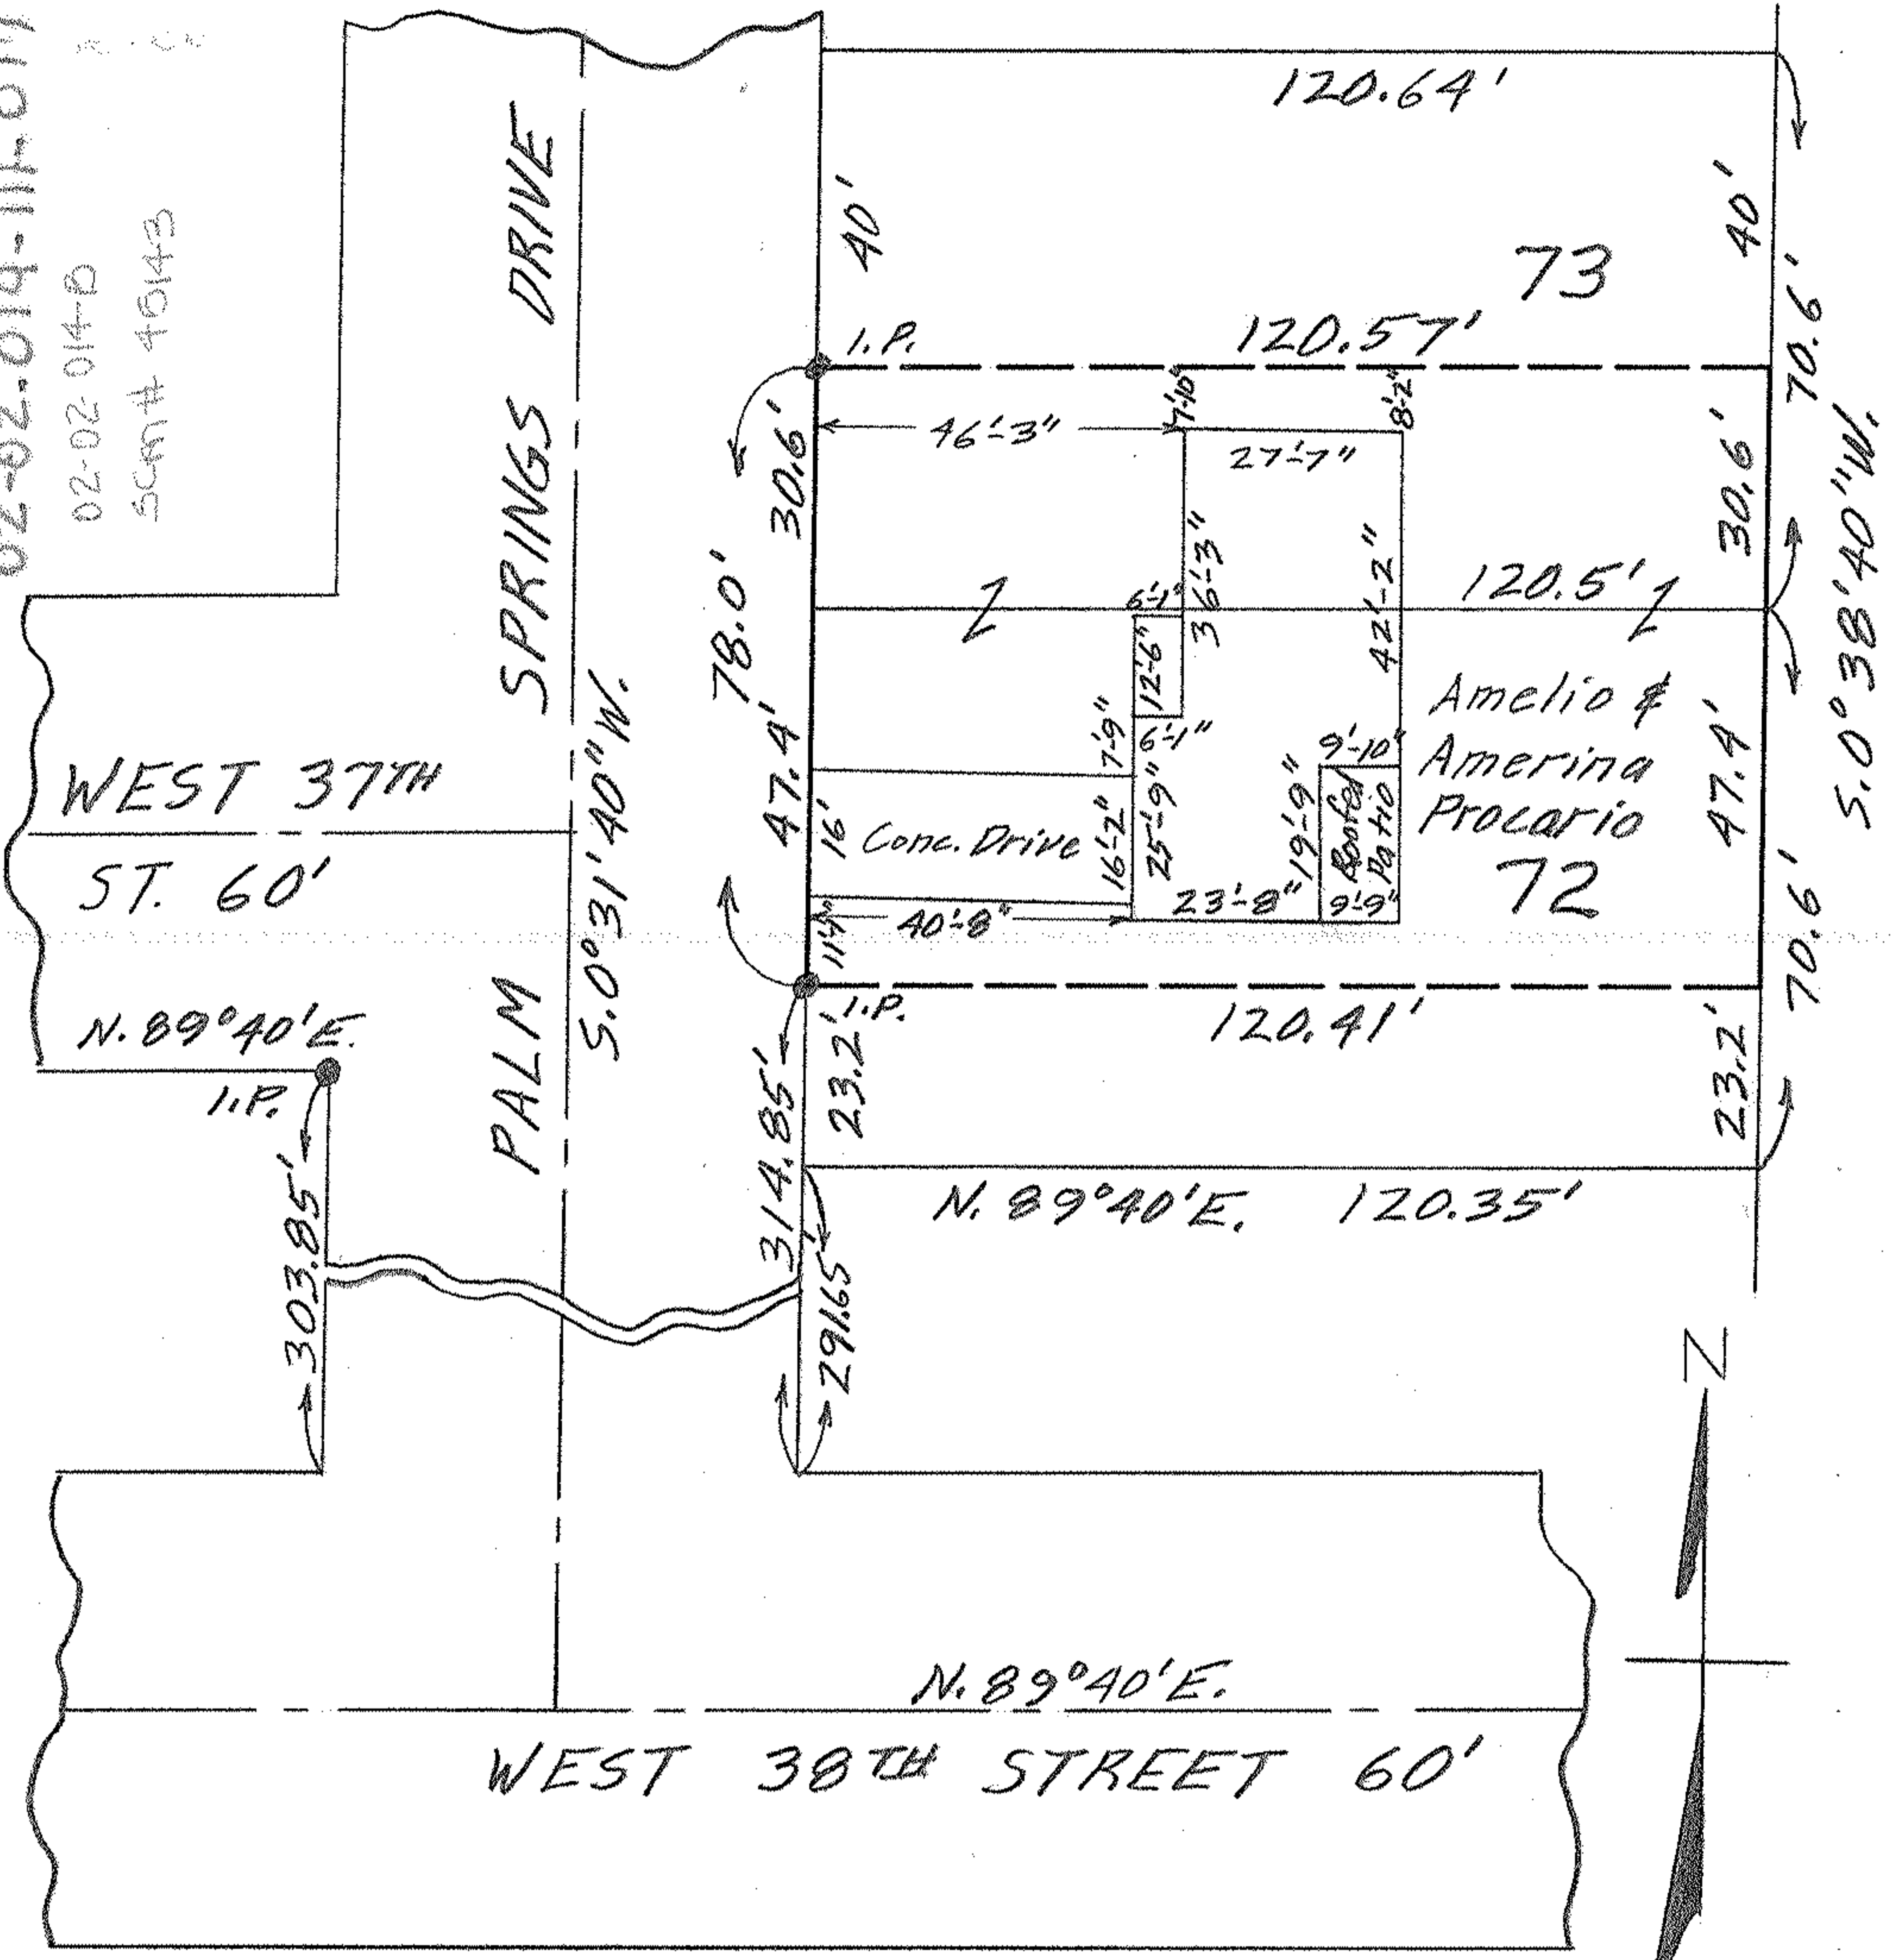

MAP OF NORTHERLY 47.40 FEET OF SUB-LOT NO. 72
 AND SOUTHERLY 30.60 FEET OF SUB-LOT NO. 73 OF
 AMELIA MEADOWS ALL'T. SUB'N. NO. 1 Vol. 22 Pg. 71
 ORIG. LOT 1A - TRACT 2 - BLACK RIVER TWP.
 LORAIN CITY - LORAIN COUNTY - OHIO
 SCALE: 1" = 30' OCT. 13 - 1965 12:30 P.M.
 Gary E. Penfound REG. SURVEYOR