
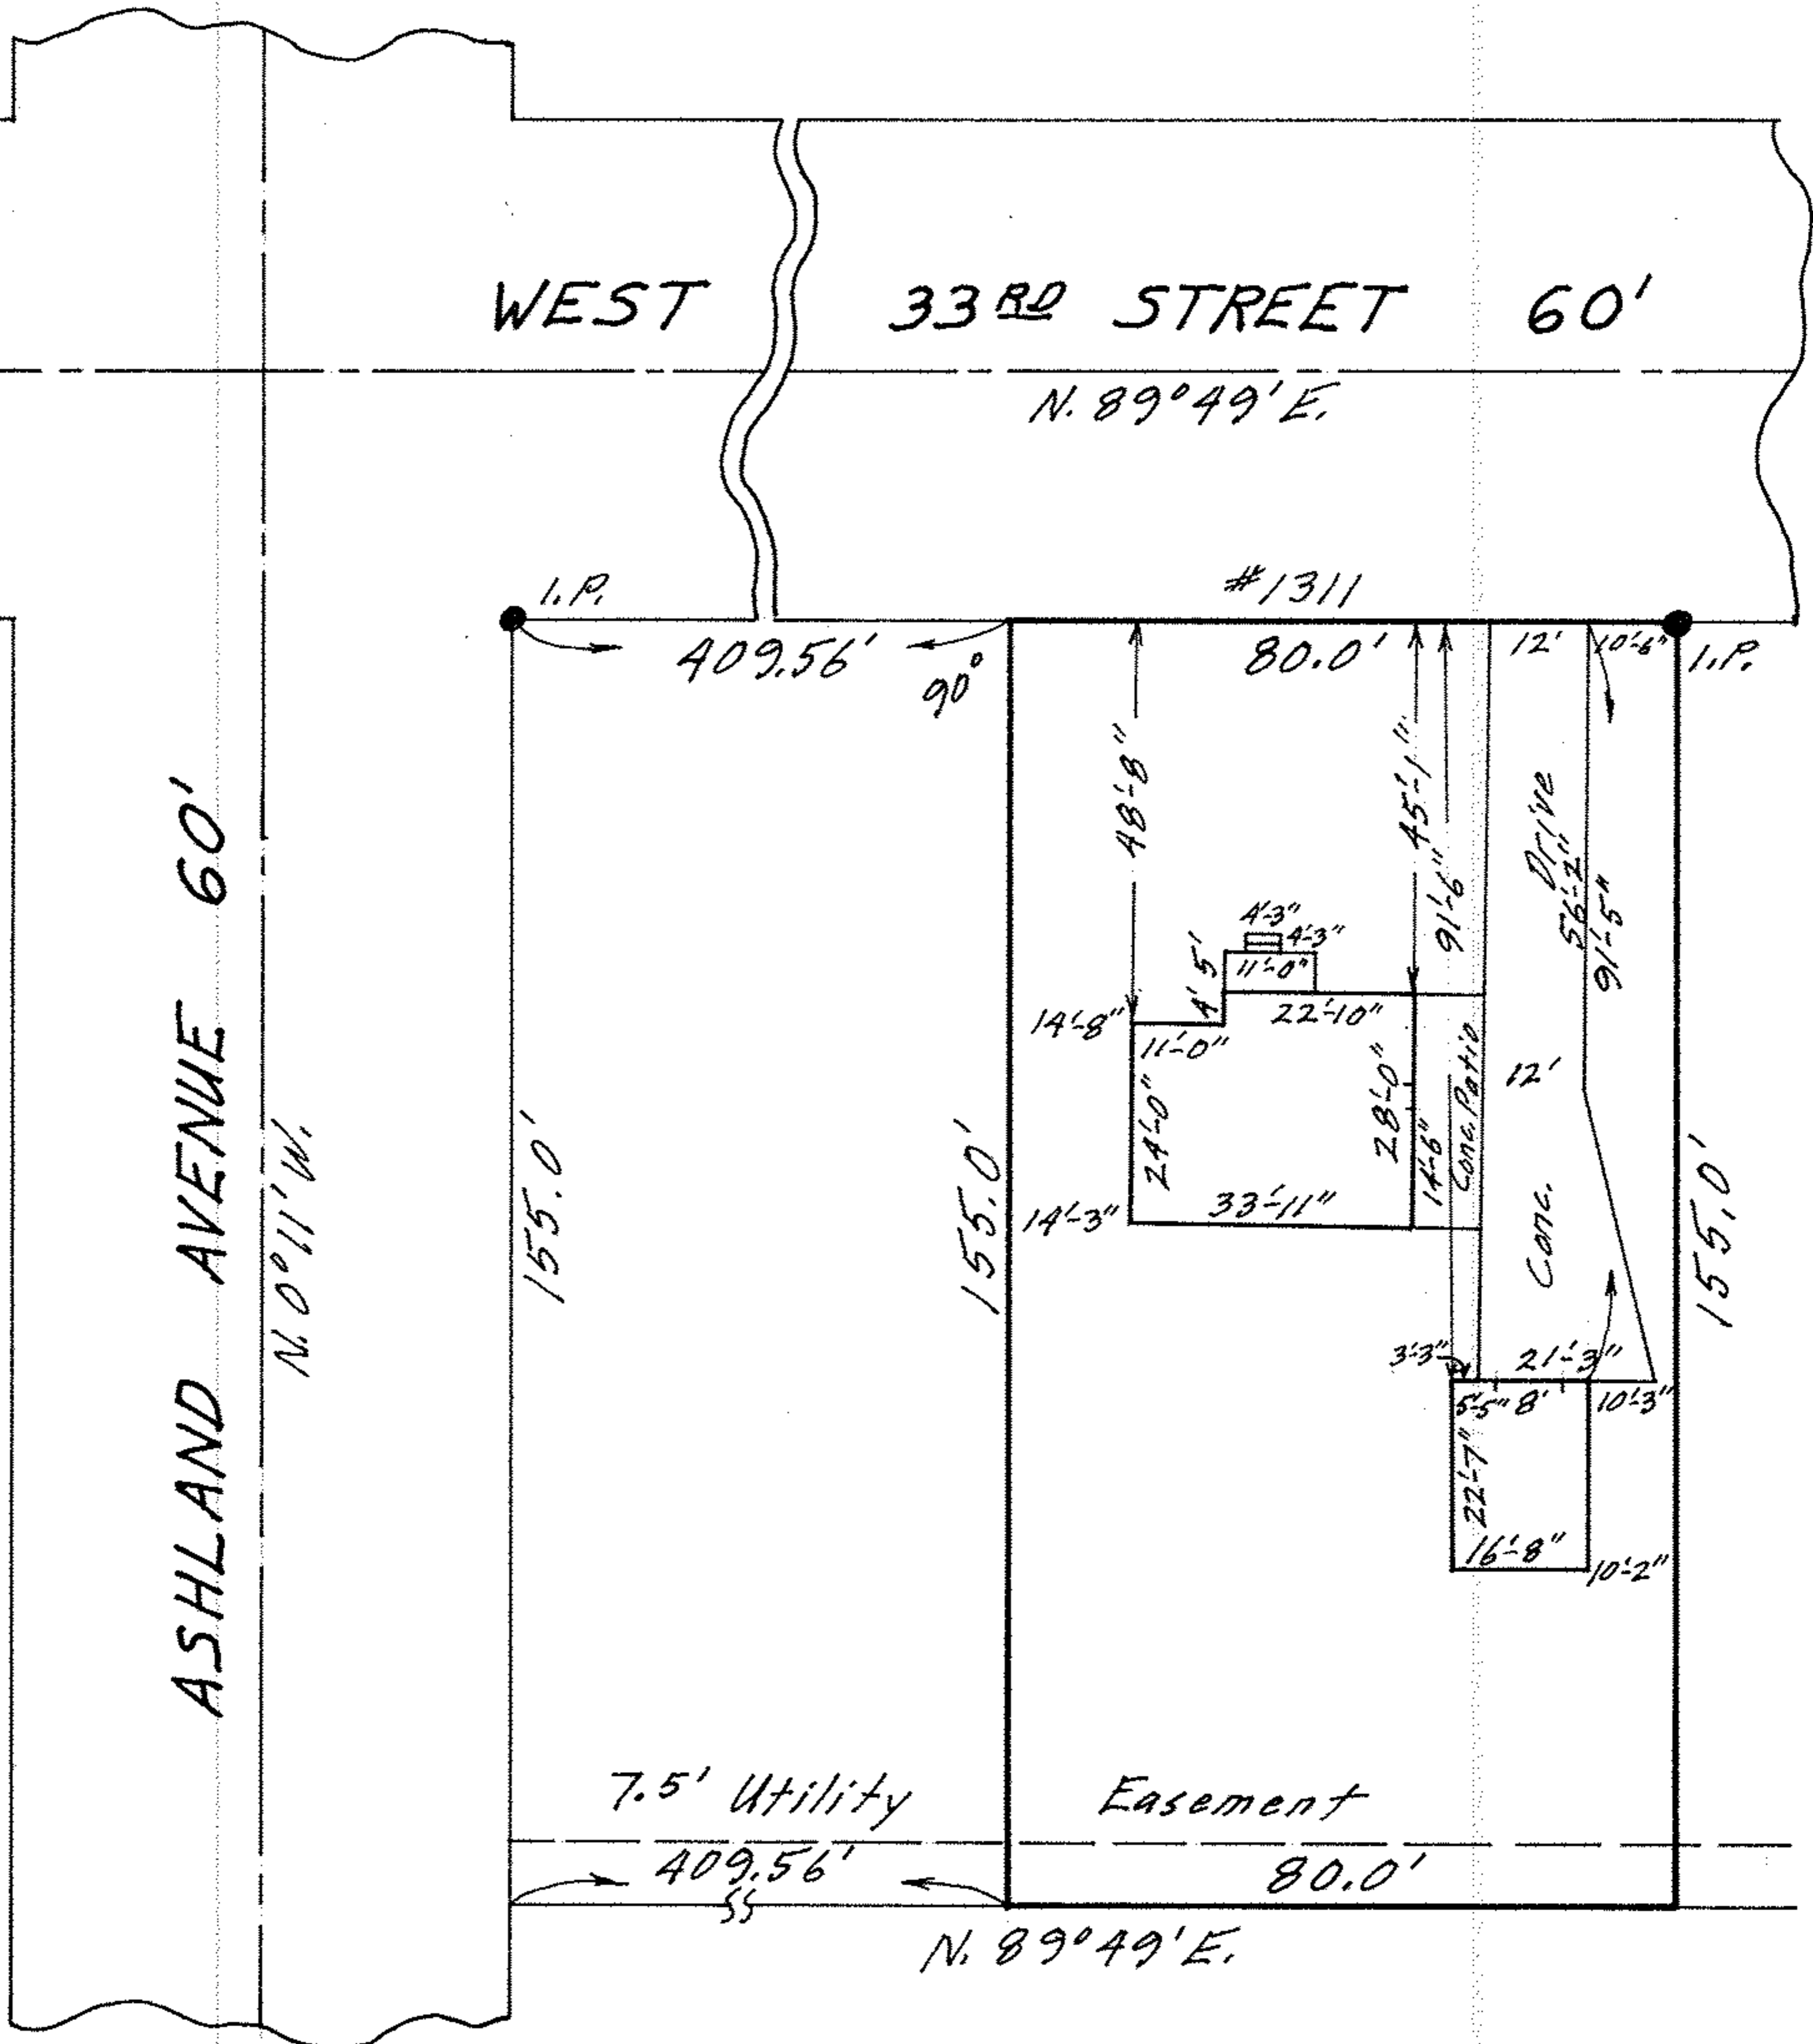


02-02-015-105-0060

02-02-015-B

Scan # 45147

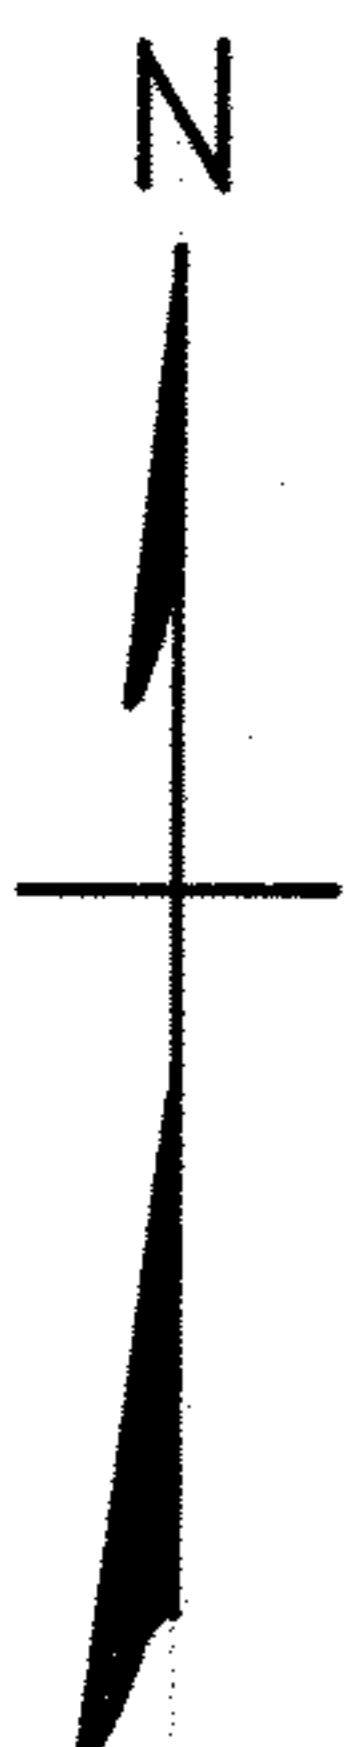

MAP OF SUB-LOT NO. A1
 WILLOW CREEK SUB'N. NO. 1 Vol. 14 Pg. 41
 ORIG. LOT 15 - TRACT 2 - BLACK RIVER TWP.
 LORAIN CITY - LORAIN COUNTY - OHIO
 SCALE: 1" = 30' MAY 28-1966 8:30 P.M.
 Gary E. Penfound REG. SURVEYOR
 Clarence R. & Ethel Cullen