


07-02-015-122-004  
 02-02-015-A SCANT 45149

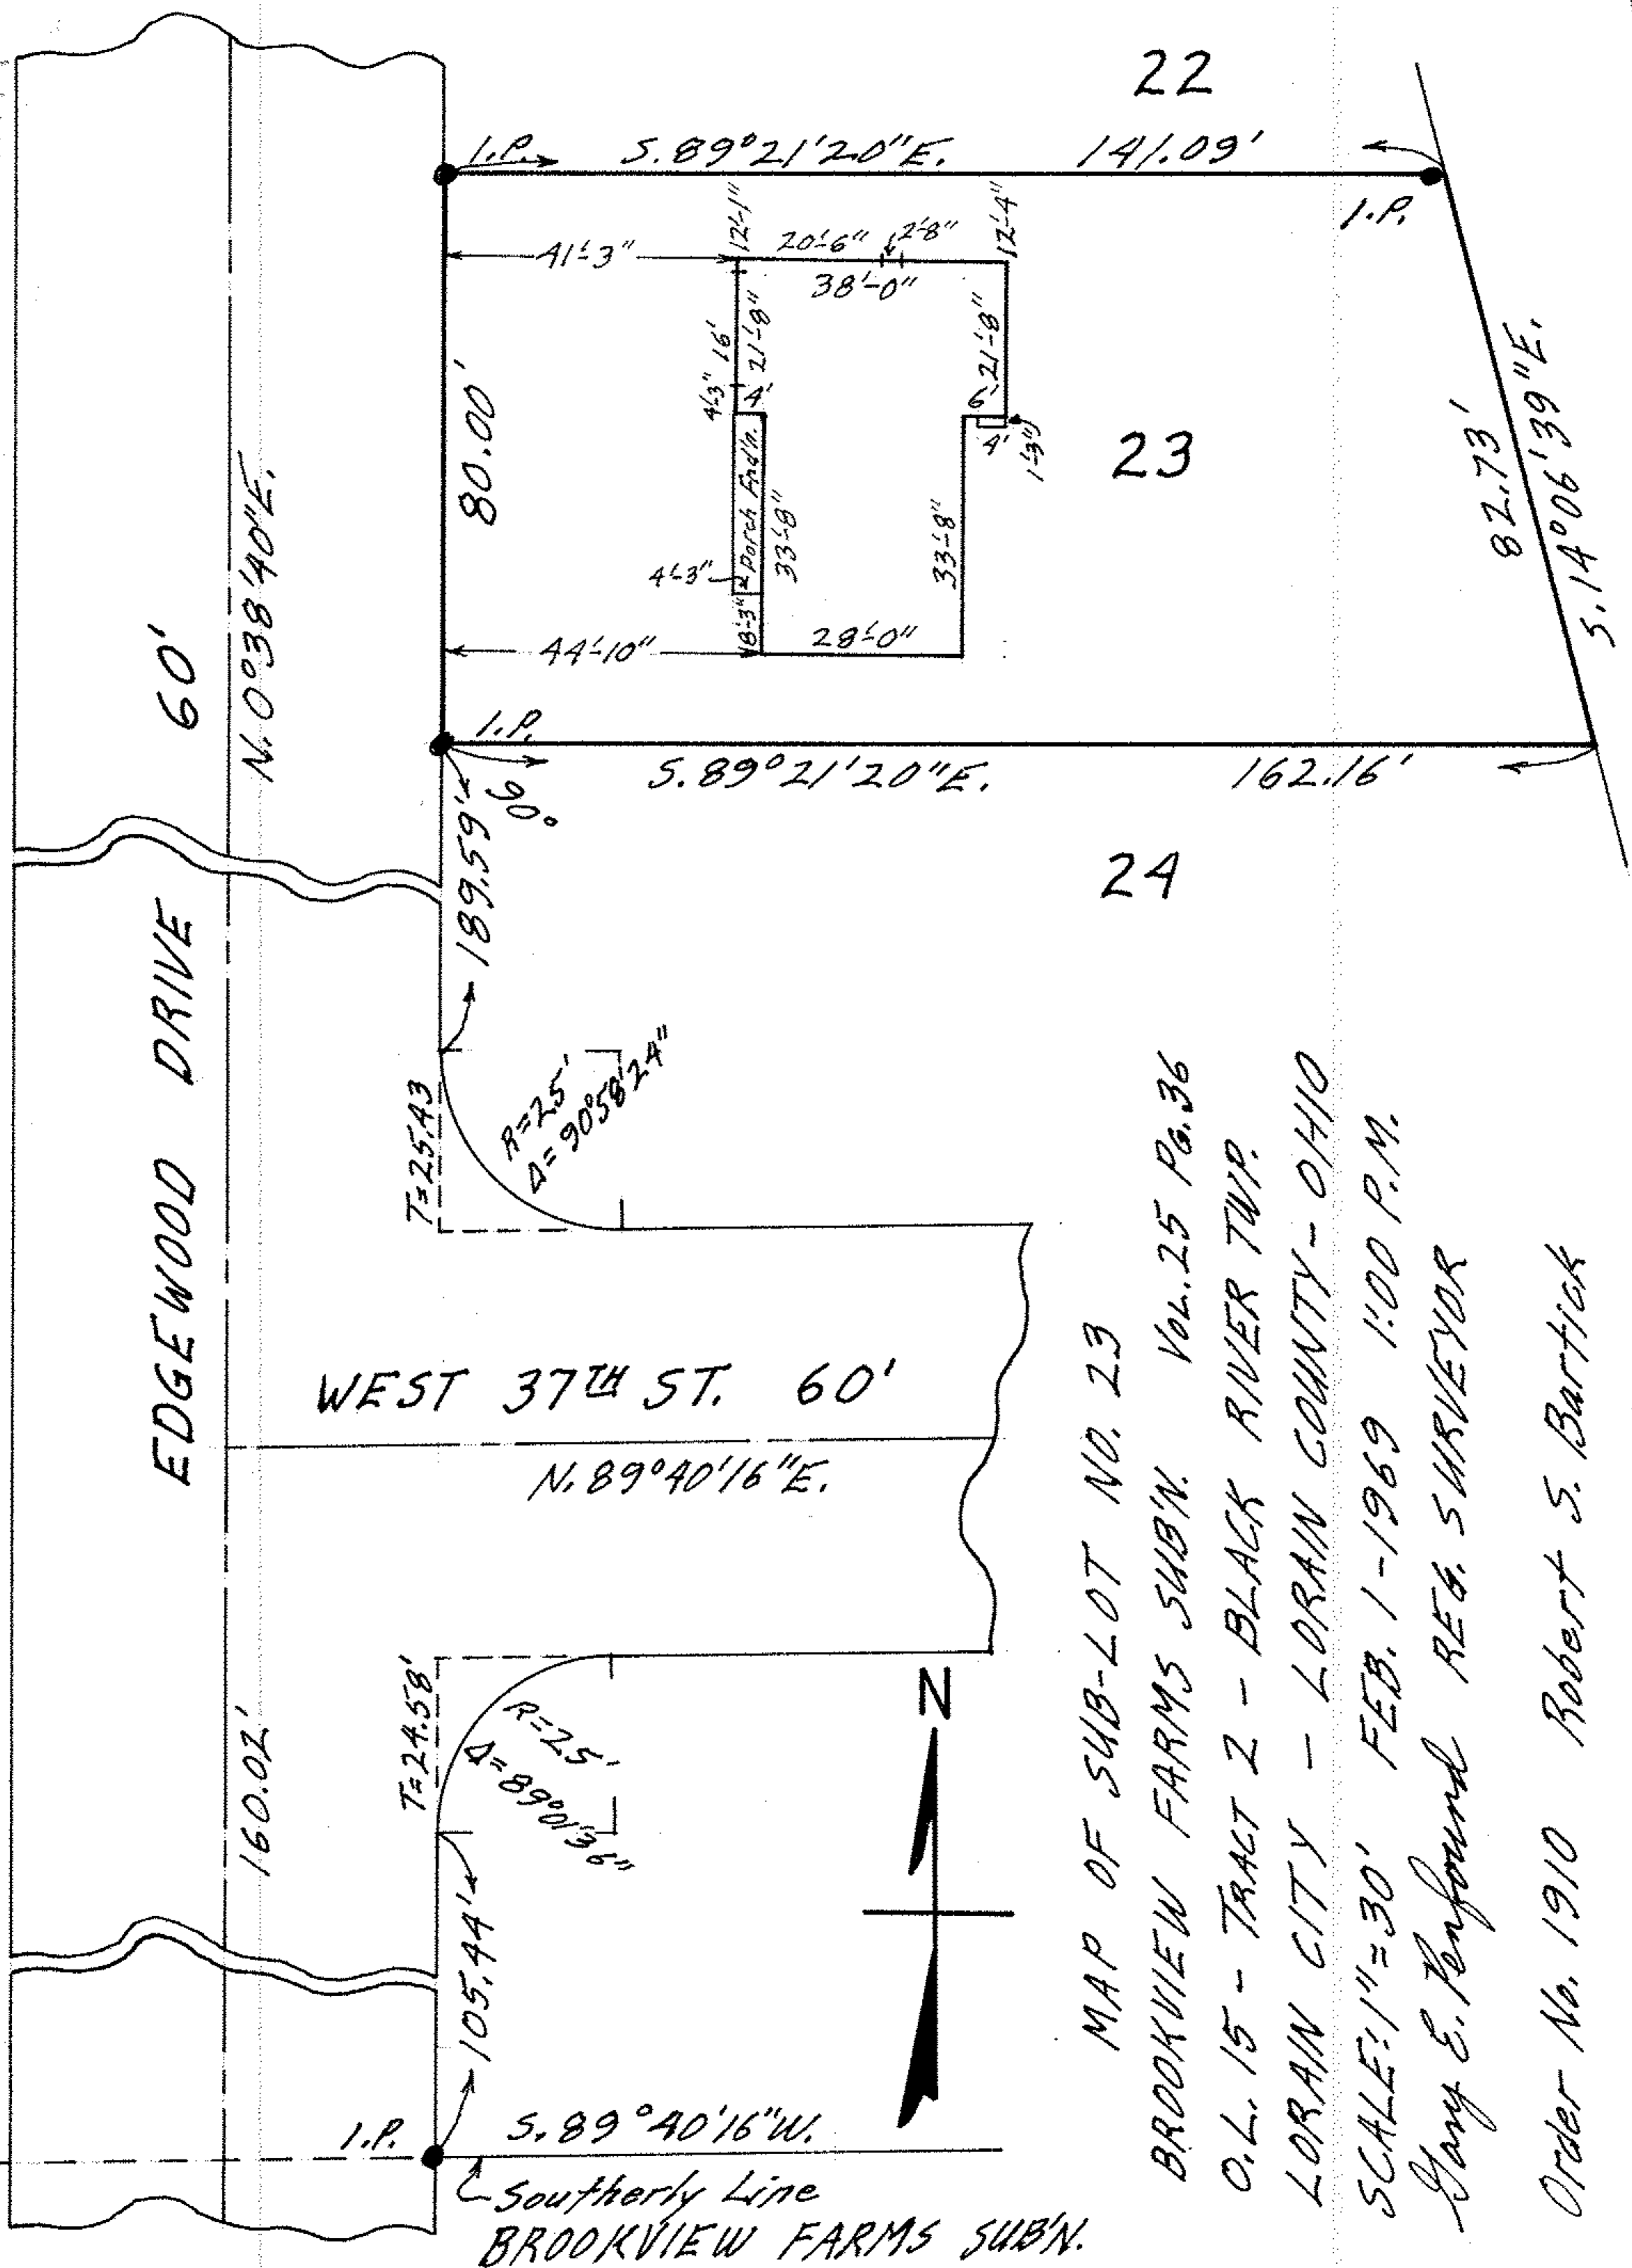

MAP OF SUB-LOT NO. 23  
 BROOKVIEW FARMS SUB'N. VOL. 25 PG. 36  
 O.L. 15 - TRACT 2 - BLACK RIVER TWP.  
 LORAIN CITY - LORAIN COUNTY - OHIO  
 SCALE: 1"=30' FEB. 1-1969 1:00 P.M.  
 Gary E. Penfound REG. SURVEYOR  
 Order No. 1910 Robert S. Bartick

510-20-20