

02-02-016-B

02-02-016-B
SCAN # 45155


WEST 29TH ST. 60'

N. 89°47'30"E.

AVENUE

OBERLIN

N. 0°41'E.

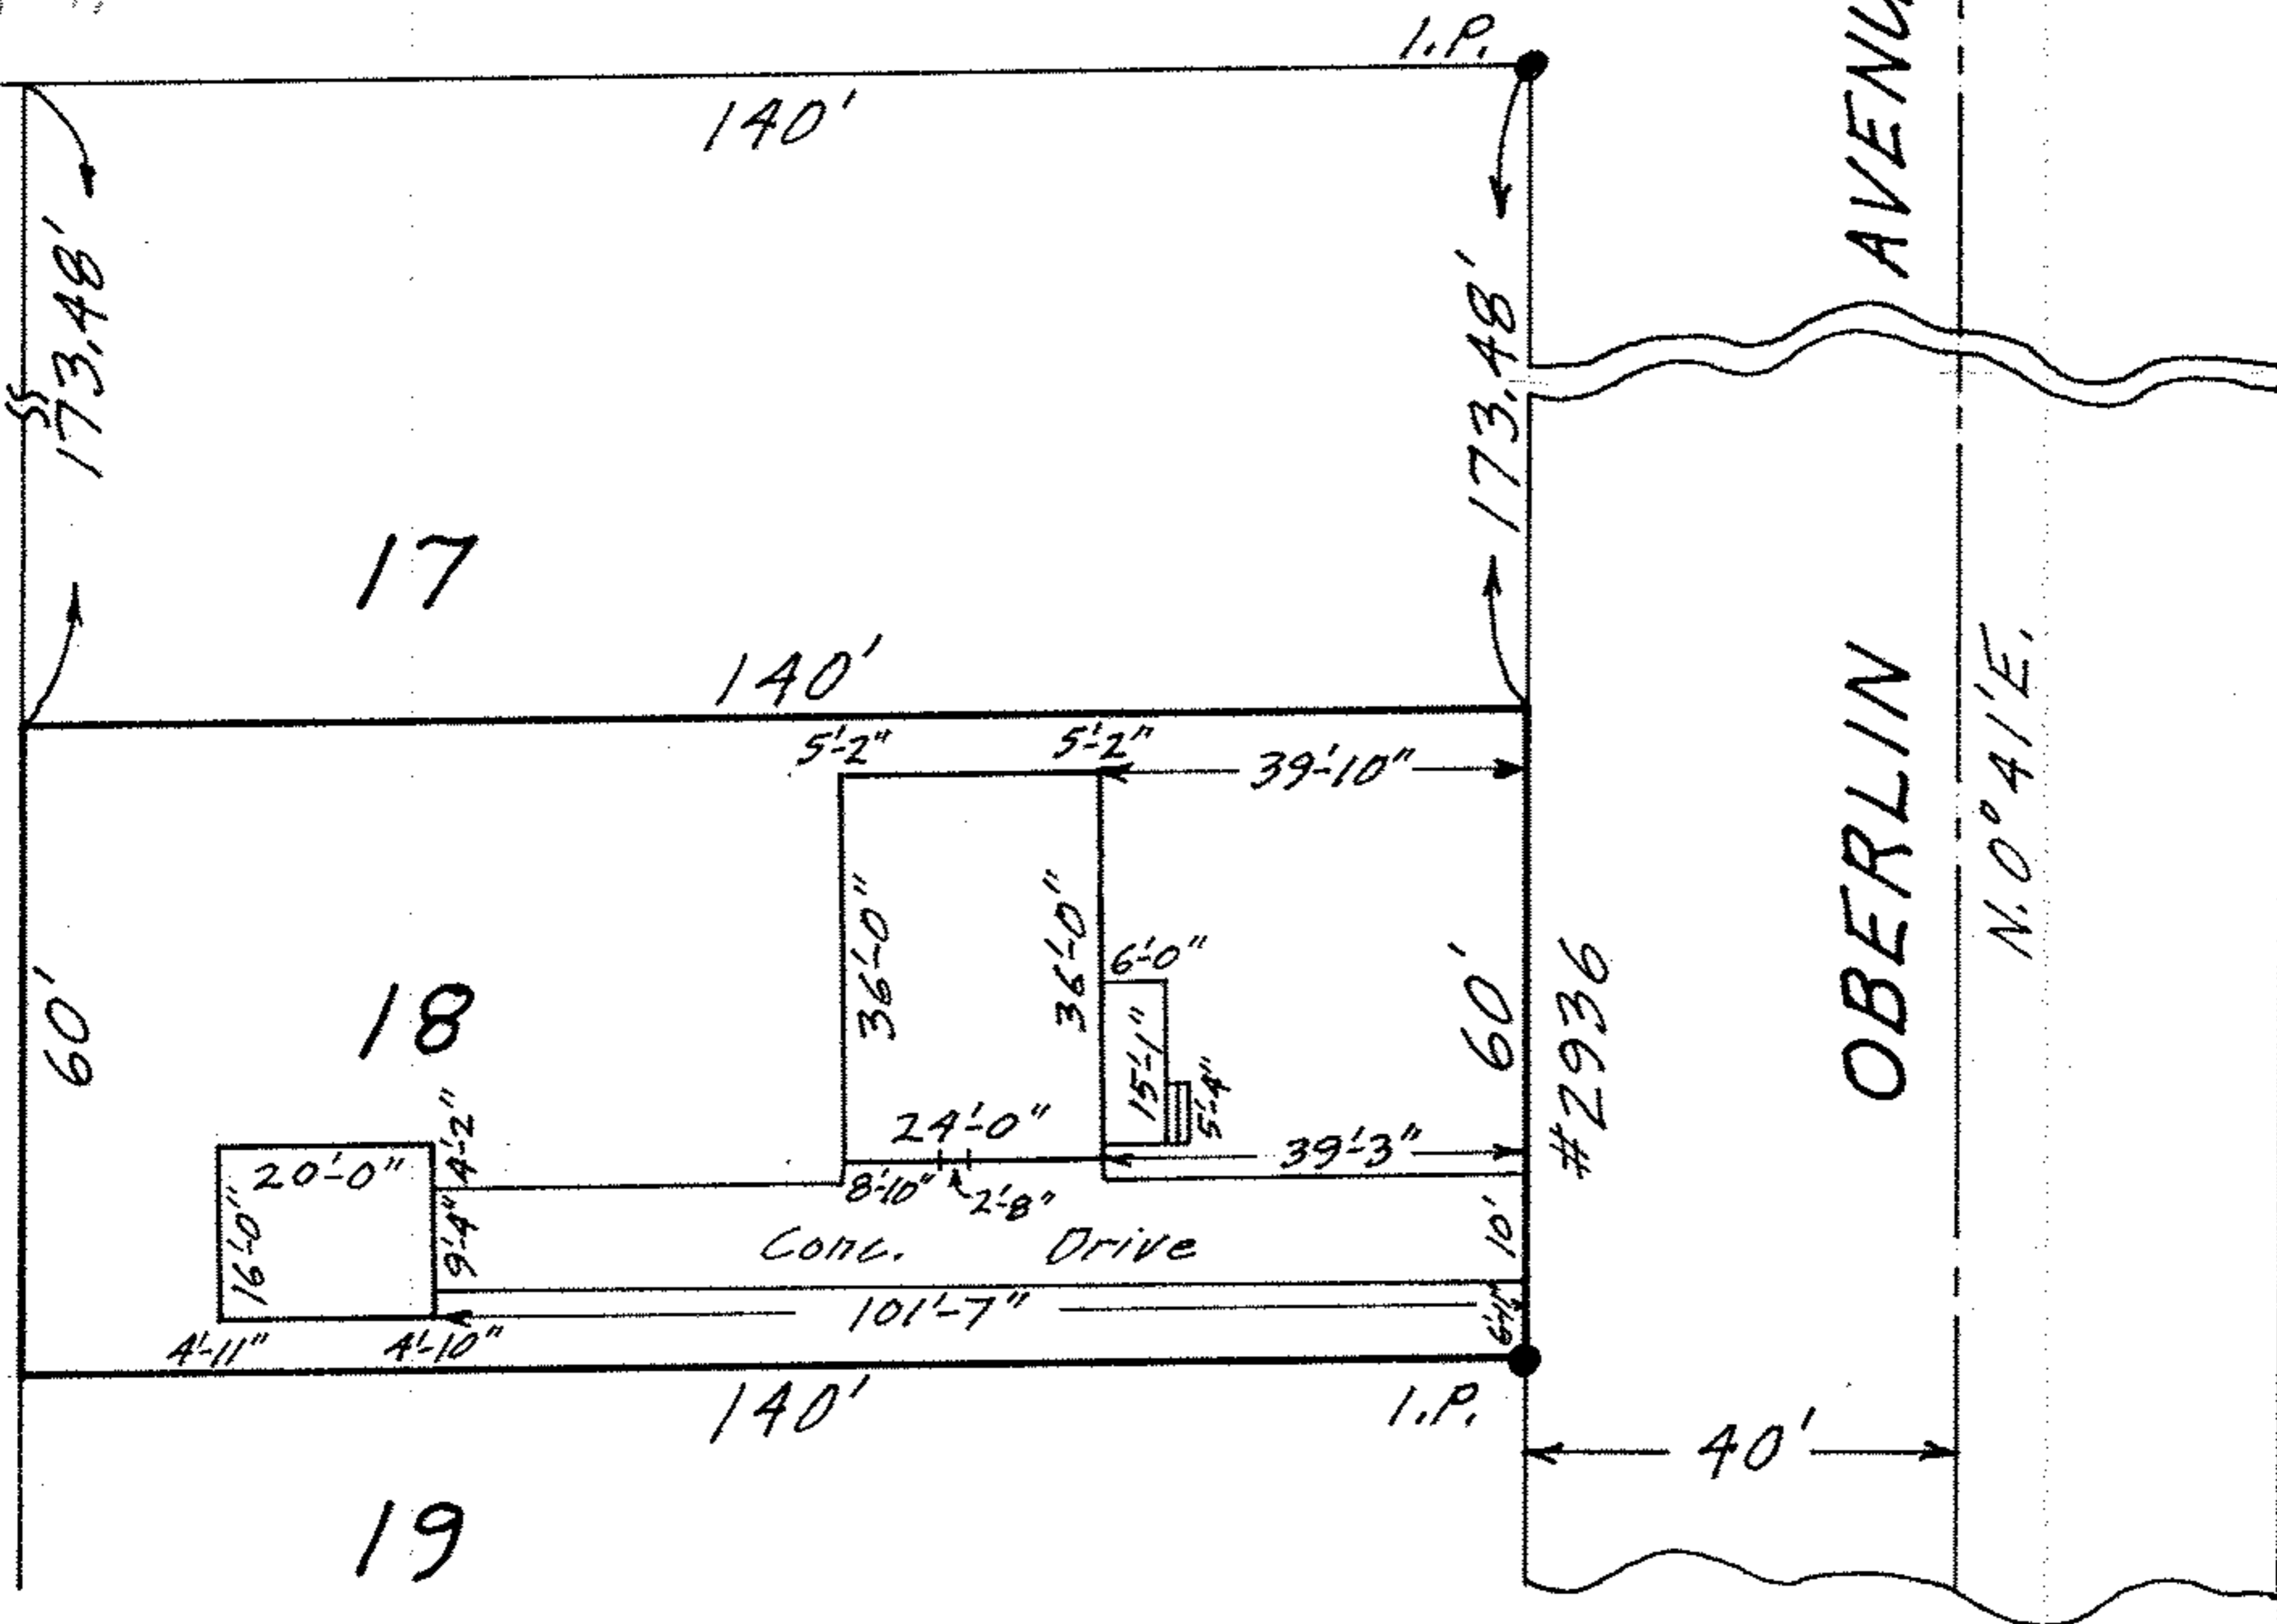

MAP OF SUB-LOT NO. 18

JO-AL-MAR HAVEN SUB'N. NO. 1 Vol. 15 Pg. 23

ORIG. LOT 16 - TRACT 2 - BLACK RIVER TWP.

LORAIN CITY - LORAIN COUNTY - OHIO

SCALE: 1" = 30' APRIL 13-1966 6:00 P.M.

Gary E. Penfound REG. SURVEYOR

John J. Akosi, Jr. & Anna Akosi

Parcel No. 1