
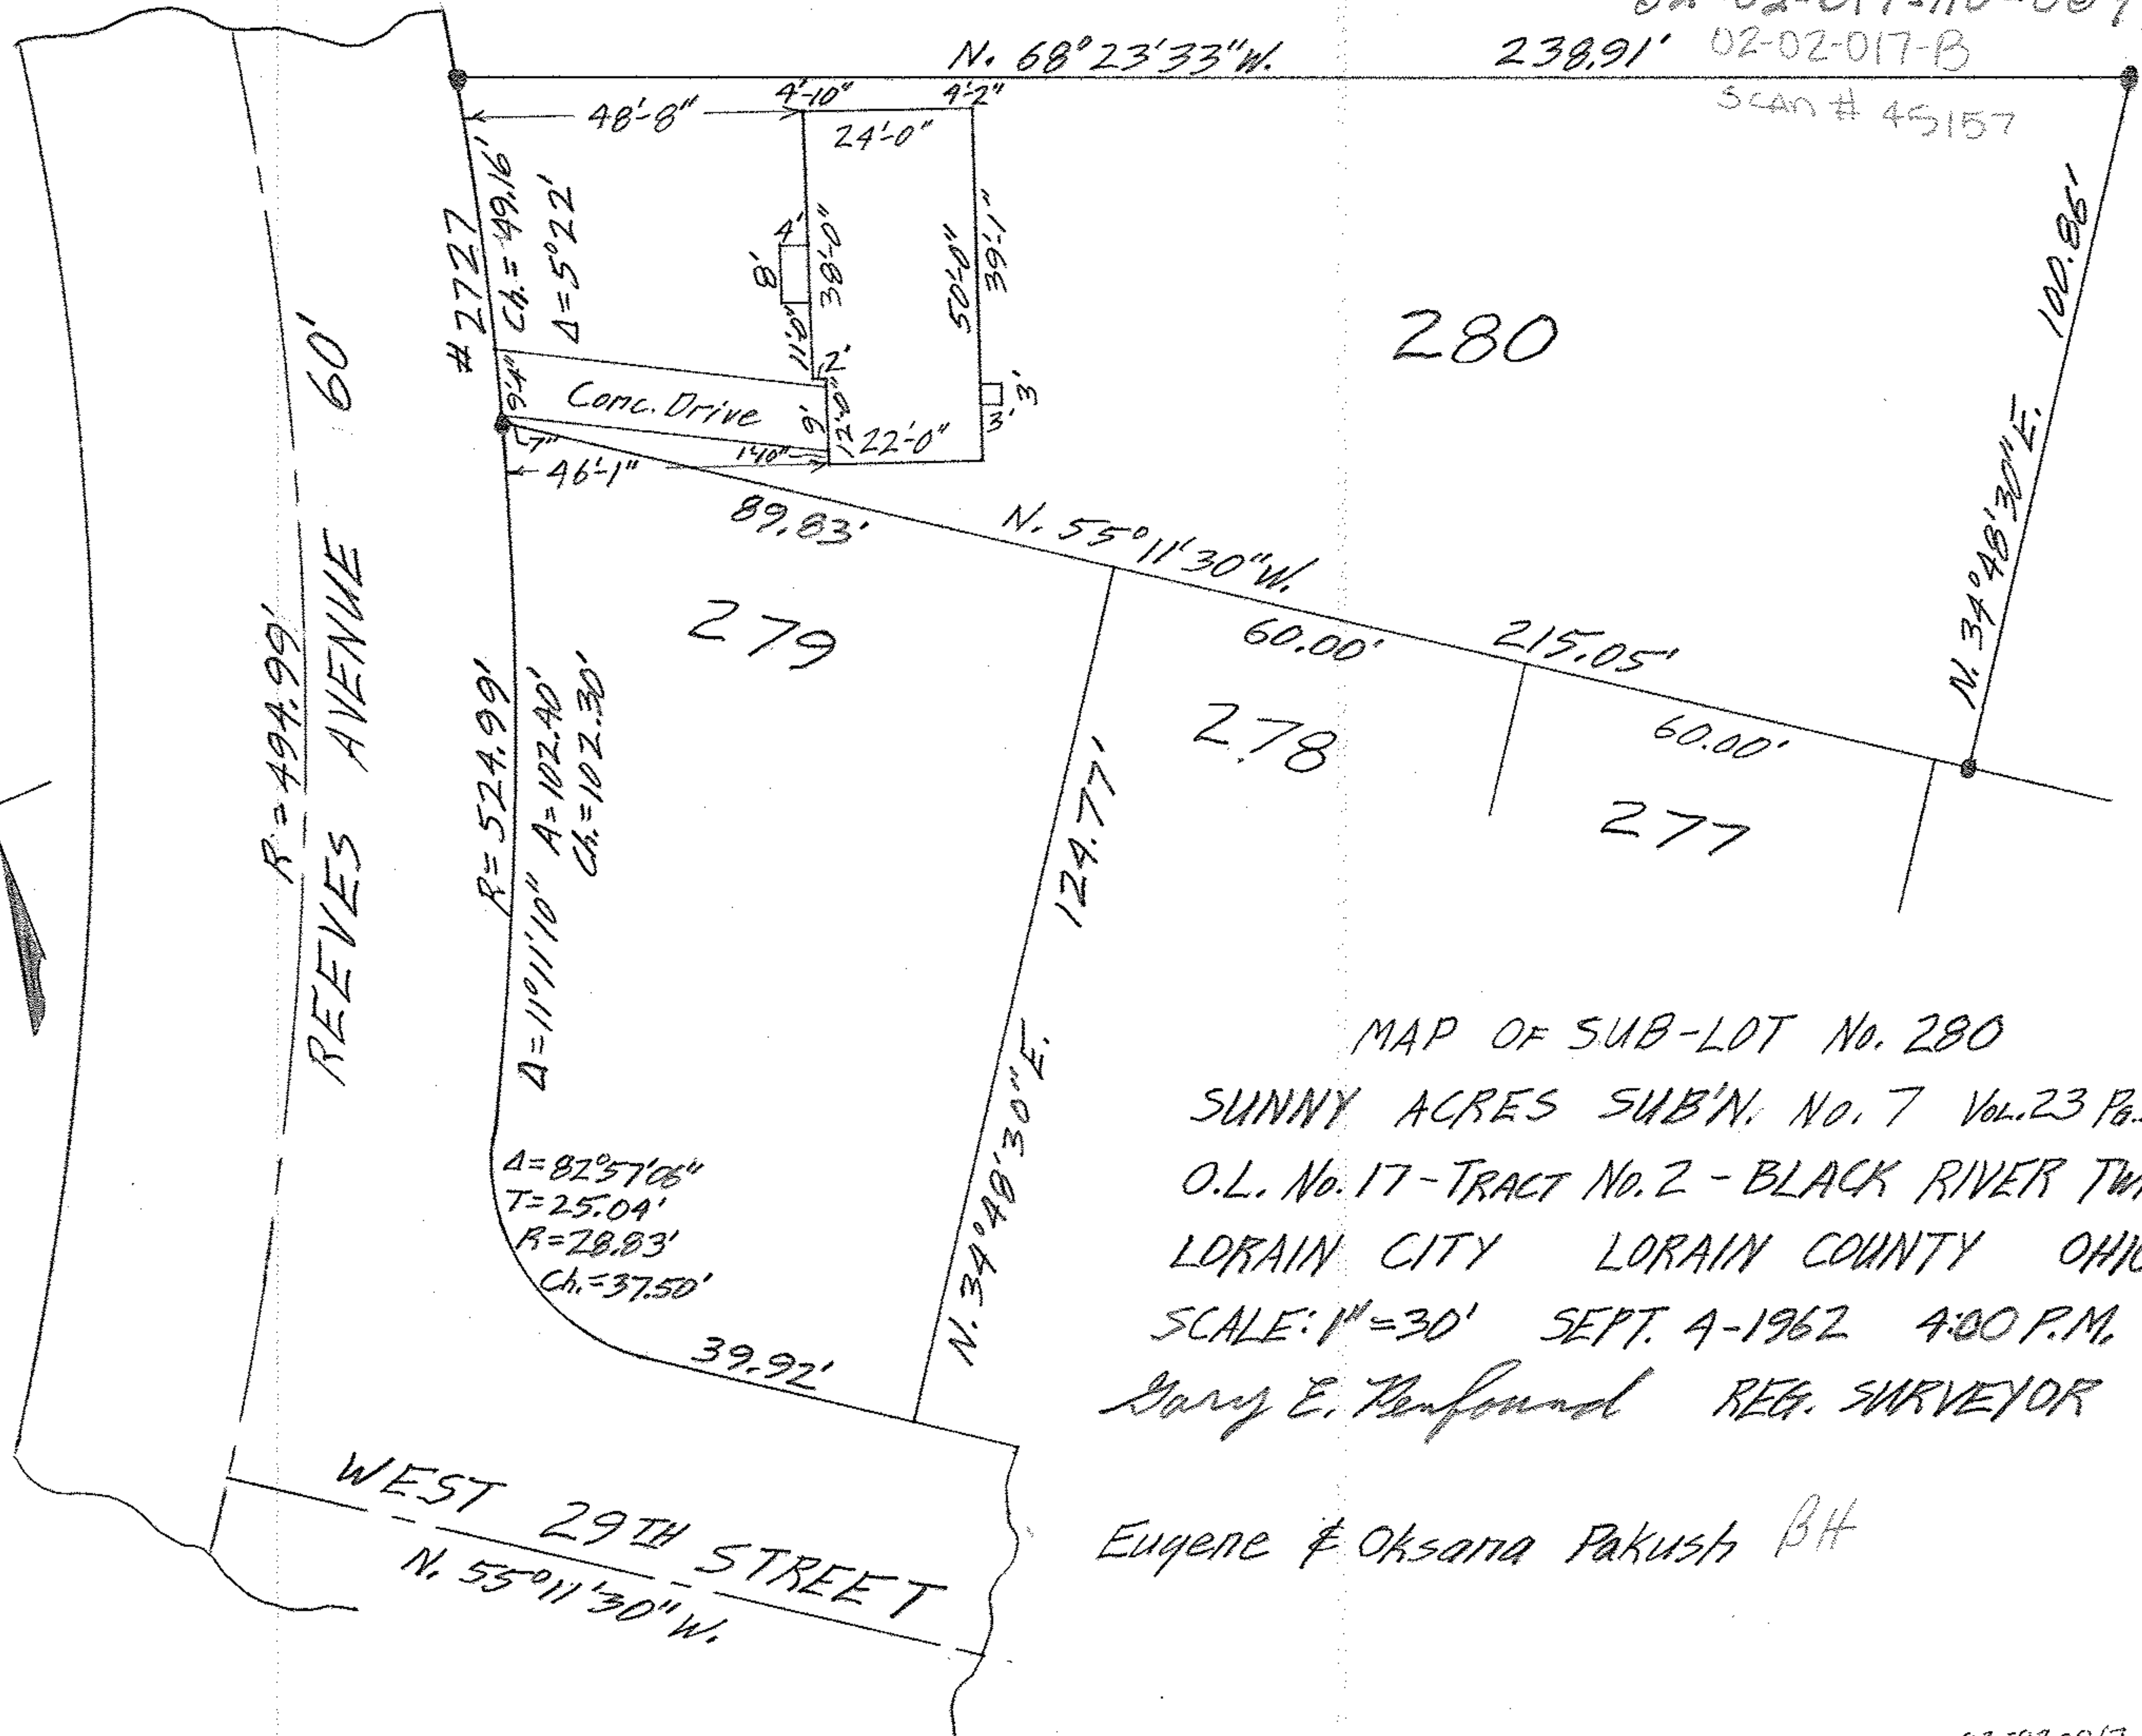


02-02-017-110-009

238.91' 02-02-017-B

Scan # 45157

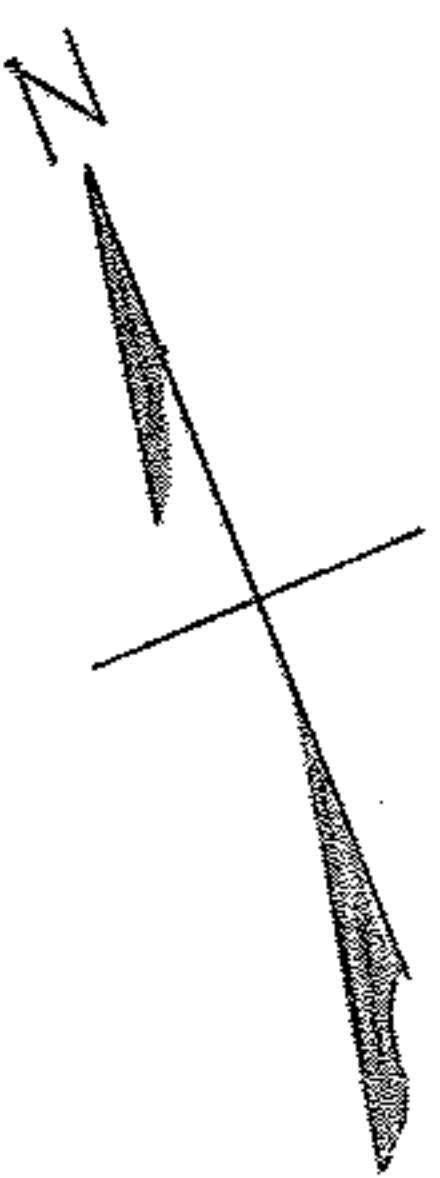

MAP OF SUB-LOT No. 280  
 SUNNY ACRES SUB'N. No. 7 Vol. 23 Pg. 23  
 O.L. No. 17 - TRACT No. 2 - BLACK RIVER TWP.  
 LORAIN CITY LORAIN COUNTY OHIO  
 SCALE: 1" = 30' SEPT. 9-1962 4:00 P.M.  
 Gary E. Penfound REG. SURVEYOR

Eugene & Oksana Pakush BH