

02-02-017-11-003,004  
 02-02-017-A  
 SCAN # 45150

C = 278.06  
 A = 201.93  
 R = 194.99  
 Δ = 32°27'30"

REEVES AVE. 60'  
 N-34°48'30"E. 170.50'

Δ = 1°06' C = 9.50

Δ = 90°  
 R = 25'  
 A = 39.27  
 C = 35.36

WEST 29<sup>th</sup> ST. 60'

N-55°11'30"W.


N-34°48'30"E. 125.00'

177.34'

66.17'

40'-1"

4'-3"

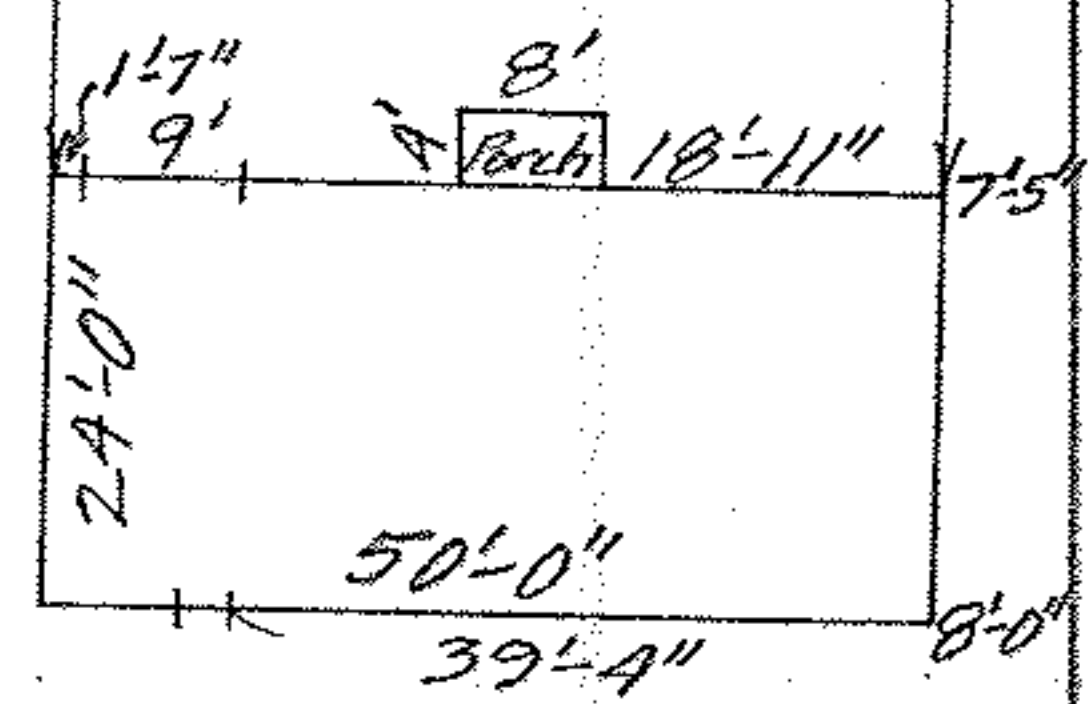

N. 34°48'30"E. 150.00'

270


271

272

202.34'

66.17'

N-55°11'30"W.

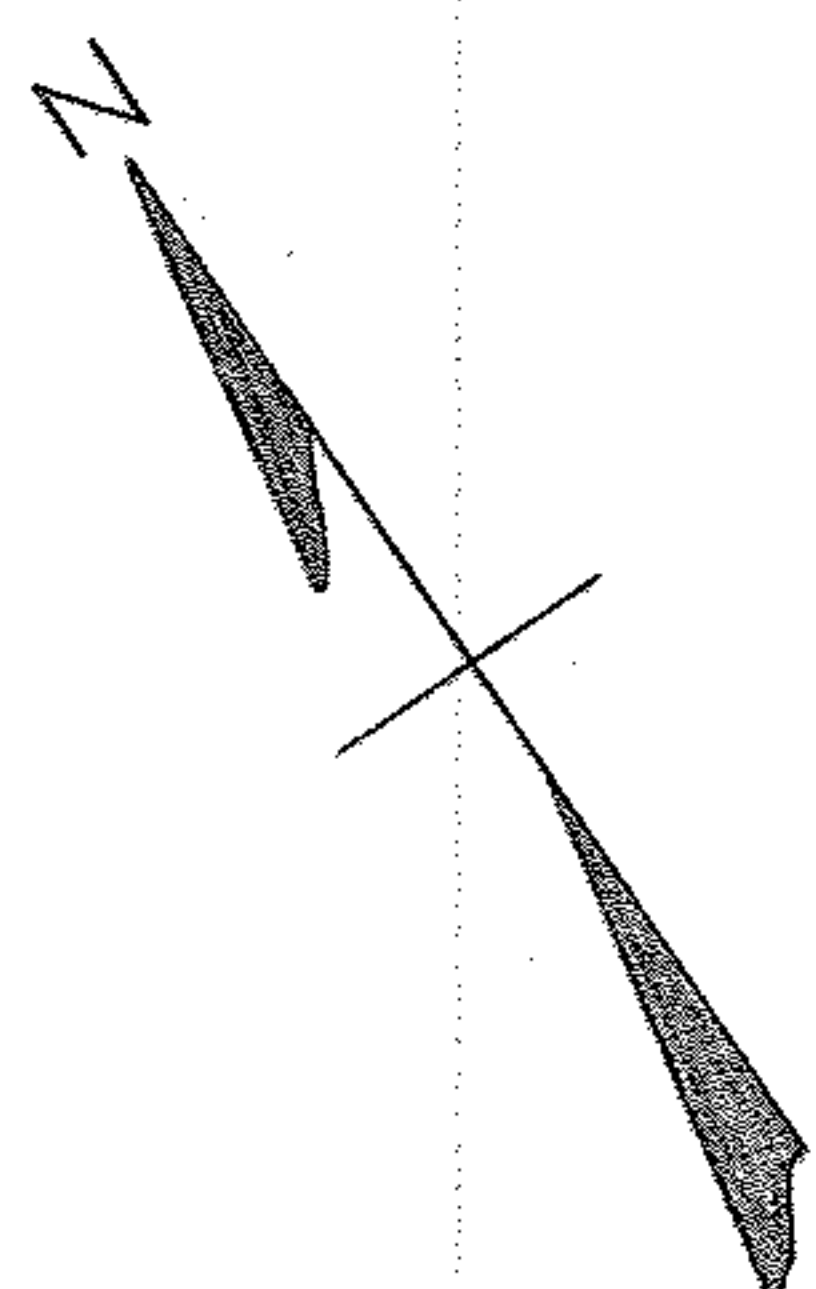

MAP of SUB-LOT 271  
 SUNNY ACRES SUBD'N, N<sup>o</sup> 7 Vol. 23 Pg. 23  
 ORIG. LOT 17-TRACT 2-BLACK RIVER TWP.  
 LORAIN CITY LORAIN COUNTY-OHIO  
 Scale: 1" = 30' APRIL 25-1962 3:15 P.M.

Mary E. Perfound Registered Surveyor

John L. & Kathleen McCoy BH