


02-02-017-115-001, 012, 002
 02-02-017-8
 SCAN# 45159

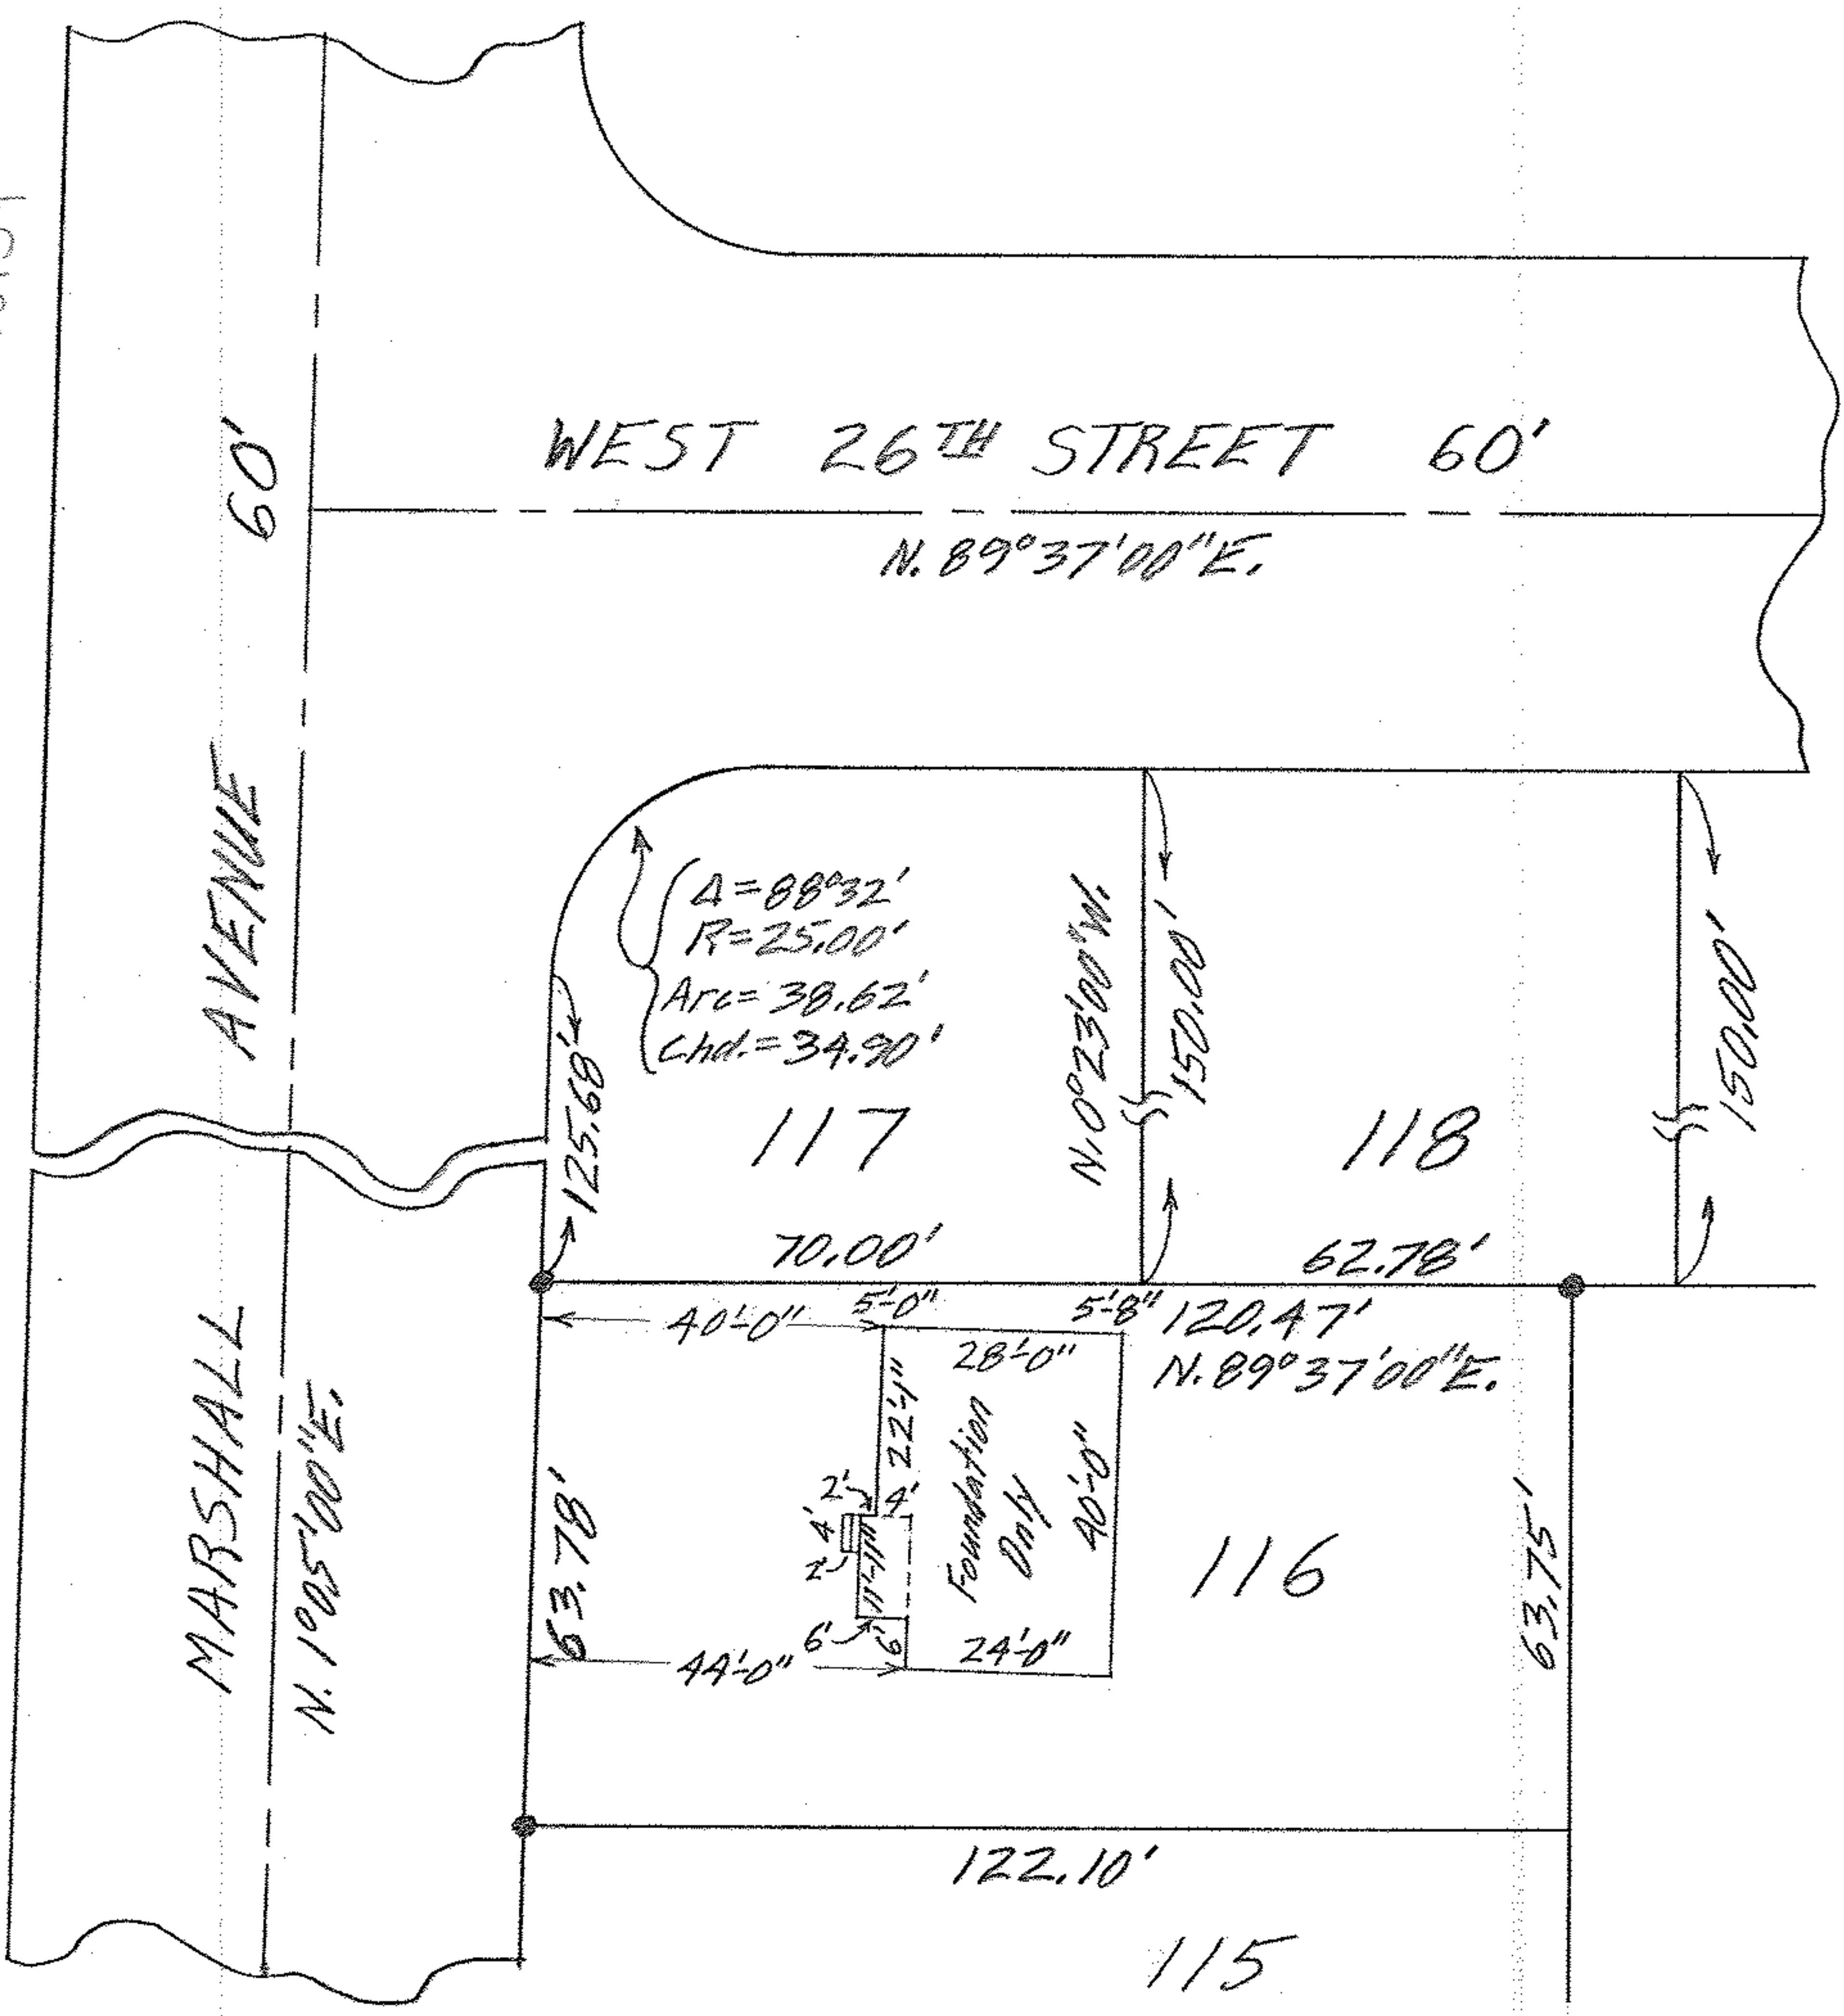

MAP OF SUB-LOT NO. 116
 SUNNY ACRES SUB'N. NO. 3 VOL. 22 Pg. 44
 O.L. 17-TRACT 2-BLACK RIVER TWP.
 LORAIN CITY LORAIN COUNTY OHIO
 SCALE: 1"=30' NOV. 9 -1962 1:15 P.M.
 Gary E. Penfound REG. SURVEYOR

Louis J. Pogorelec, Jr. & Nancy J. Pogorelec BH