

0702-020-103 003

02-02-020-B
SCAN# 45160

W. 21ST ST. EXTENSION - S.R. 611
N-69°58'E.

10' Restricted Area to Access on 611

N-20°02'W 135.00'


42

43

44

45

E.L. Roschall
CH. 5972

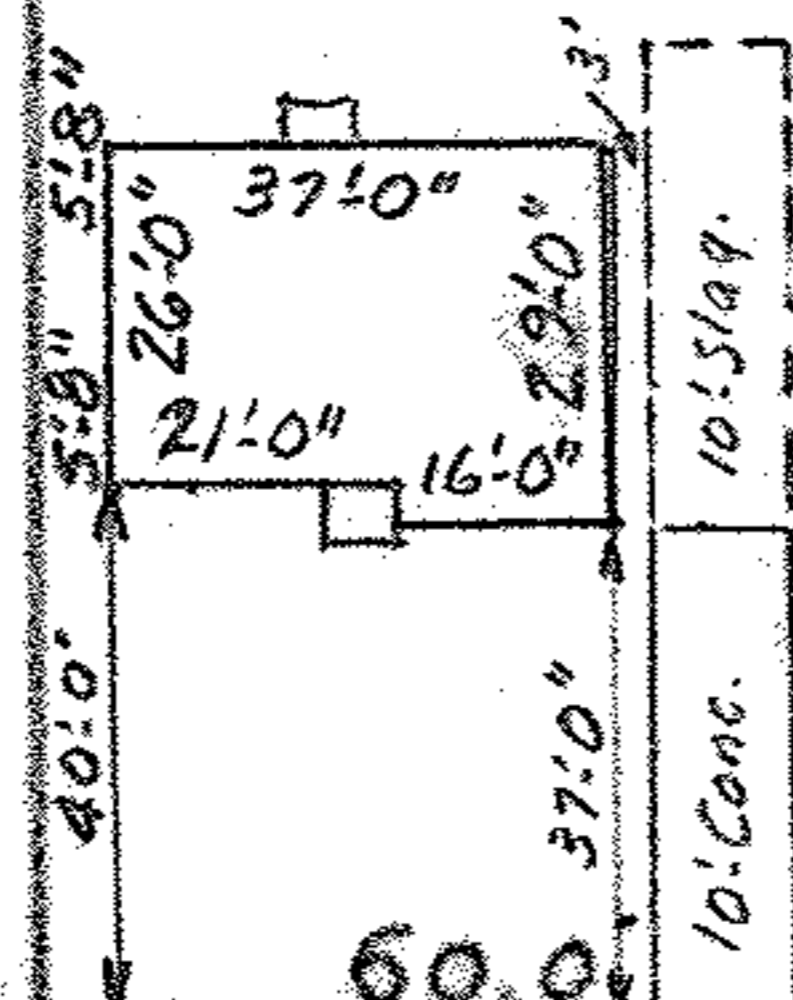

S-20°02'E 135.00'

135.00'

DIDRICKSON DRIVE 60'
S-20°02'E.

60.0'

60.0'

#3808

130.00'

NORTH HOGAN DR. 60'
N-69°58'E.

MAD OF SUB-LOT NO. 43
 COUNTRY CLUB HOMESITES
 PLAT VOL. 21 PG. 19 OL 20 TRACT 2
 BLACK RIVER TWP LORAIN CITY
 LORAIN COUNTY OHIO
 SCALE 1"=40' JULY 31-1959 5:30 AM.
 C.E. Penfound Reg. Surveyor No. 3200



02-02-020