


07-03-20-104. OH, 010
02-02-020-0
SCAN# 45162

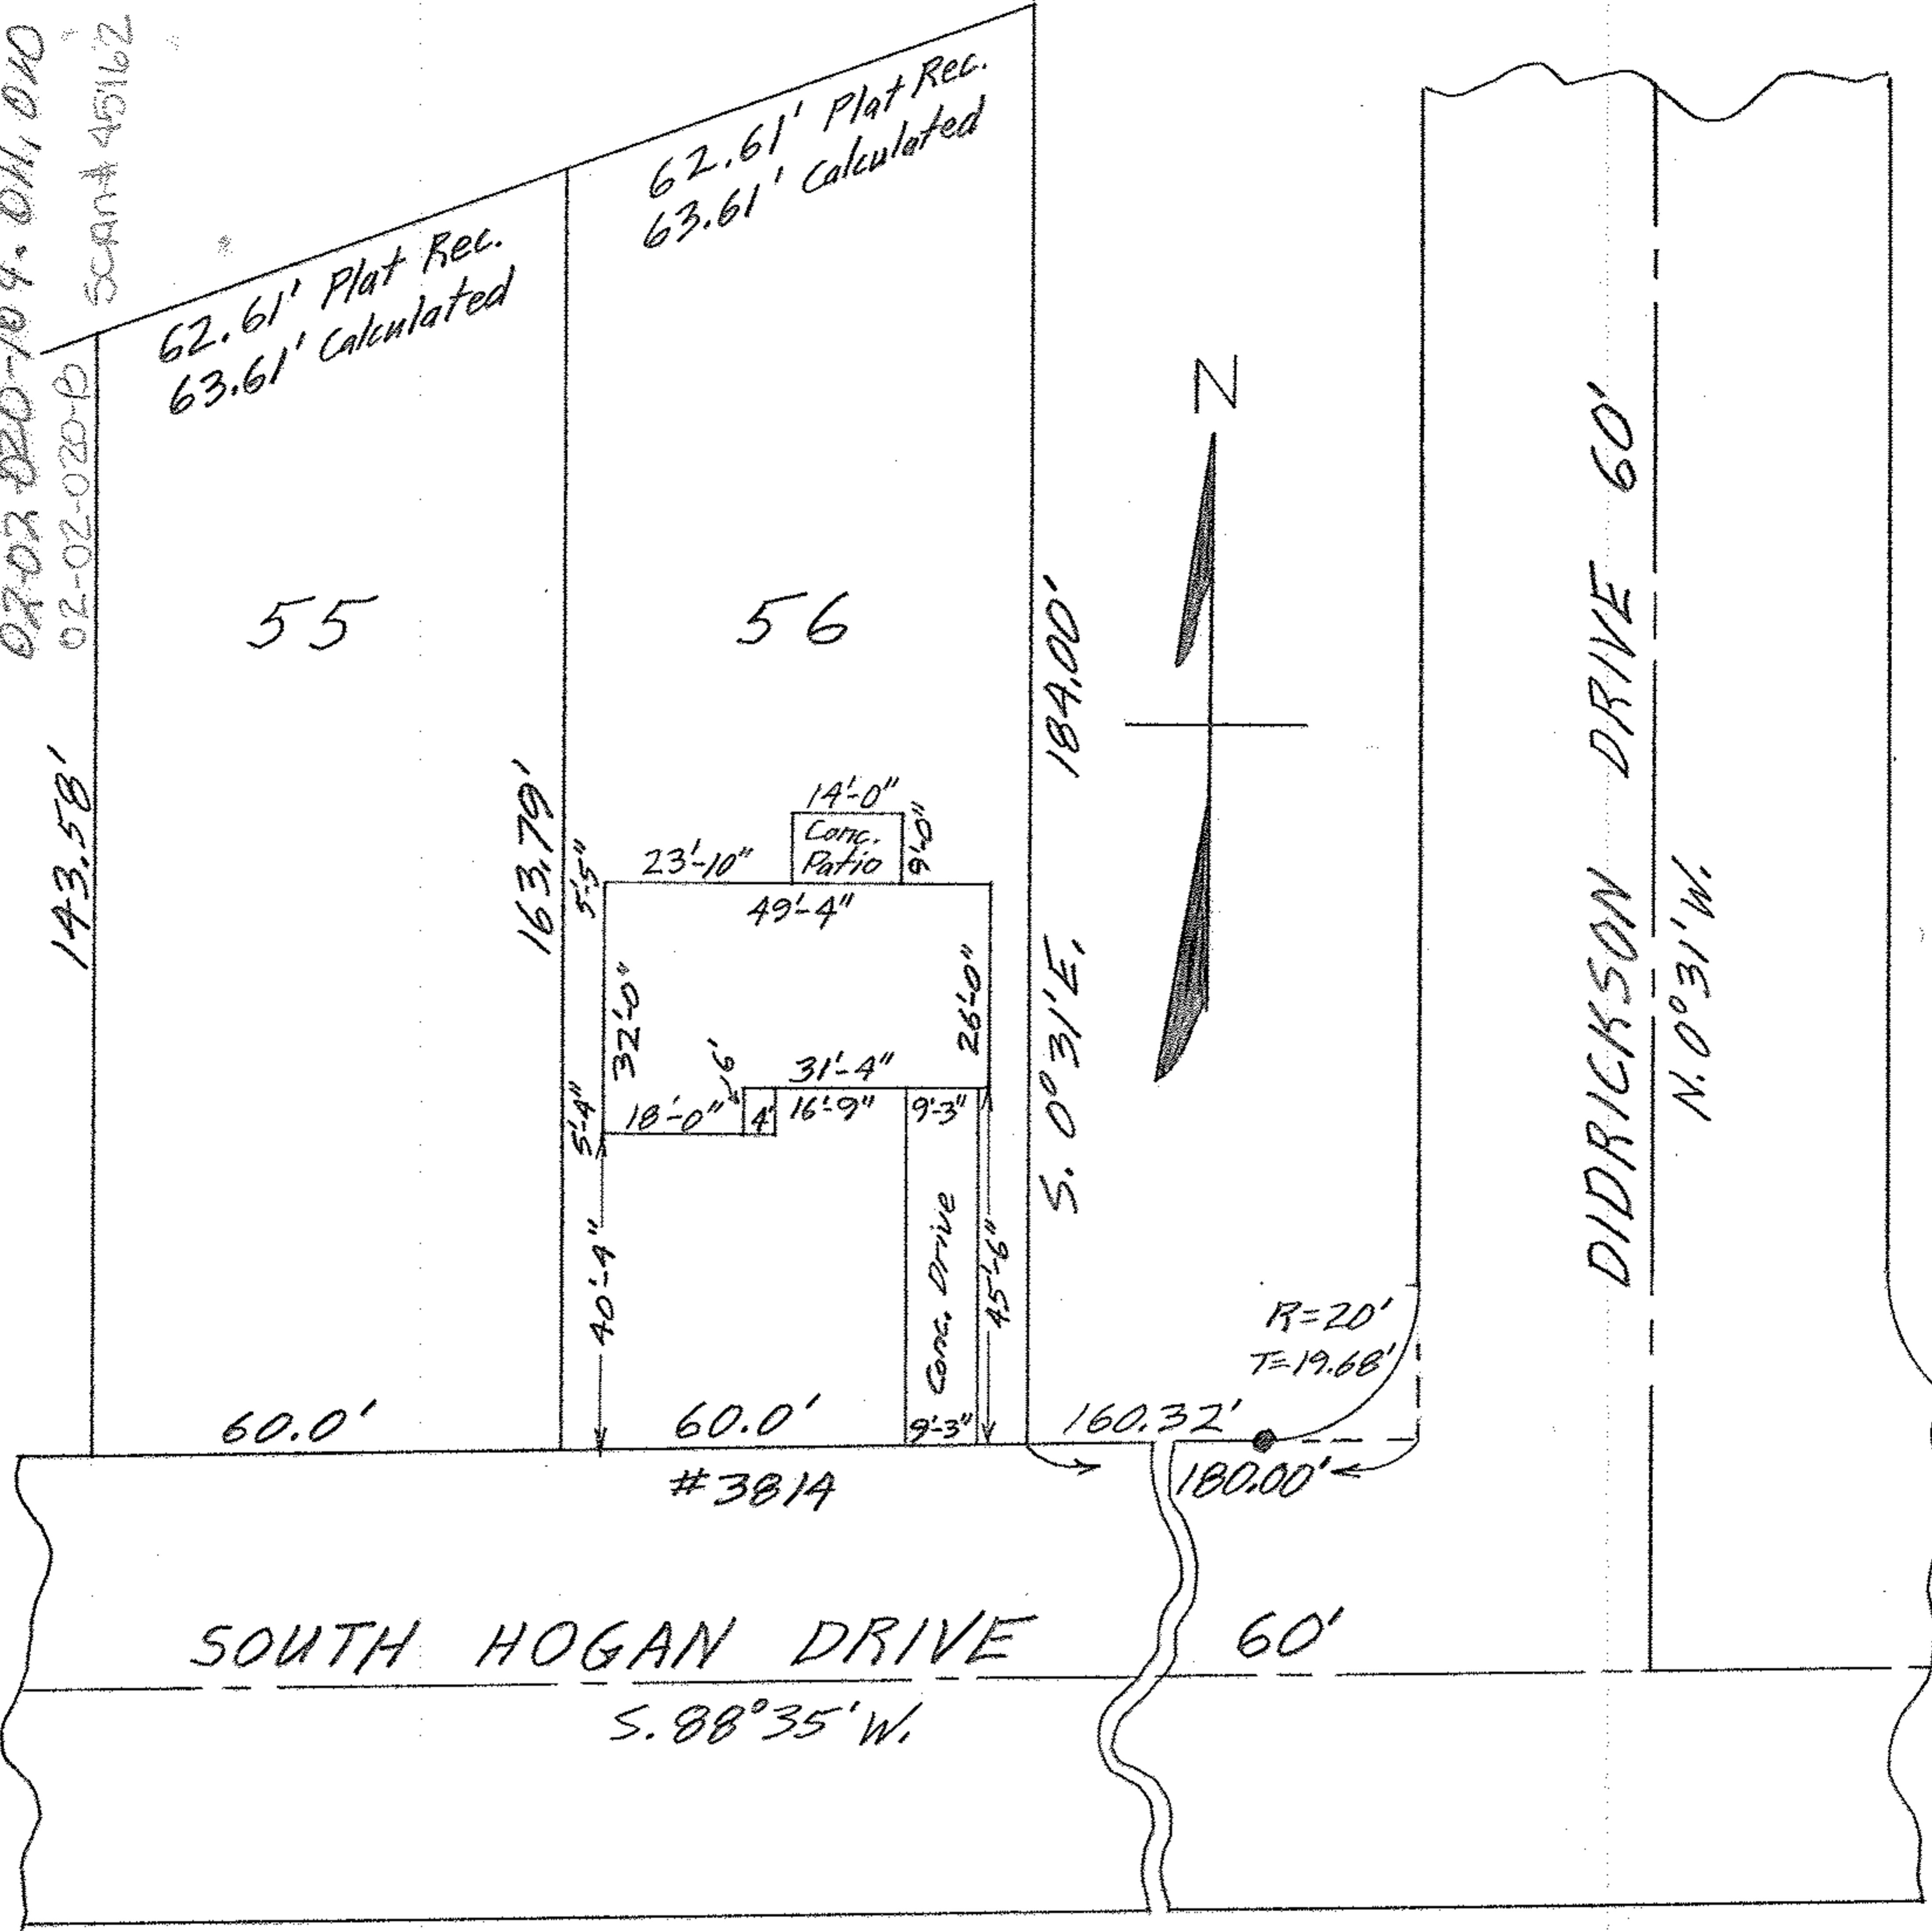

MAP OF SUB-LOT NO. 56

COUNTRY CLUB HOME SITES Vol. 21 Pg. 19 PLATS

O.L. No. 20 TRACT No. 2 BLACK RIVER TWP.

LORAIN CITY LORAIN COUNTY OHIO

SCALE: 1"=30' SEPTEMBER 4-1962 3:00 P.M.

Gary E. Penfound REG. SURVEYOR

Kenneth L. & Nancy L. Mason

BH
07-03-20