


02-02-020-104-013,014  
012

02-02-020-B  
SCAFF#45163 N

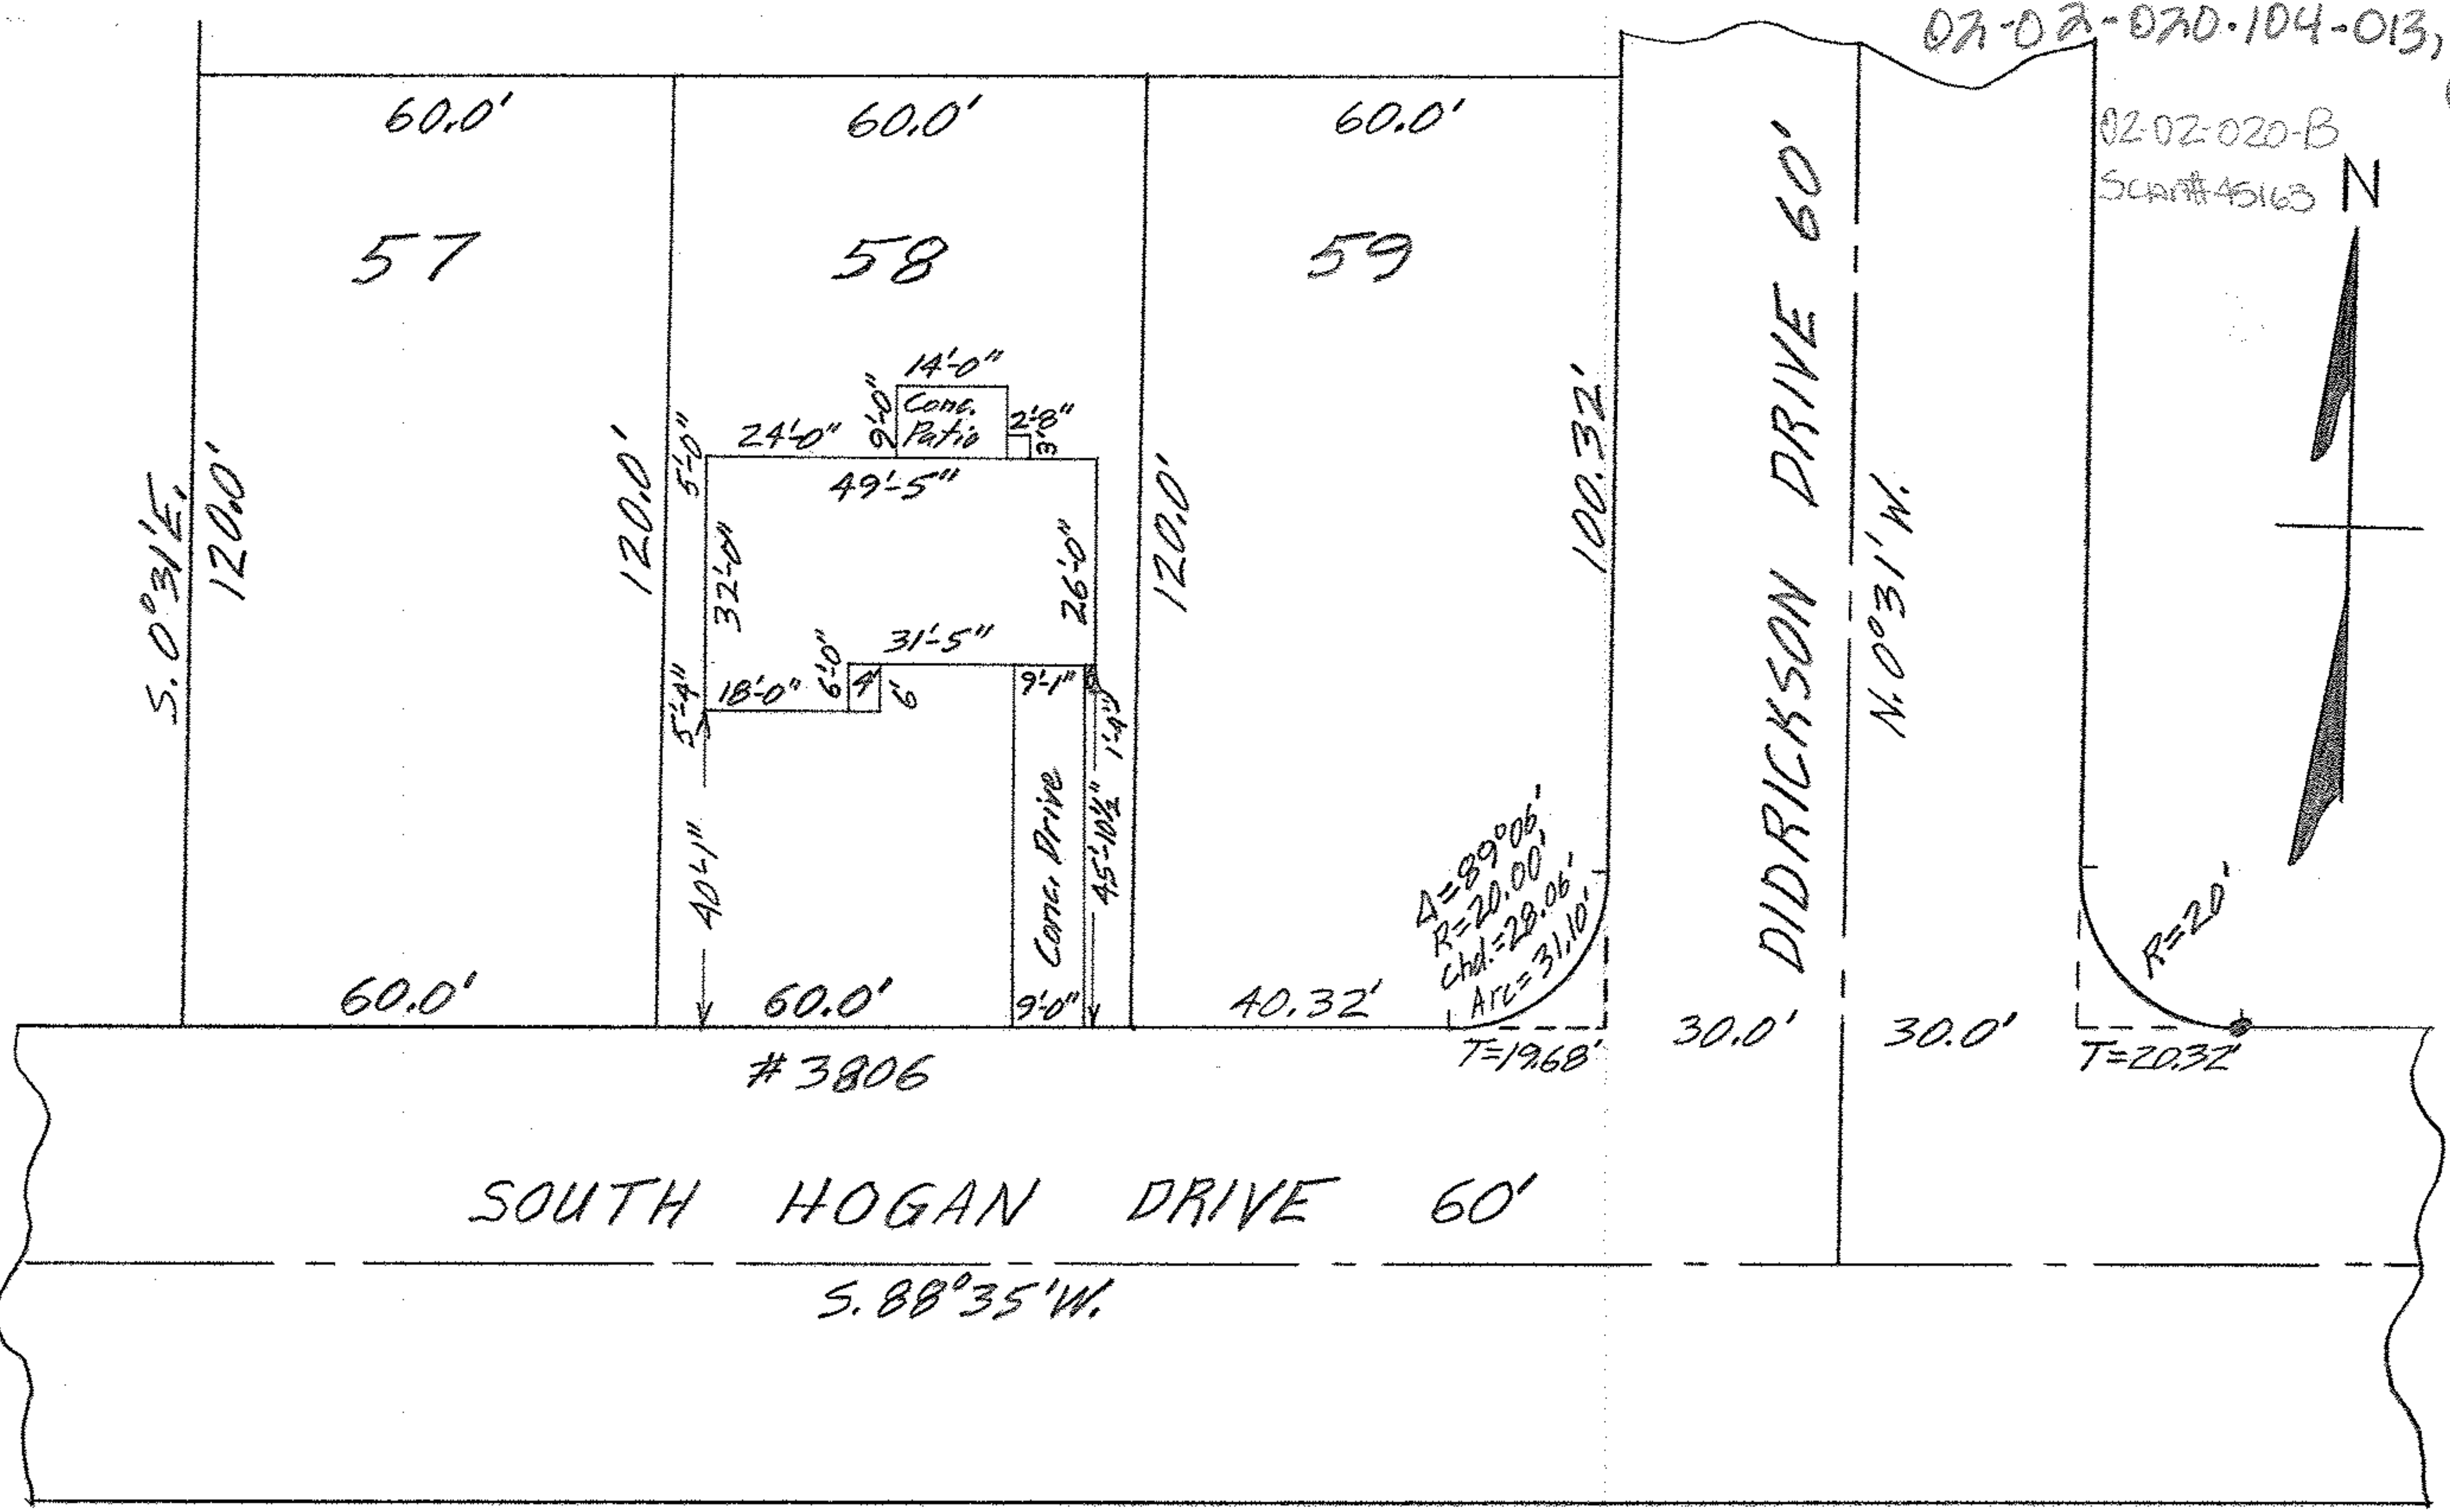

MAP OF SUB-LOT NO. 58

COUNTRY CLUB HOME SITES Vol. 21 Pg. 19 PLATS

O.L. 20 - TRACT No. 2 - BLACK RIVER TWP.

LORAIN CITY LORAIN COUNTY OHIO

SCALE: 1" = 30' OCT. 30-1962 11:45 A.M.

Gary E. Penfound REG. SURVEYOR

Donald B. & Charlene J. Plumb