


02-02-020-105-014, 013  
 02-02-020-8  
 SCAN # 45164

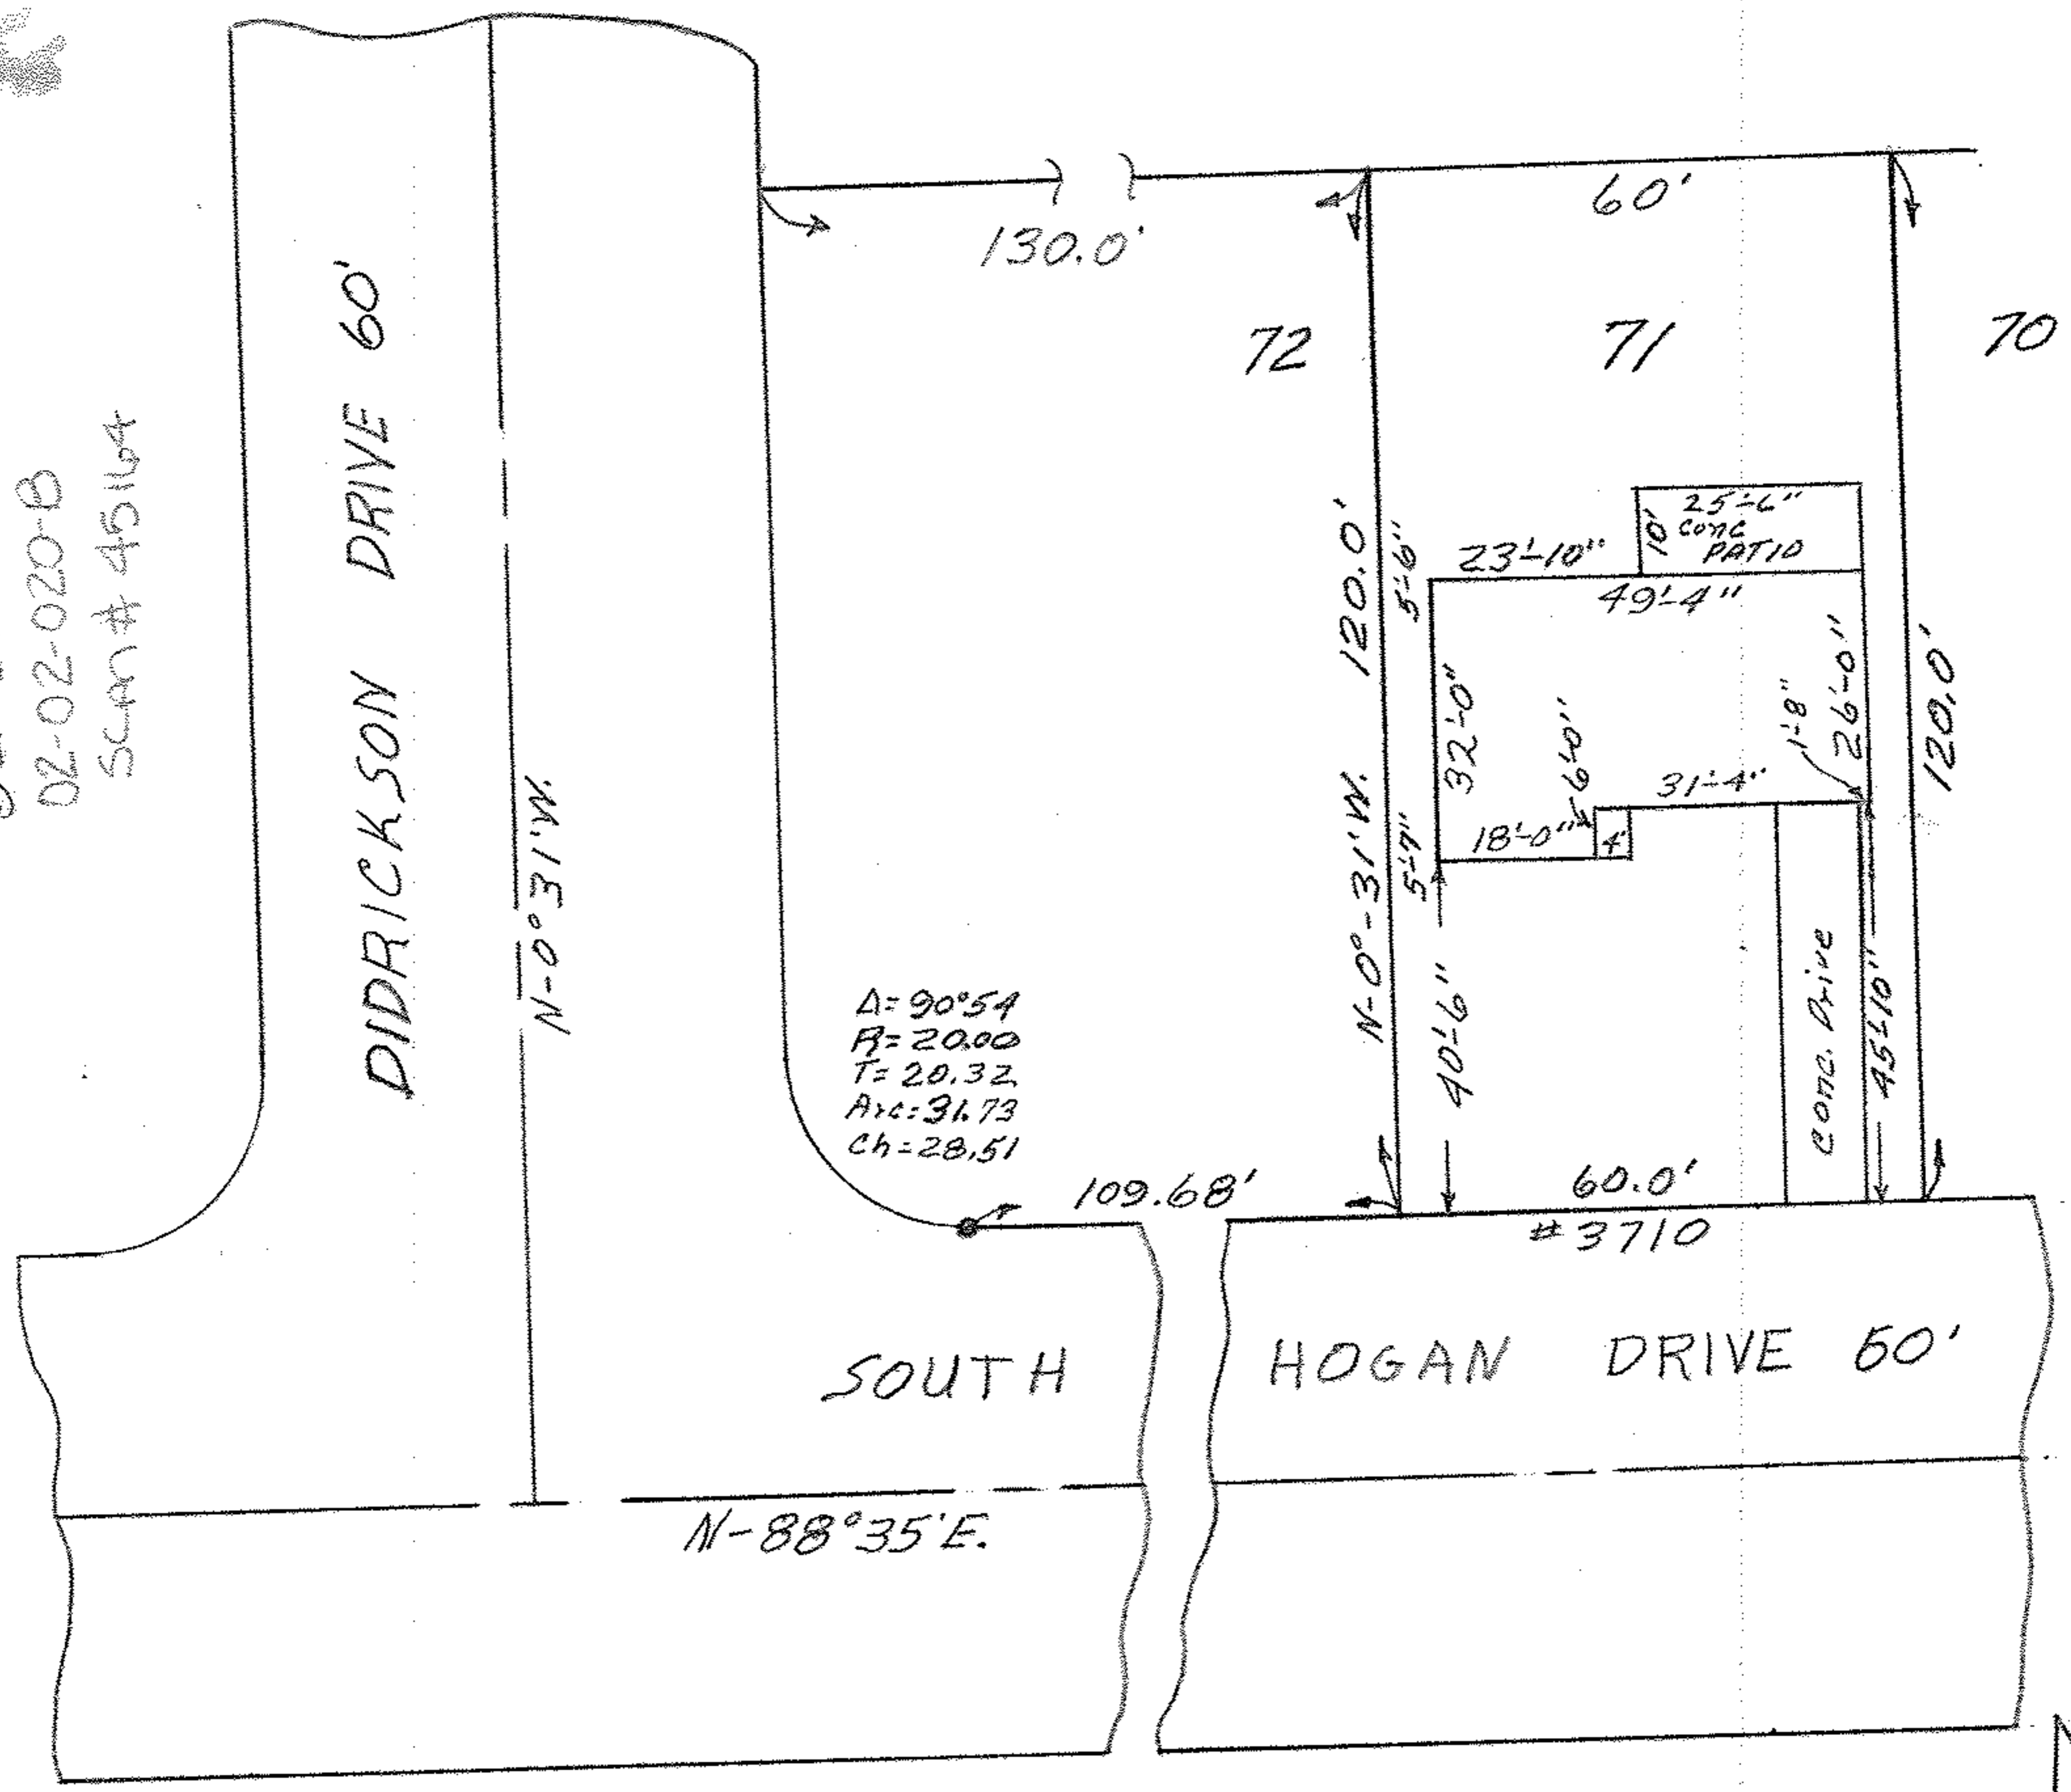

MAP OF SUB-LOT 71

COUNTRY CLUB HOME SITES Vol. 21 Pg. 19 PLATS

O.L. No. 20 TRACT No. 2 BLACK RIVER TWP.

LORAIN CITY LORAIN COUNTY OHIO

Scale: 1" = 30' OCTOBER 2-1962 10:30 A.M.

Gary E. Penfound Registered Surveyor

Gregory J. & Judith J. Rangel BH

02-02-020