


02-02-020-107-020

02-02-020-B
SCAN # 45166

102

101

100

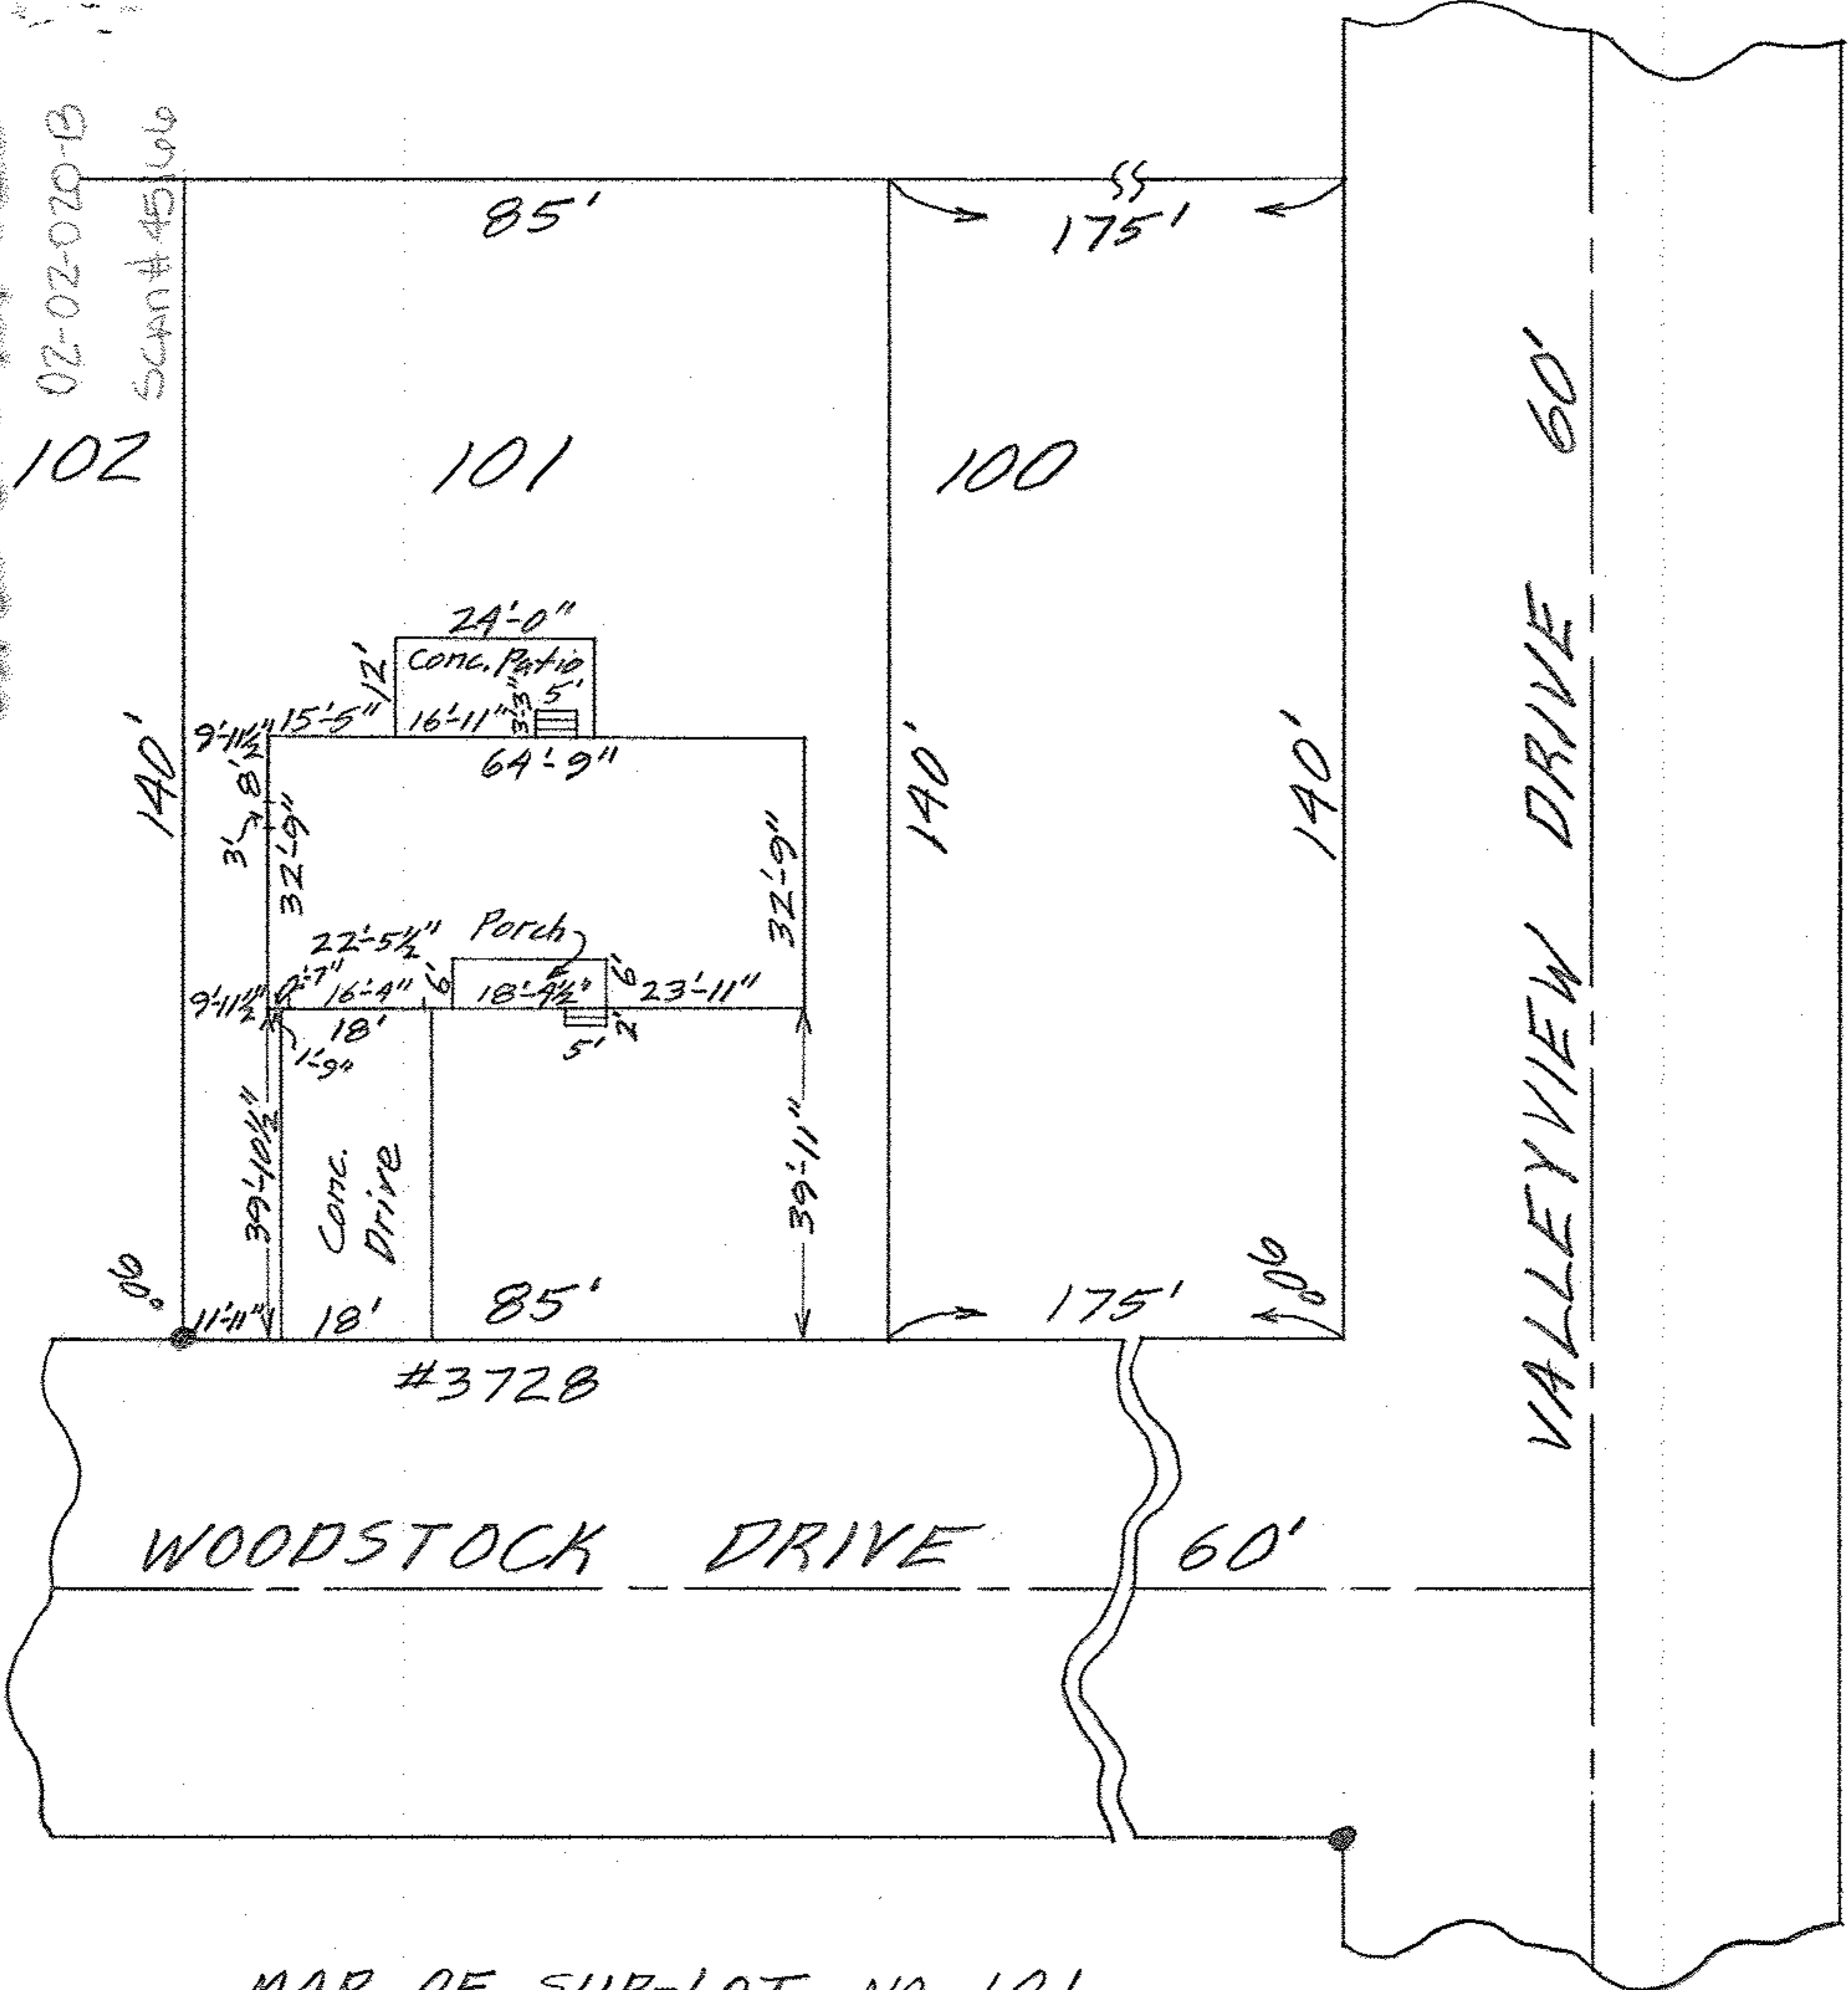

#3728

WOODSTOCK DRIVE 60'

VALLEYVIEW DRIVE 60'

MAP OF SUB-LOT NO. 101

SHERWOOD ALL'T, NO. 2 Vol. 21 Pg. A PLATS

O.L.'s 20 & 21 - TRACT 2 - BLACK RIVER TWP.

LORAIN CITY - LORAIN COUNTY - OHIO

SCALE: 1" = 30' OCT. 23 - 1963 5:00 P.M.

Gary E. Penfound REG. SURVEYOR

John W. & Helen Kosakowski - Parcel No. 2 BH

02-02-020