


02-02-020-109-007, 008
 02-02-020-020-B
 SCAM # 45168

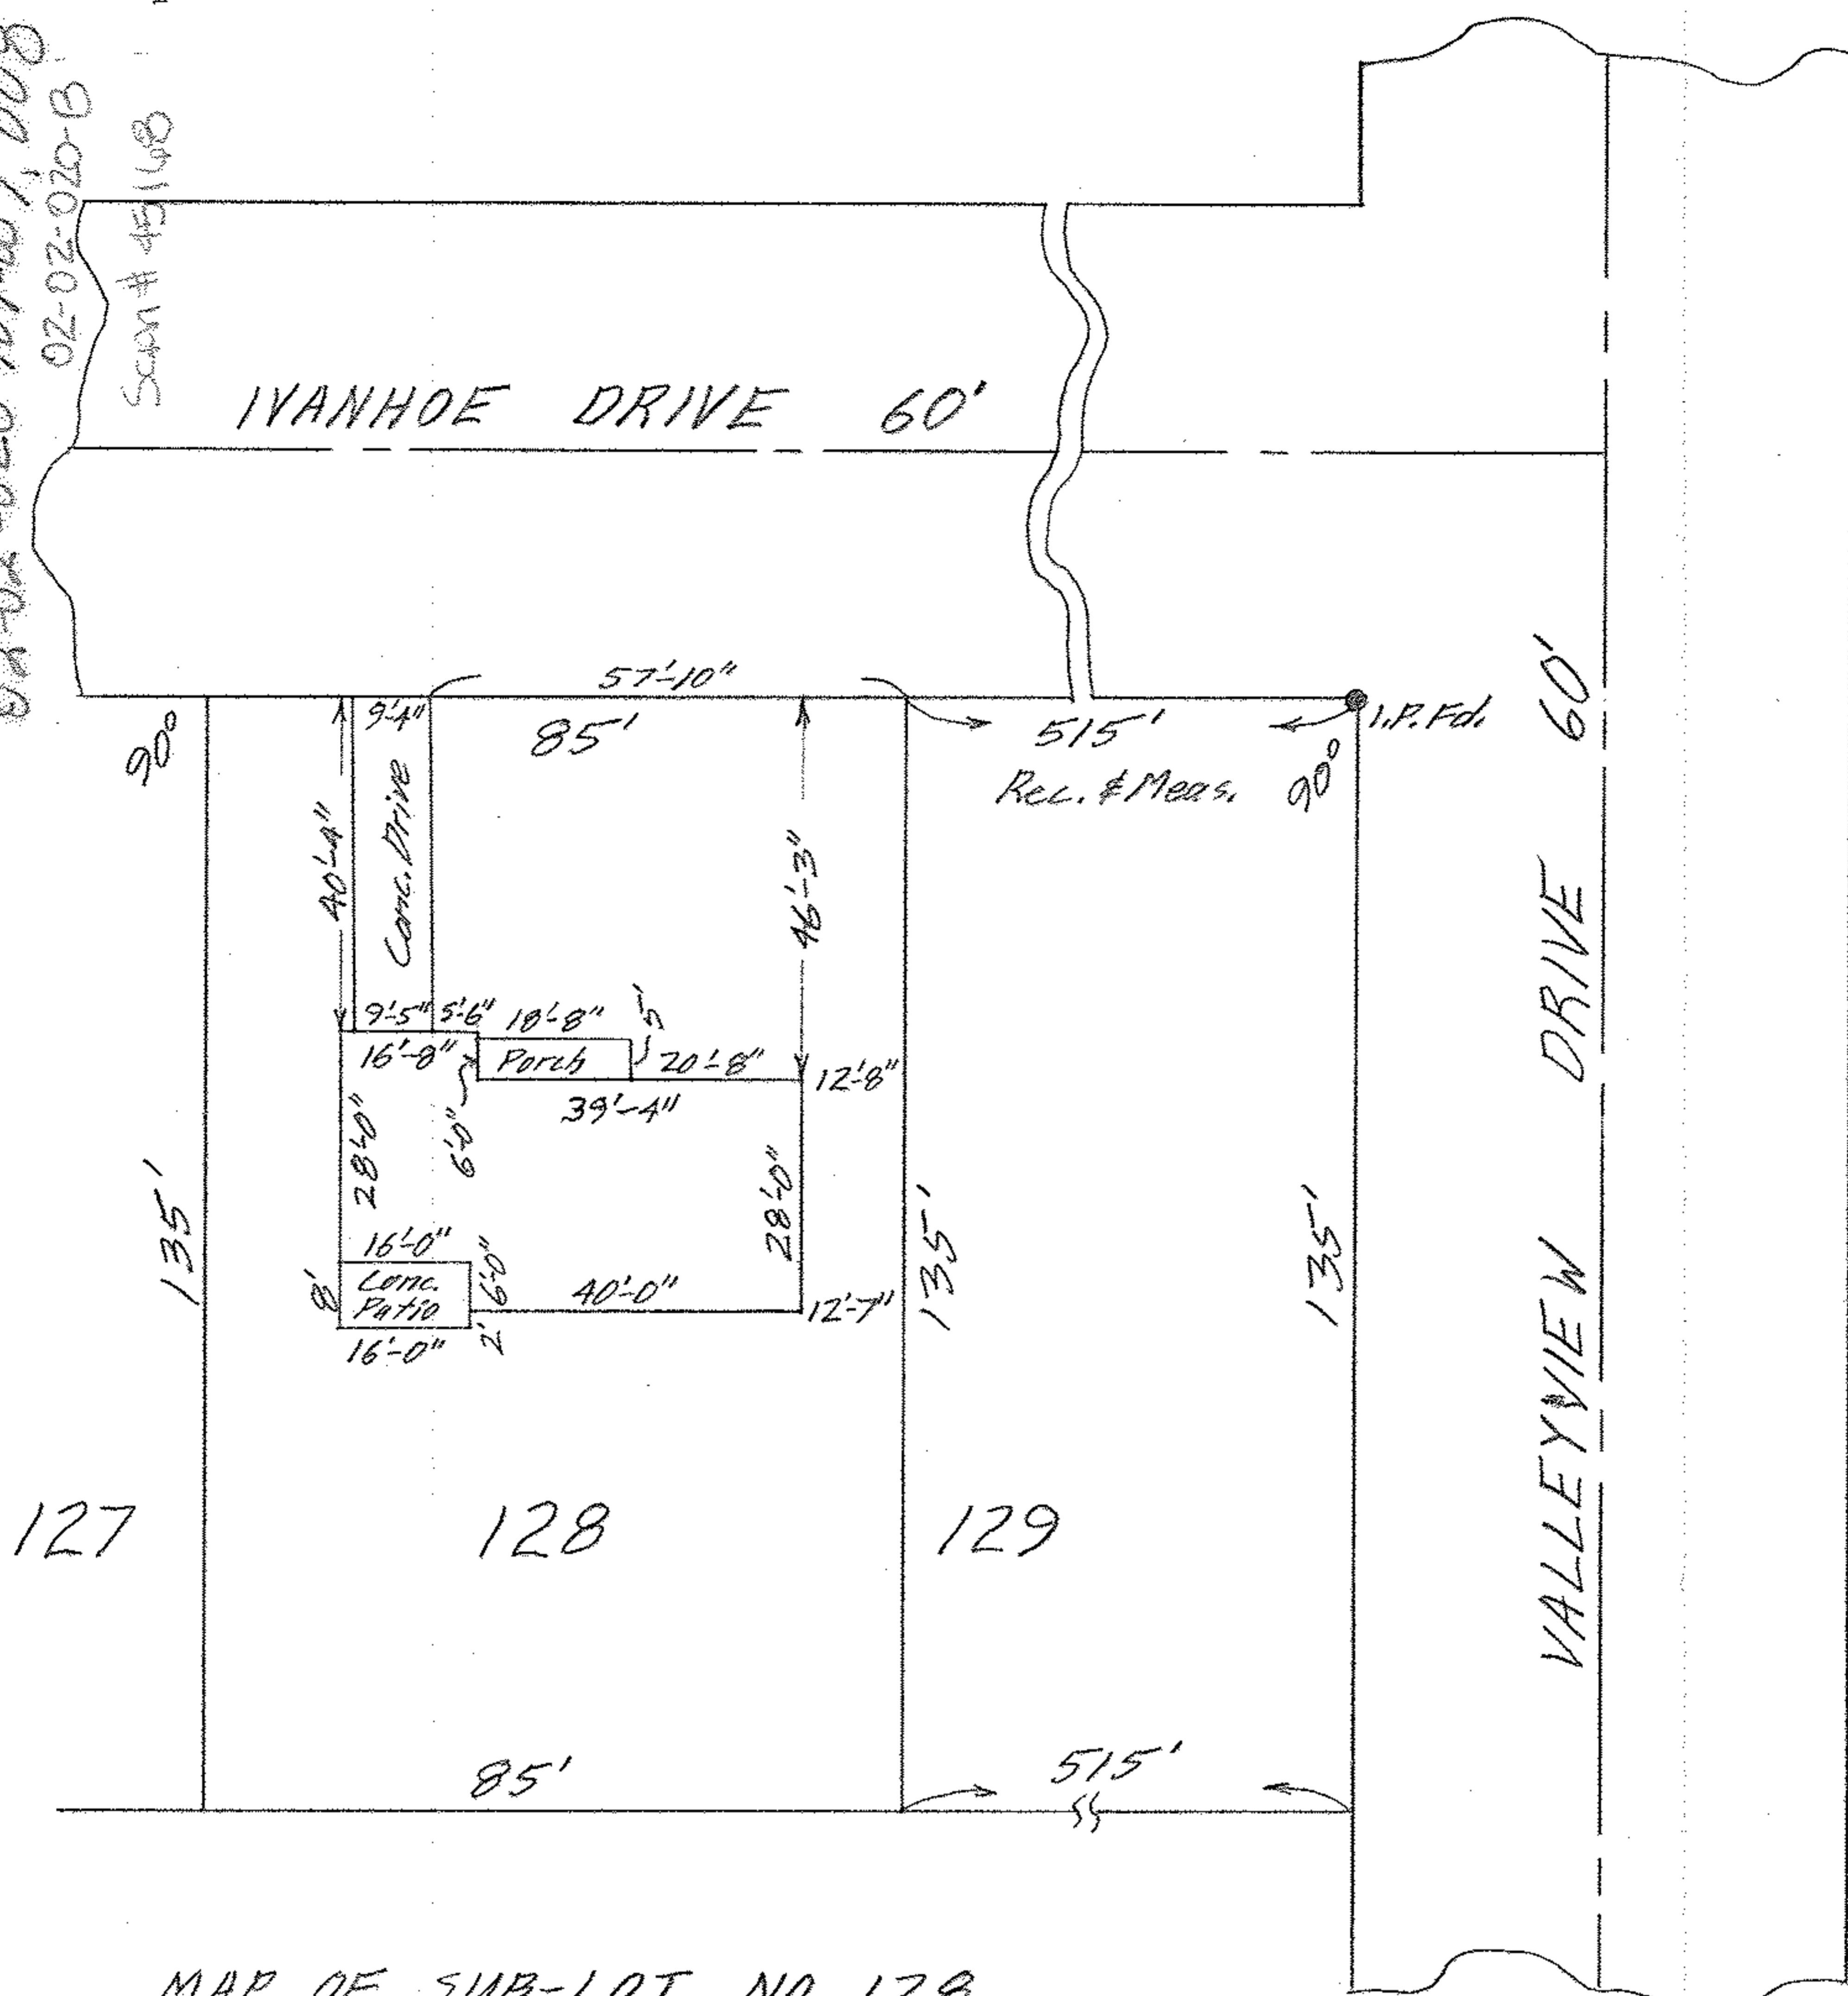

MAP OF SUB-LOT NO. 128

SHERWOOD ALLOTMENT NO. 2 VOL. 21 Pg. 4 PLATS
 ORIG. LOT 20 - TRACT 2 - BLACK RIVER TWP.
 LORAIN CITY LORAIN COUNTY OHIO

SCALE: 1" = 30' AUG. 9 - 1962 2:00 P.M.

Gary E. Penfound REG. SURVEYOR

Clarence E. & Elaine M. Squires WW