


02-02-021-106-003,012
 02-02-021-A
 SCAN # 45170

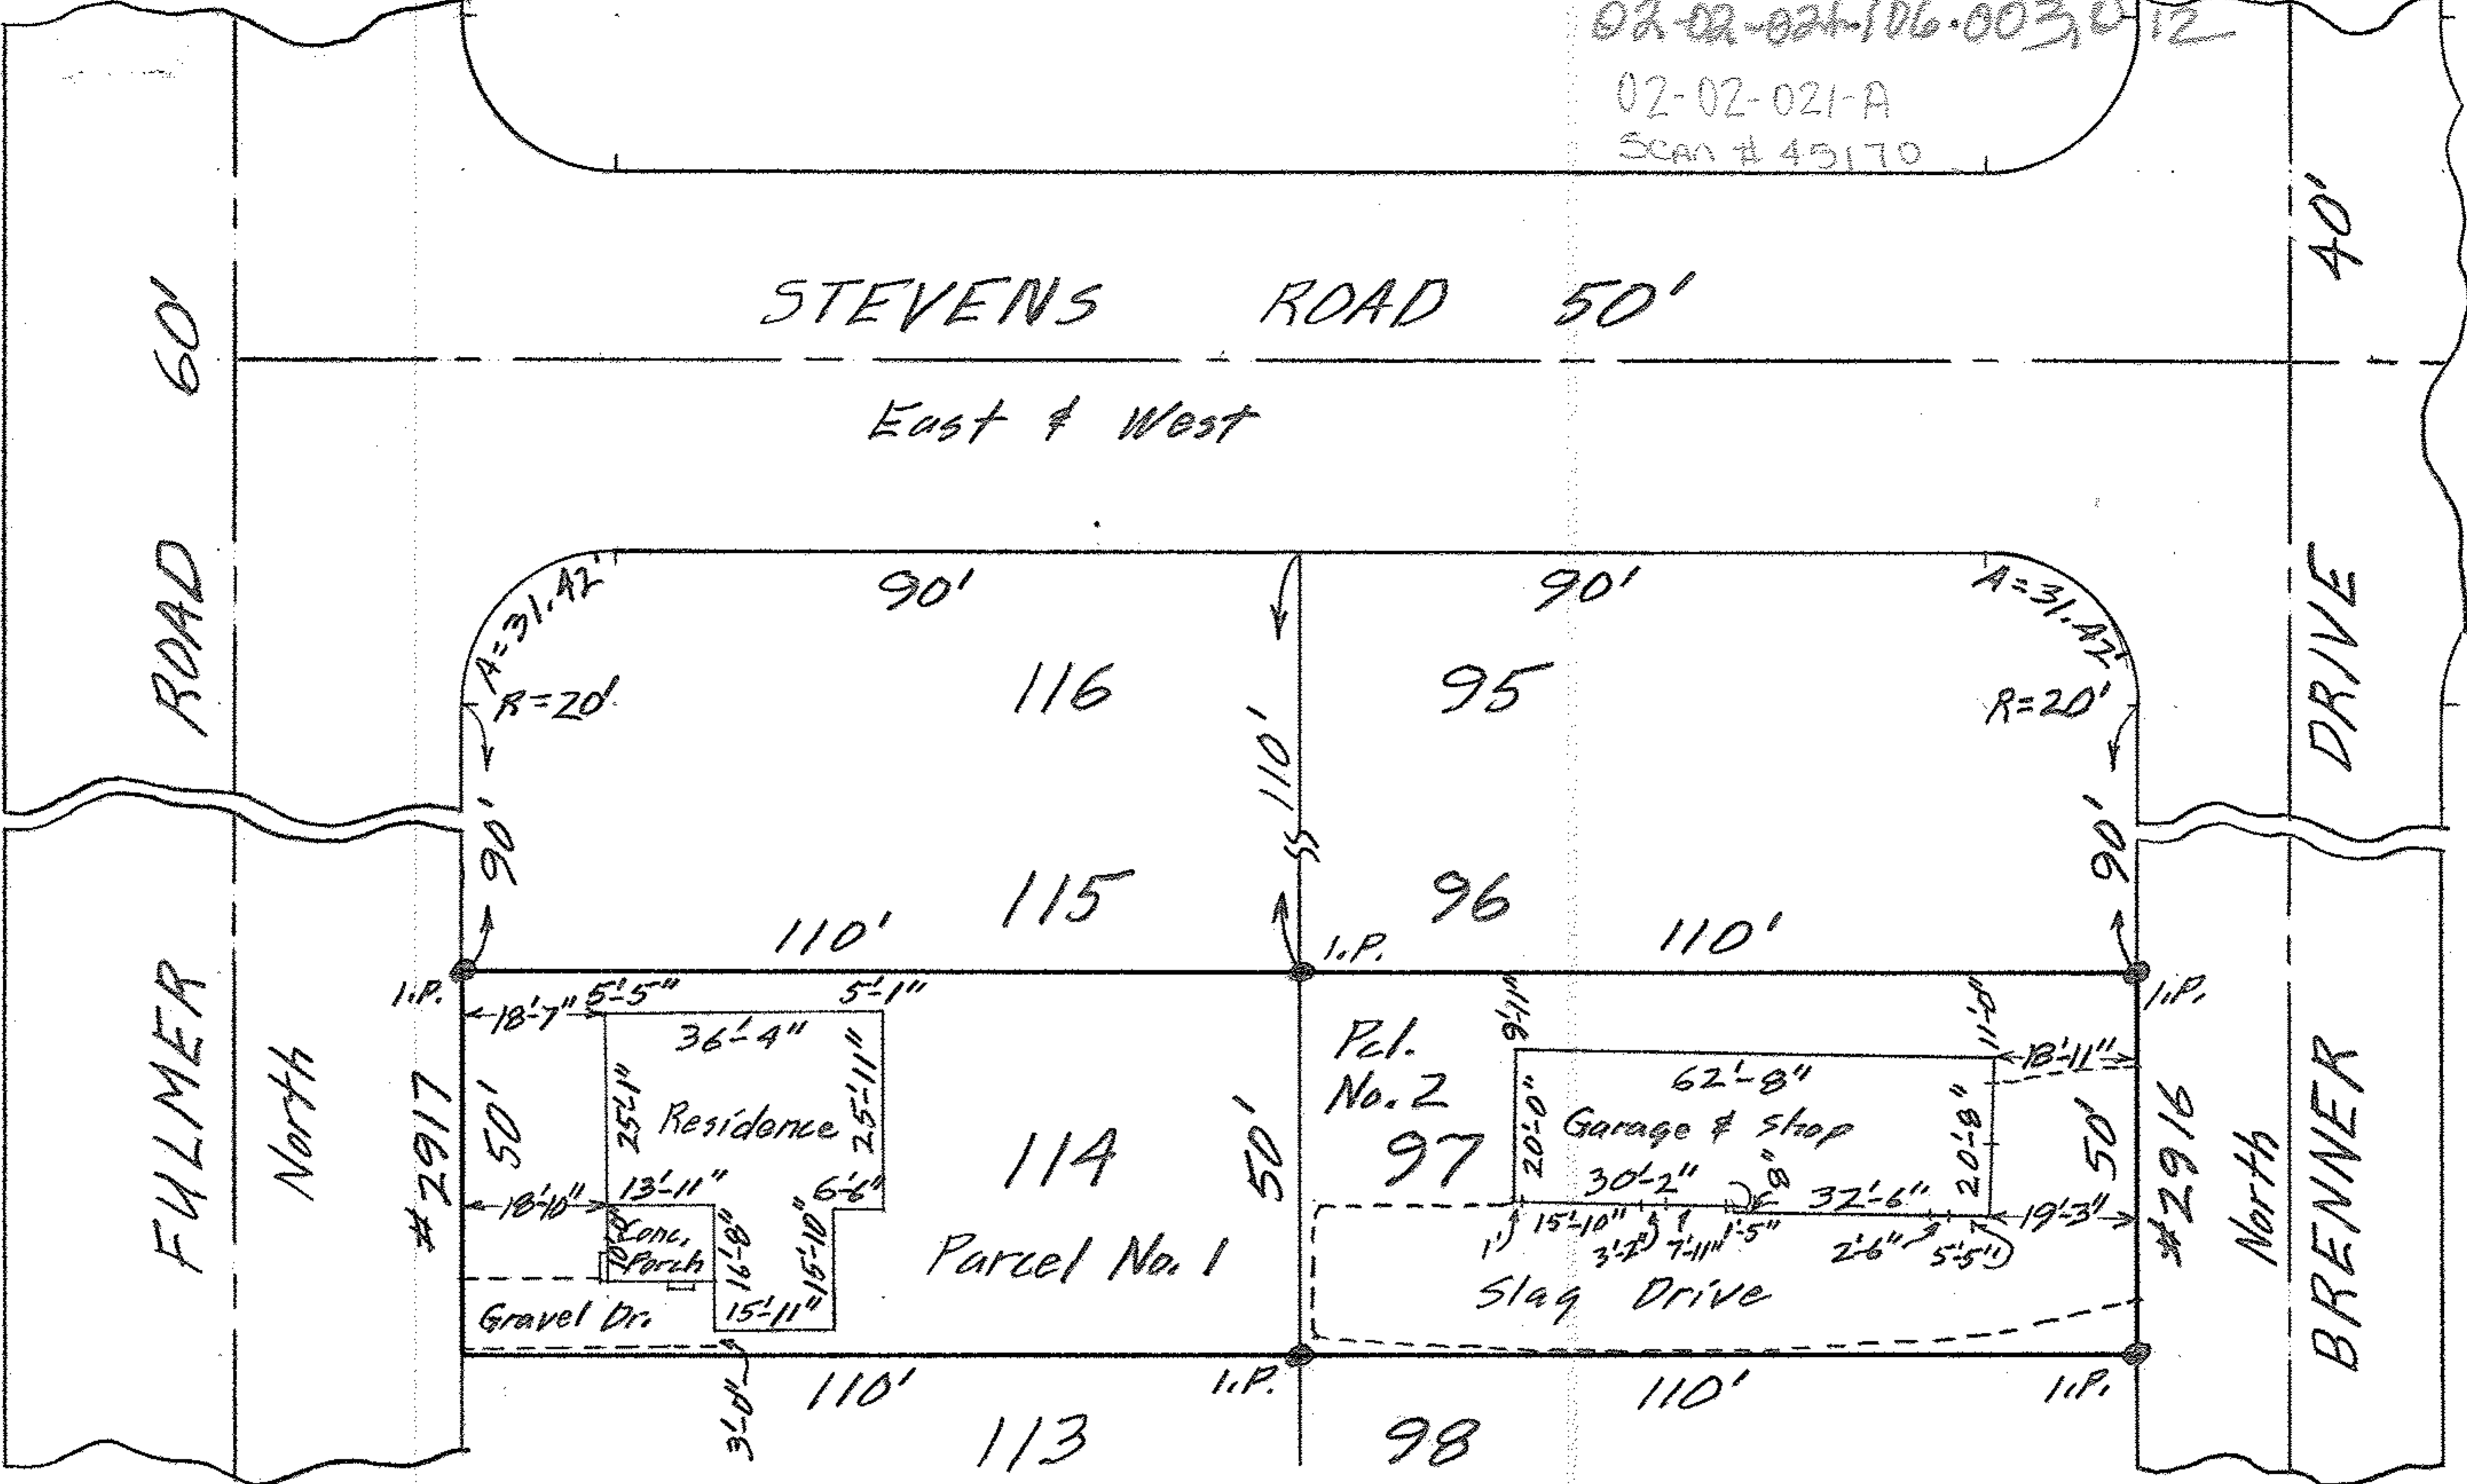

MAP OF SUB-LOTS NOS. 114 & 97
 GRAND VIEW REALTY CO.'S SUB'N. VOL. 11 Pgs. 2 & 3
 ORIG. LOT 21 - TRACT 2 - BLACK RIVER TWP.
 LORAIN COUNTY OHIO

SCALE: 1" = 30' NOV. 20-1965 4:30 P.M.
 Gary E. Perford REG. SURVEYOR

