


PA. 02-02-115-006

02-02-021-B
SCAN # 45172

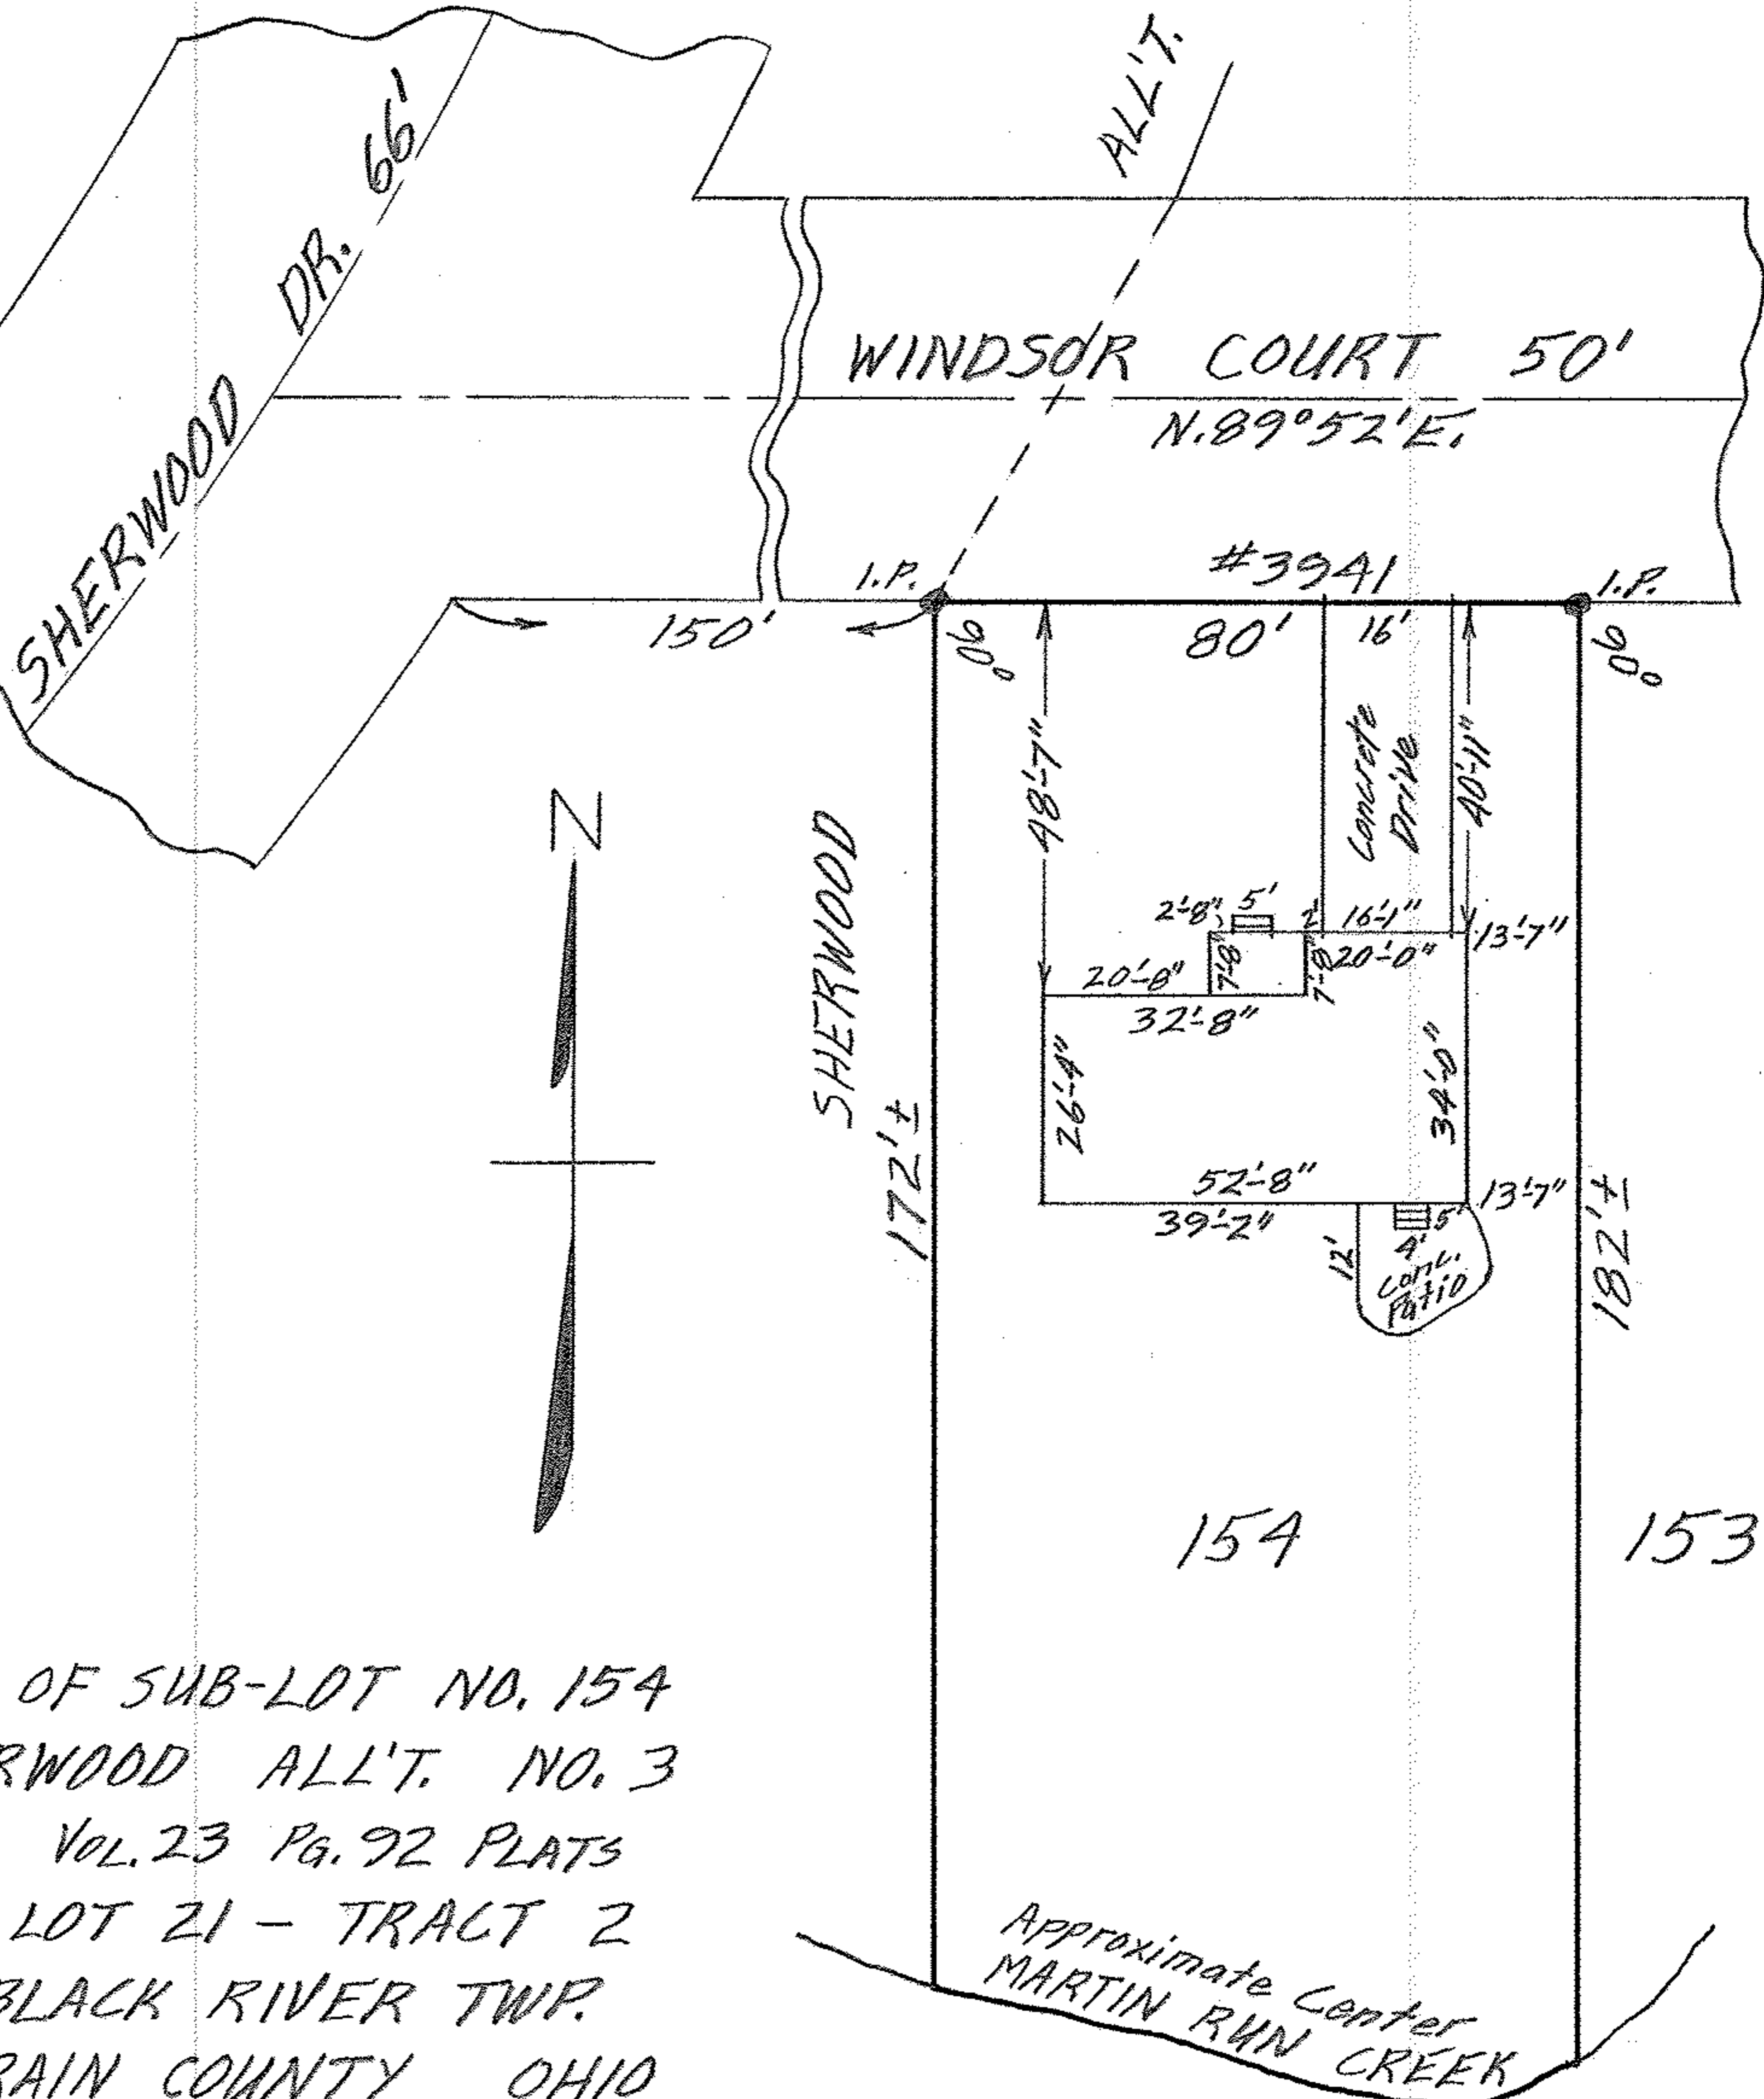

MAP OF SUB-LOT NO. 154
 SHERWOOD ALL'T. NO. 3
 VOL. 23 Pg. 92 PLATS
 ORIG. LOT 21 - TRACT 2
 BLACK RIVER TWP.
 LORAIN COUNTY OHIO

SCALE: 1" = 30' JUNE 18-1965 6:15 P.M.
 Gary E. Penfound REG. SURVEYOR

Bernard & Dolores Busser