


02-02-023-105-032
 02-02-023-A
 SCAN# 45174

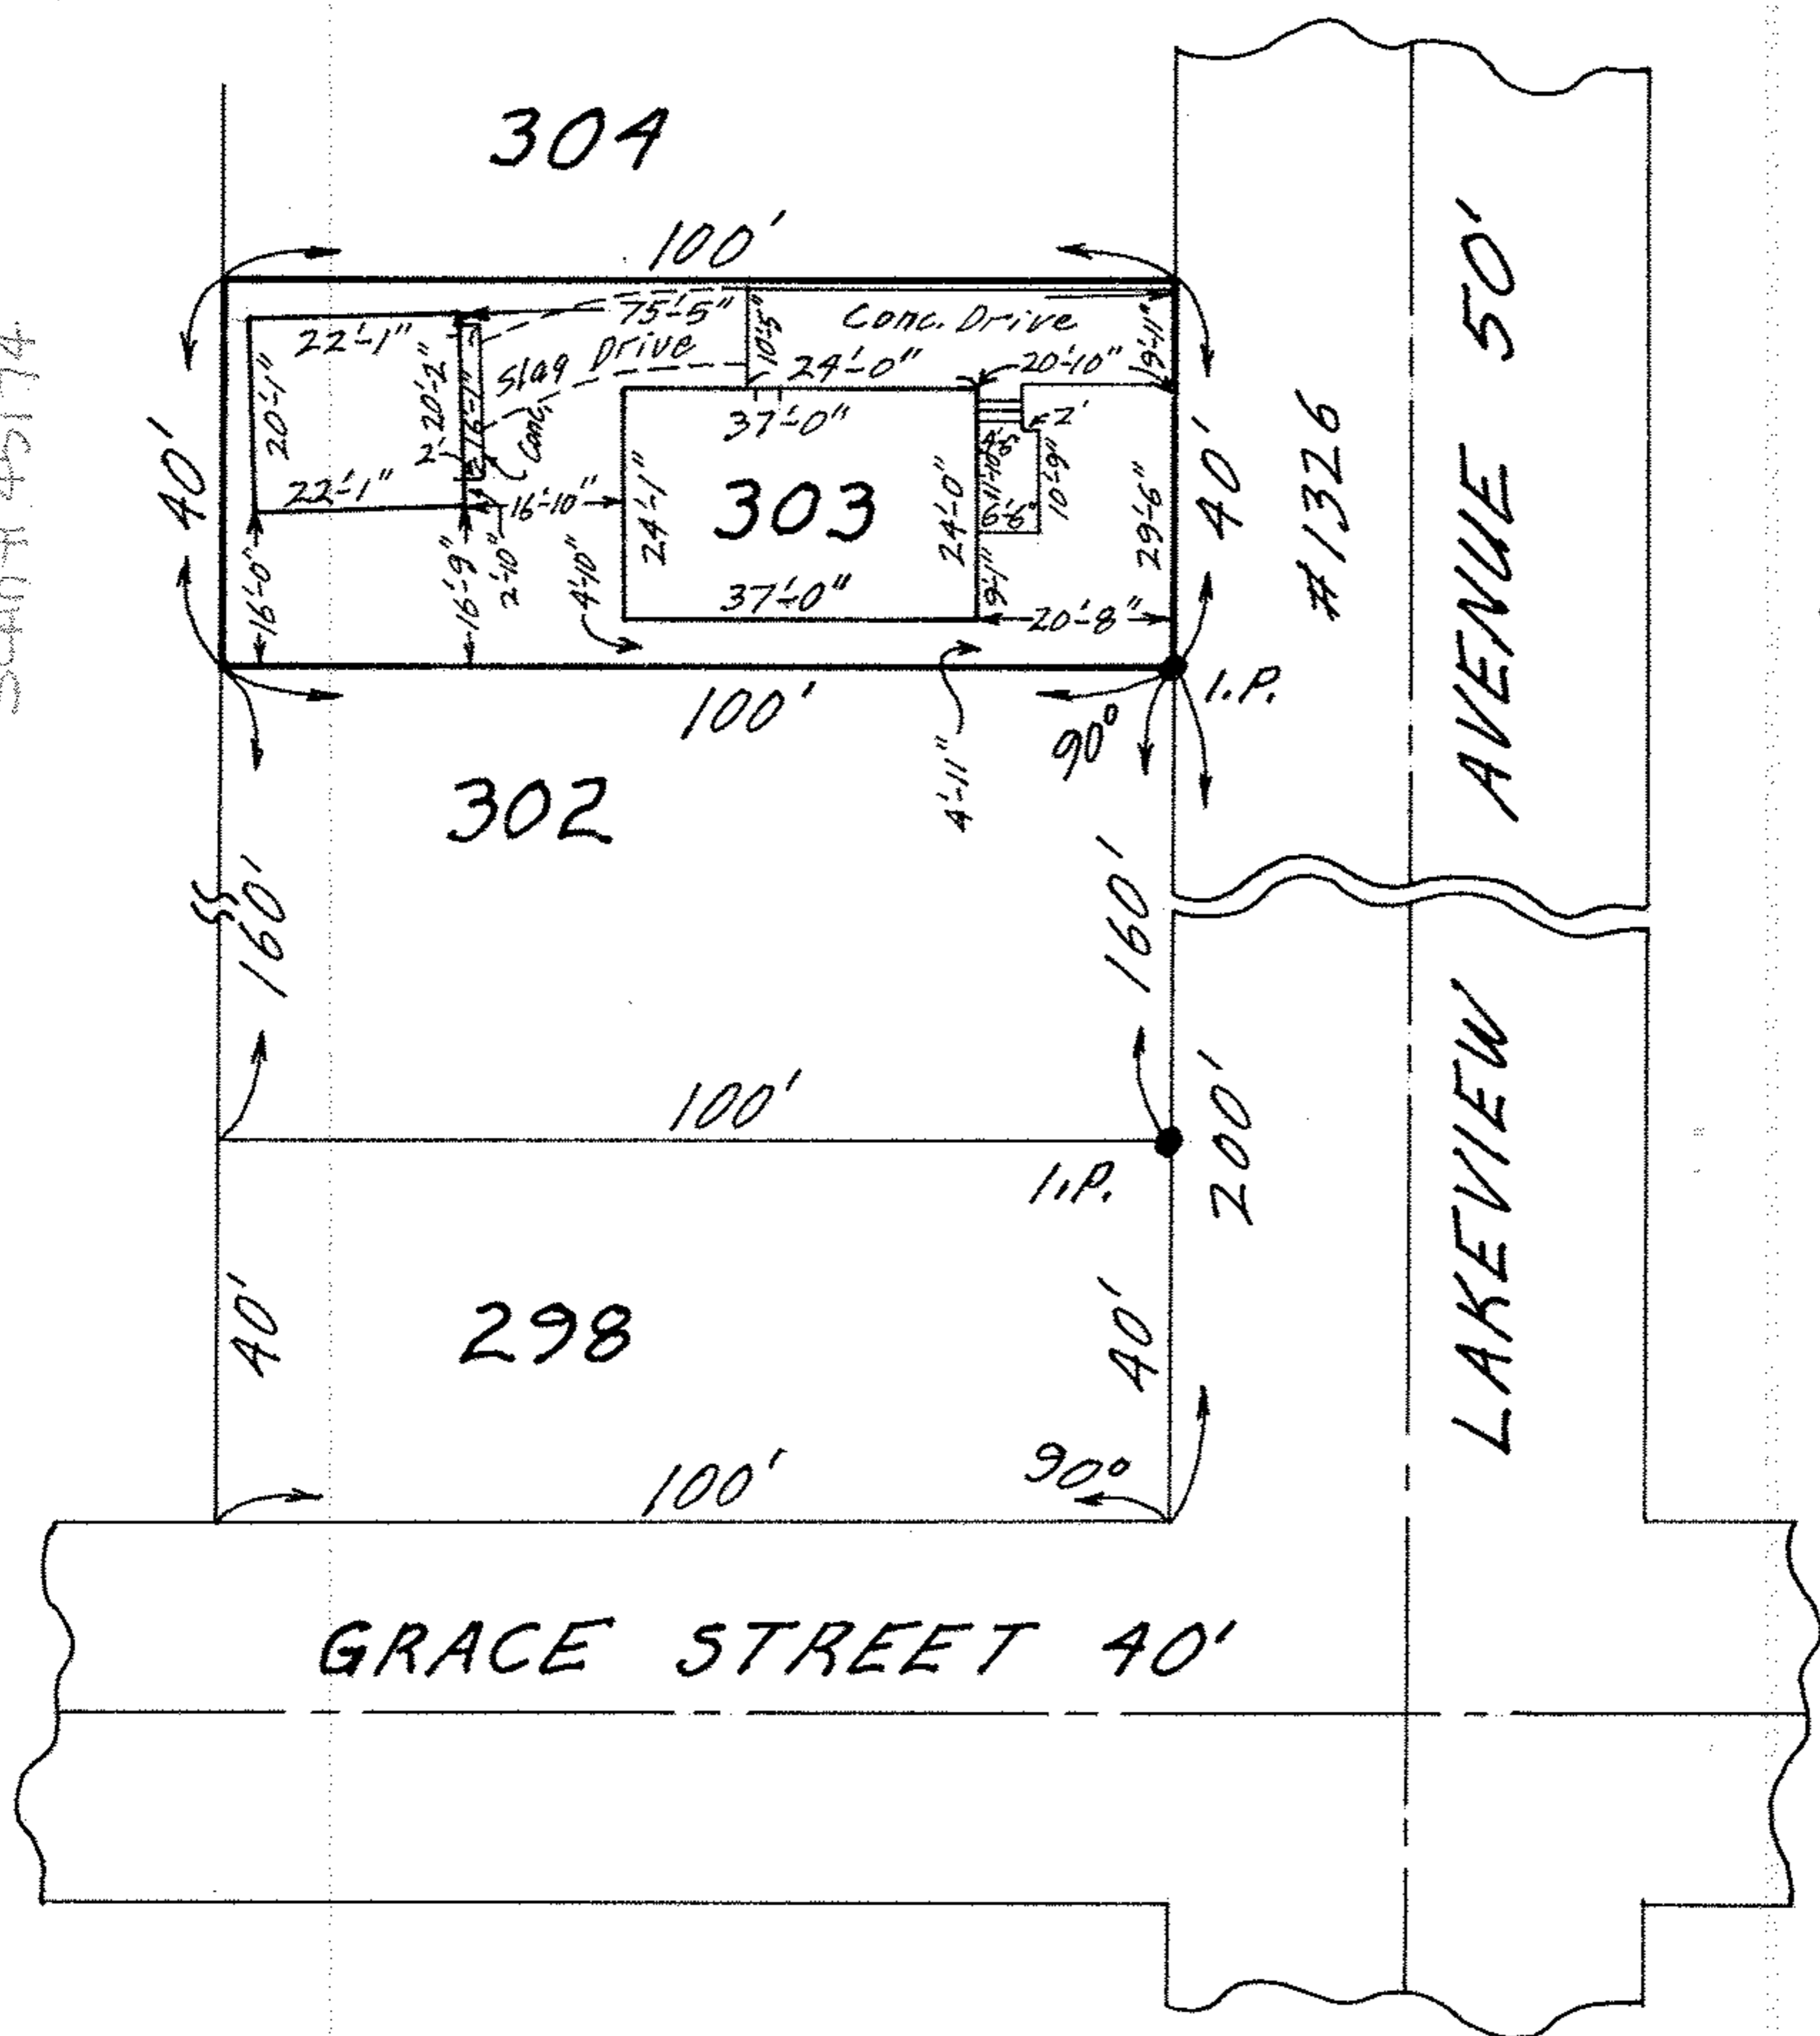

MAP OF SUB-LOT NO. 303

LAKE VIEW ALL'T. VOL. 6 PGS. 9 & 10
 ORIG. LOT 23 - TRACT 2 - BLACK RIVER TWP.
 LORAIN CITY - LORAIN COUNTY - OHIO
 SCALE: 1" = 30' APRIL 7-1970 5:00 P.M.

NOTE: There are no encroachments on this property.

Gary E. Penfound REG. SURVEYOR NO. 4457

CITY TITLE CO. Order No. E-1072-3

Dennis & Linda Hall to
 Gene W. & Darliene K. Davidson